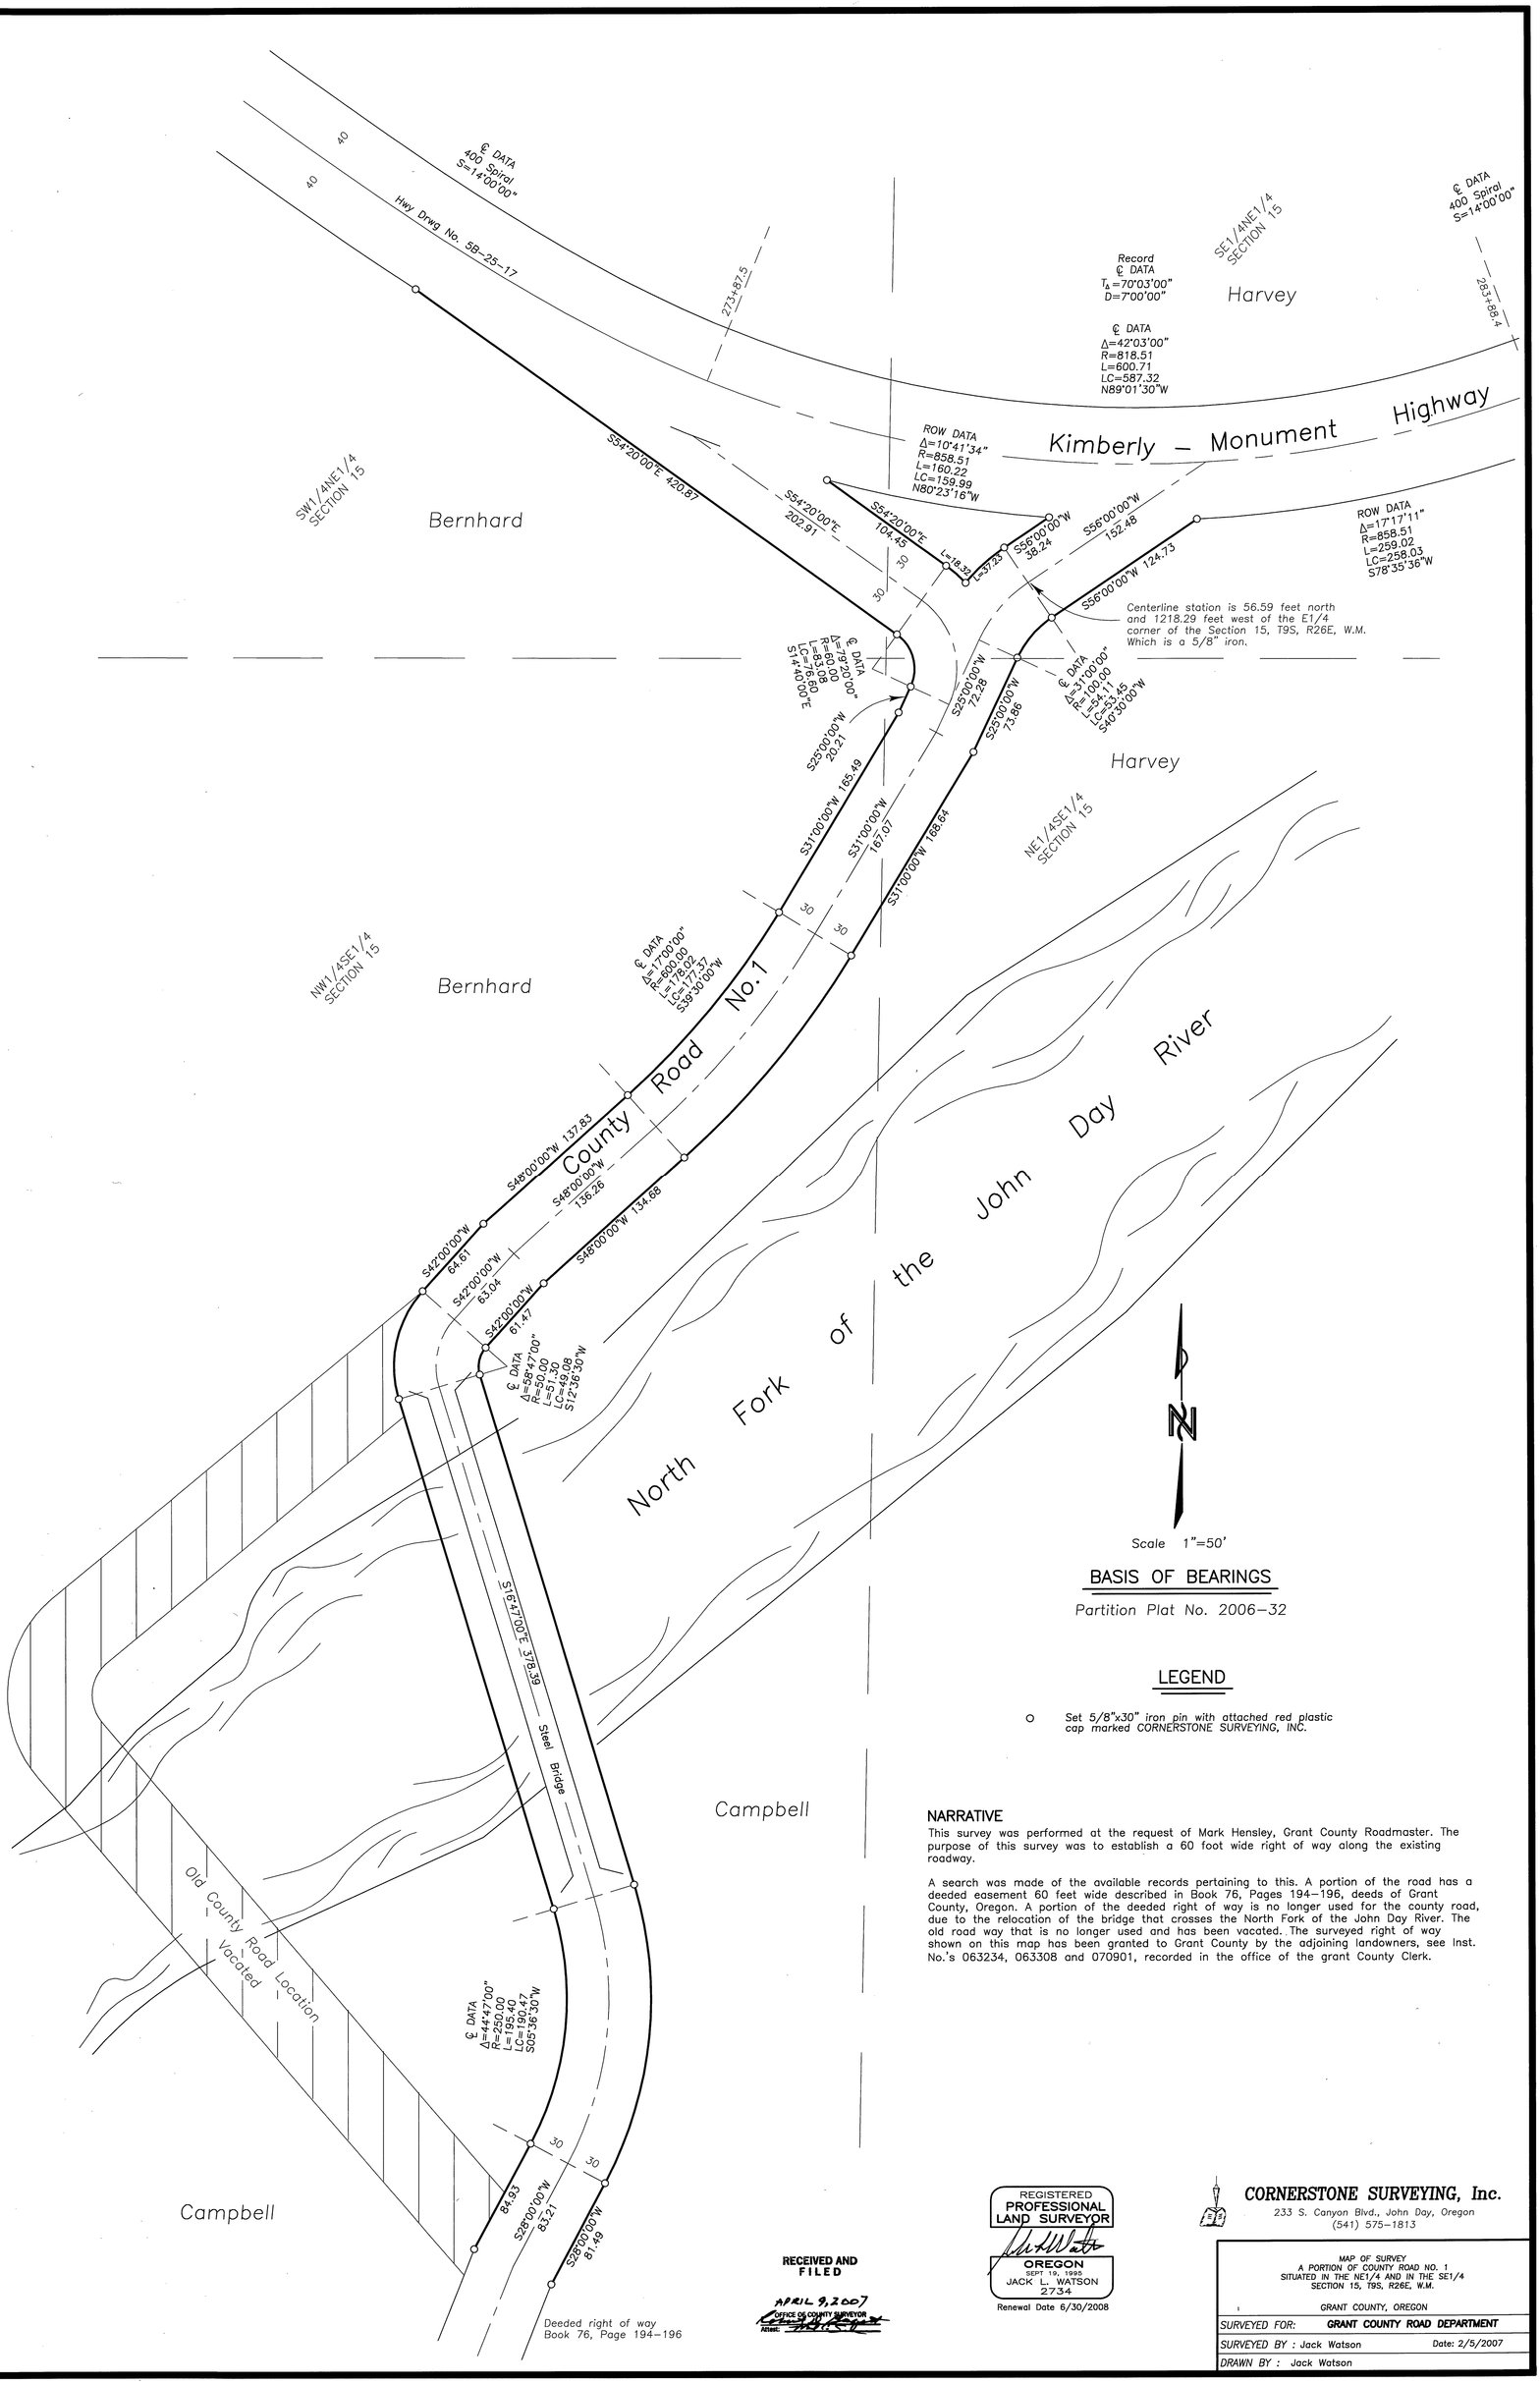

NARRATIVE

This survey was performed at the request of Mark Hensley, Grant County Roadmaster. The purpose of this survey was to establish a 60 foot wide right of way along the existing roadway.

A search was made of the available records pertaining to this. A portion of the road has a deeded easement 60 feet wide described in Book 76, Pages 194–196, deeds of Grant County, Oregon. A portion of the deeded right of way is no longer used for the county road, due to the relocation of the bridge that crosses the North Fork of the John Day River. The old road way that is no longer used and has been vacated. The surveyed right of way shown on this map has been granted to Grant County by the adjoining landowners, see Inst. No.'s 063234, 063308 and 070901, recorded in the office of the grant County Clerk.

RECEIVED AND FILED

APRIL 9, 2007

OFFICE OF COUNTY SURVEYOR

REGISTERED PROFESSIONAL LAND SURVEYOR

OREGON
SEPT 19, 1995
JACK L. WATSON
2734

Renewal Date 6/30/2008

CORNERSTONE SURVEYING, Inc.
233 S. Canyon Blvd., John Day, Oregon
(541) 575-1813

MAP OF SURVEY
A PORTION OF COUNTY ROAD NO. 1
SITUATED IN THE NE1/4 AND IN THE SE1/4
SECTION 15, T9S, R26E, W.M.

GRANT COUNTY, OREGON

SURVEYED FOR:	GRANT COUNTY ROAD DEPARTMENT
SURVEYED BY : Jack Watson	Date: 2/5/2007
DRAWN BY : Jack Watson	

MAP OF SURVEY NO. 1796