


NARRATIVE

THIS SURVEY WAS PERFORMED AT THE REQUEST OF PETE RAWLINS. THE PURPOSE OF THIS SURVEY WAS TO LOCATE AND MONUMENT THE PROPOSED PROPERTY LINE ADJUSTMENT BETWEEN PARCEL 1 OF LAND PARTITION PLAT NO. 2005-04 AS SHOWN HEREON.

A SEARCH WAS MADE OF THE AVAILABLE RECORDS PERTAINING TO THIS SURVEY. I MADE FIELD MEASUREMENTS TO LOCATE APPURTENANT MONUMENTS SHOWN ON RECORD MAP OF SURVEY NO. 1021 AND RECORD LAND PARTITION PLAT NO. 2004—04, AS SHOWN HEREON.

I SET NEW MONUMENTS AT POSITIONS APPROVED BY PETE RAWLINS AND ACCORDING TO THE EVIDENCE FOUND, AS SHOWN HEREON.

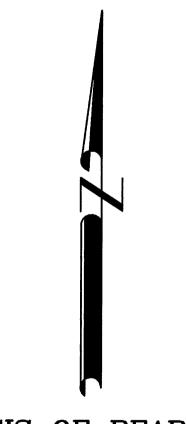

BASIS OF BEARINGS

RECORD LAND PARTITION NO. 2004-04 AS SHOWN

REFERENCES

DEED RECORD INSTRUMENT NO.'S 041335 AND 051209
RECORD LAND PARTITION PLAT NO.'S 2004-04 & 2005-04
RECORD MAP OF SURVEY NO. 1021

- FOUND 2½" ALUMINUM PIPE WITH ATTACHED 3½" ALUMINUM CAP MARKED 1987 RLS 848 FROM MOS 1021
- FOUND 5/8" IRON PIN WITH ATTACHED YELLOW PLASTIC CAP MARKED BGB SURVEY MARKER FROM RECORD LAND PARTITION NO. 2004-04
- O SET 5/8"X30" IRON PIN WITH ATTACHED YELLOW PLASTIC CAP MARKED BGB SURVEY MARKER
-) RECORD BEARING AND DISTANCE FROM LP 2004-04

RECEIVED AND FILED

JULY 17,2007 OFFICE OF COUNTY SURVEYOR

Sout D. Bagost
ATTEST: Joan 2 Hayred

REGISTERED PROFESSIONAL LAND SURVEYOR

OREGON
JULY 12, 1963
ROBERT D. BAGETT
598

Renewal Date 12/31/07

BAGETT, GRIFFITH & BLACKMAN

217 N. Canyon Blvd. John Day, Oregon

MAP OF SURVEY

PROPOSED PROPERTY LINE ADJUSTMENT
BETWEEN PARCEL 1 LP 2004-04 & PARCEL 1 LP 2005-04
SITUATED IN THE SE1/4, SW1/4 AND THE NW1/4 SECTION 19,
T.15S., R.32E., W.M.
GRANT COUNTY, OREGON

SURVEYED FOR	PETE RAWLINS/LARRY LASSEN	
SURVEYED BY	RDB & JLH	6/21/2007
Scale: 1"=200'	Drawn by: JLH	