
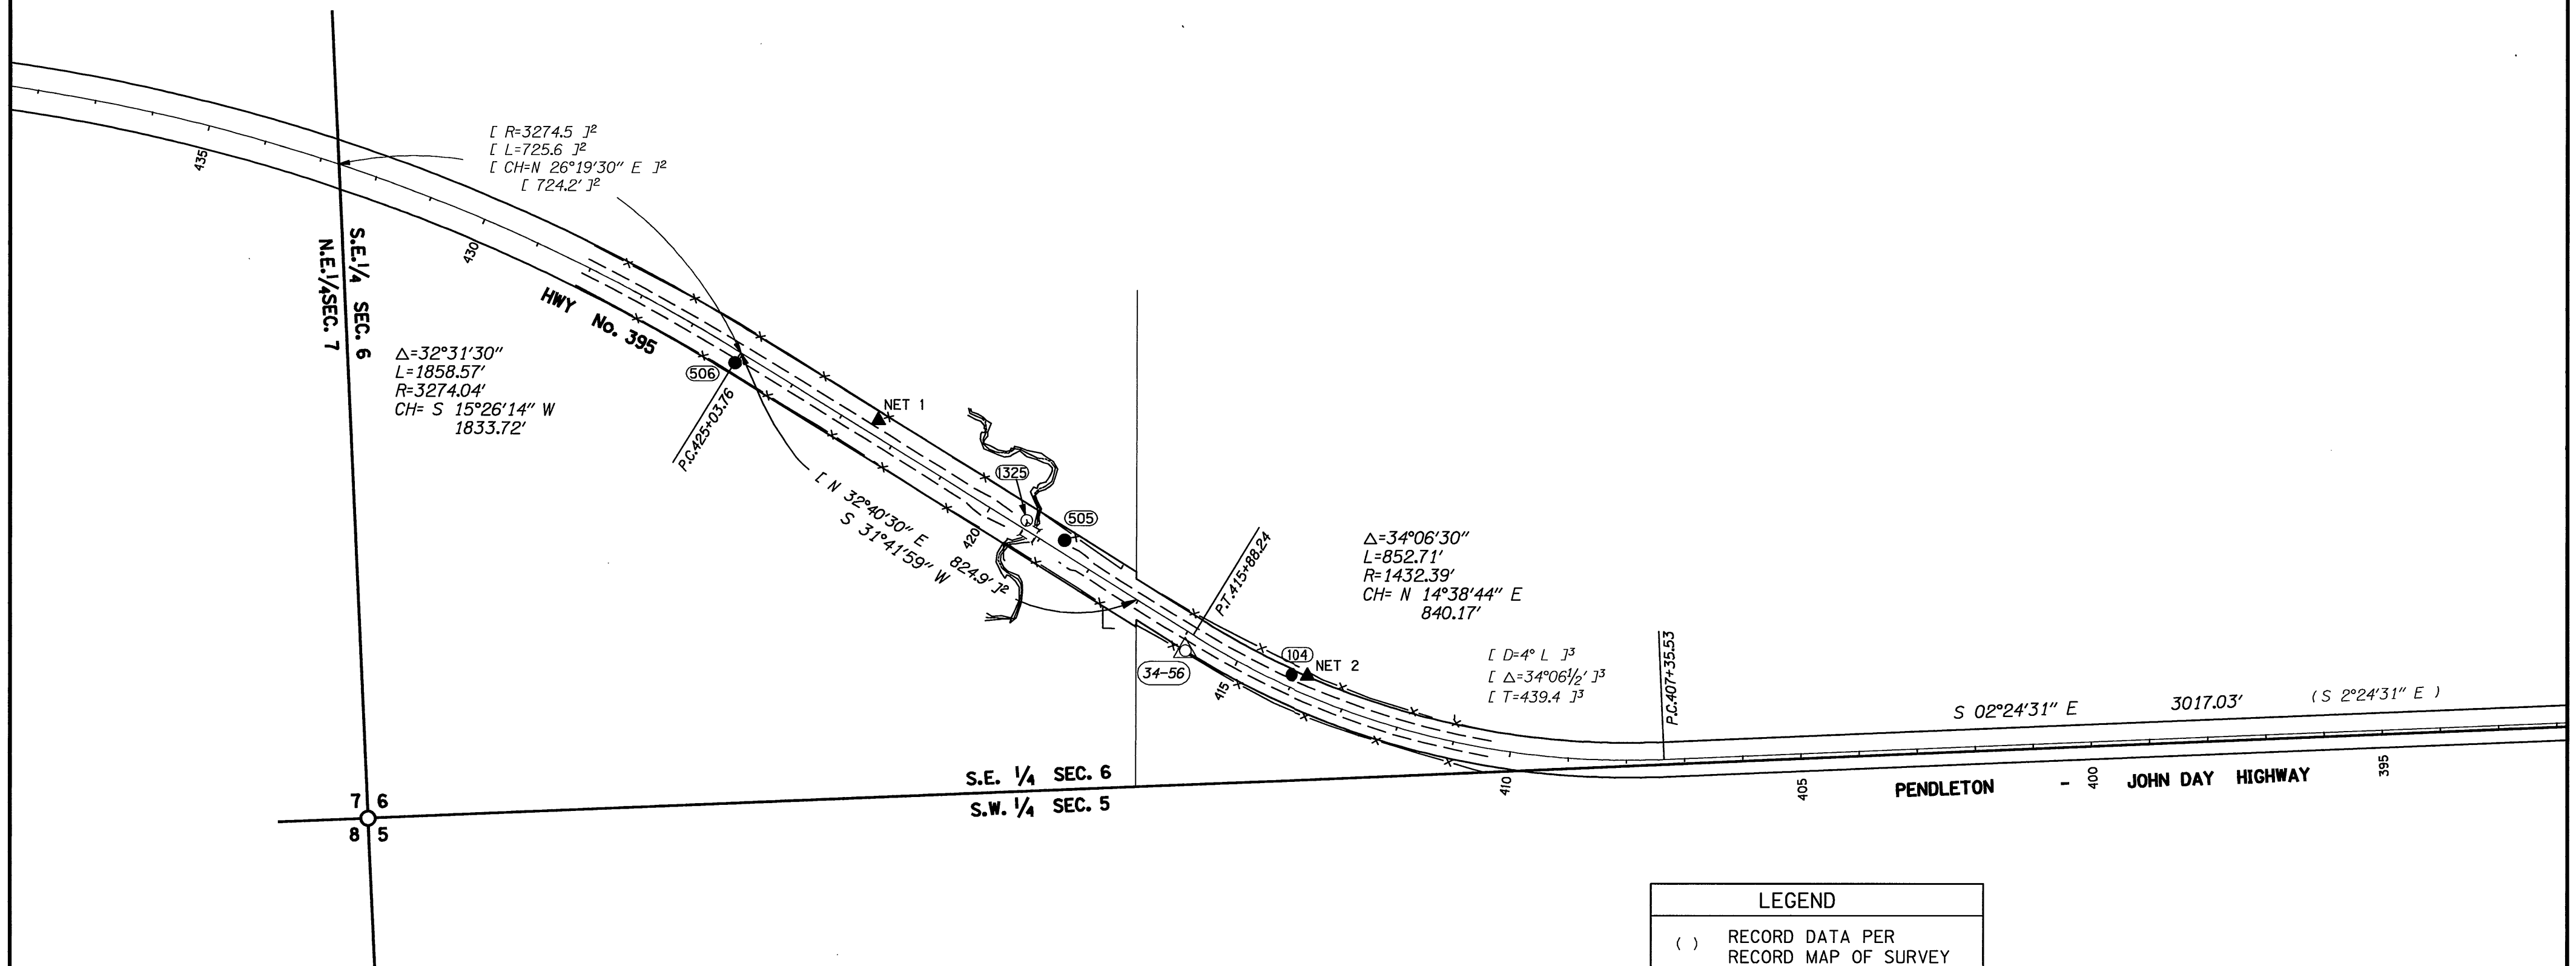


S.E. 1/4 SEC. 6, S.W. 1/4 SEC. 5, T. 11S. R. 30E. W.M.

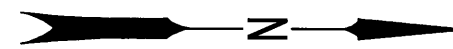

SET MONUMENT LIST


PT. NO.	LDP NORTHING	LDP EASTING	STATION	OFFSET	DESCRIPTION & REFERENCE DOCUMENTS
104	357495.1857	2353784.1954	414+04.39	21.26' R	1/2" IRON ROD (REBAR), 24" LONG WITH RED PLASTIC CAP INSCRIBED "APA CONTROL"
505	357102.5577	2353556.2801	418+61.43	20.47' R	1/2" IRON ROD (REBAR), 24" LONG WITH RED PLASTIC CAP INSCRIBED "APA CONTROL"
506	356535.2340	2353253.5604	425+03.19	20.08' L	1/2" IRON ROD (REBAR), 24" LONG WITH RED PLASTIC CAP INSCRIBED "APA CONTROL"

RECOVERED MONUMENT LIST

PT. NO.	LDP NORTHING	LDP EASTING	STATION	OFFSET	DATE	DESCRIPTION & REFERENCE DOCUMENTS
1325	357037.0033	2353522.1927	419+35.12	15.02' R	10/26/06	3" BRASS CAP IN SOUTHWEST CORNER OF BRIDGE. NO RECORD INFORMATION FOUND
	355904.6429	2354035.2467				SOUTHEAST CORNER OF SECTION 6 WAS NOT FOUND


LEGEND

- () RECORD DATA PER RECORD MAP OF SURVEY NO. 1221
- [J² RECORD DATA PER DEED VOL. 44, PG. 611 GRANT CO. DEED RECORDS
- [J³ RECORD DATA PER ODOT ROLL MAP 5B-31-14
- FOUND MONUMENT NOTED IN TABLE
- ▲ NETWORK POINT
- △ FOUND MONUMENT USED AS NETWORK POINT
- SET STRATEGIC POINT
- EDGE OF PAVEMENT
- RIGHT-OF-WAY
- PROPERTY LINE
- x- FENCE

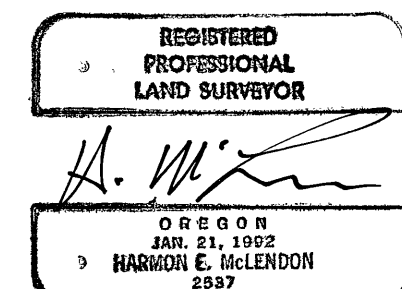

Renews 12/31/08

SCALE 1" = 200'

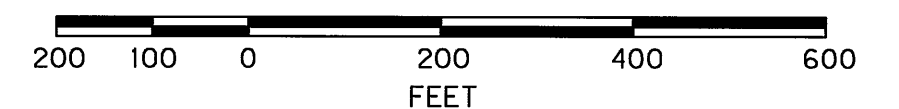

ANDERSON-PERRY & ASSOCIATES
1901 N. FIR ST., LA GRANDE, OR. 97850

HORIZONTAL CONTROL, RECOVERY AND RETRACEMENT SURVEY
BRIDGE 06204, SMITH CREEK AND BRIDGE 06205, FOX CREEK
HIGHWAY 395, (OR 28), MP 98.31 AND MP 99.13,
GRANT COUNTY

FOR O.B.D.P. & O.D.O.T. REGION 5
1165 UNION ST. NE STE 200
SALEM, OR., 97301

AUGUST, 2007
SCALE: AS SHOWN
SHEET 4 OF 4

MAP OF SURVEY NO. 1819