


25 30
36 31

947±

782±


CARL SHEEDY LITTLE PINE CREEK I

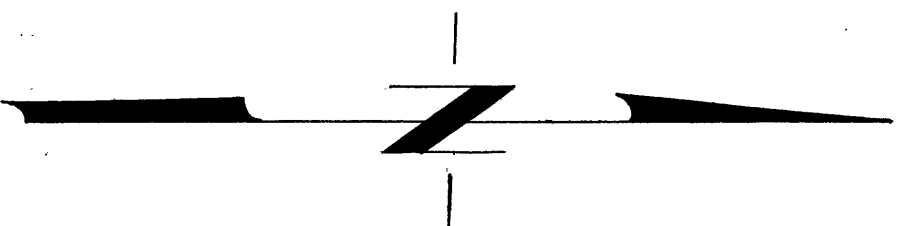

BAIS OF BEARINGS
SOLAR OBSERVATIONS

**REGISTERED
OREGON
LAND SURVEYOR**
Robert D. Baggett
JULY 12, 1963
ROBERT D. BAGGETT
598

Note:
Courses & distances along
County Road refer to centerline.

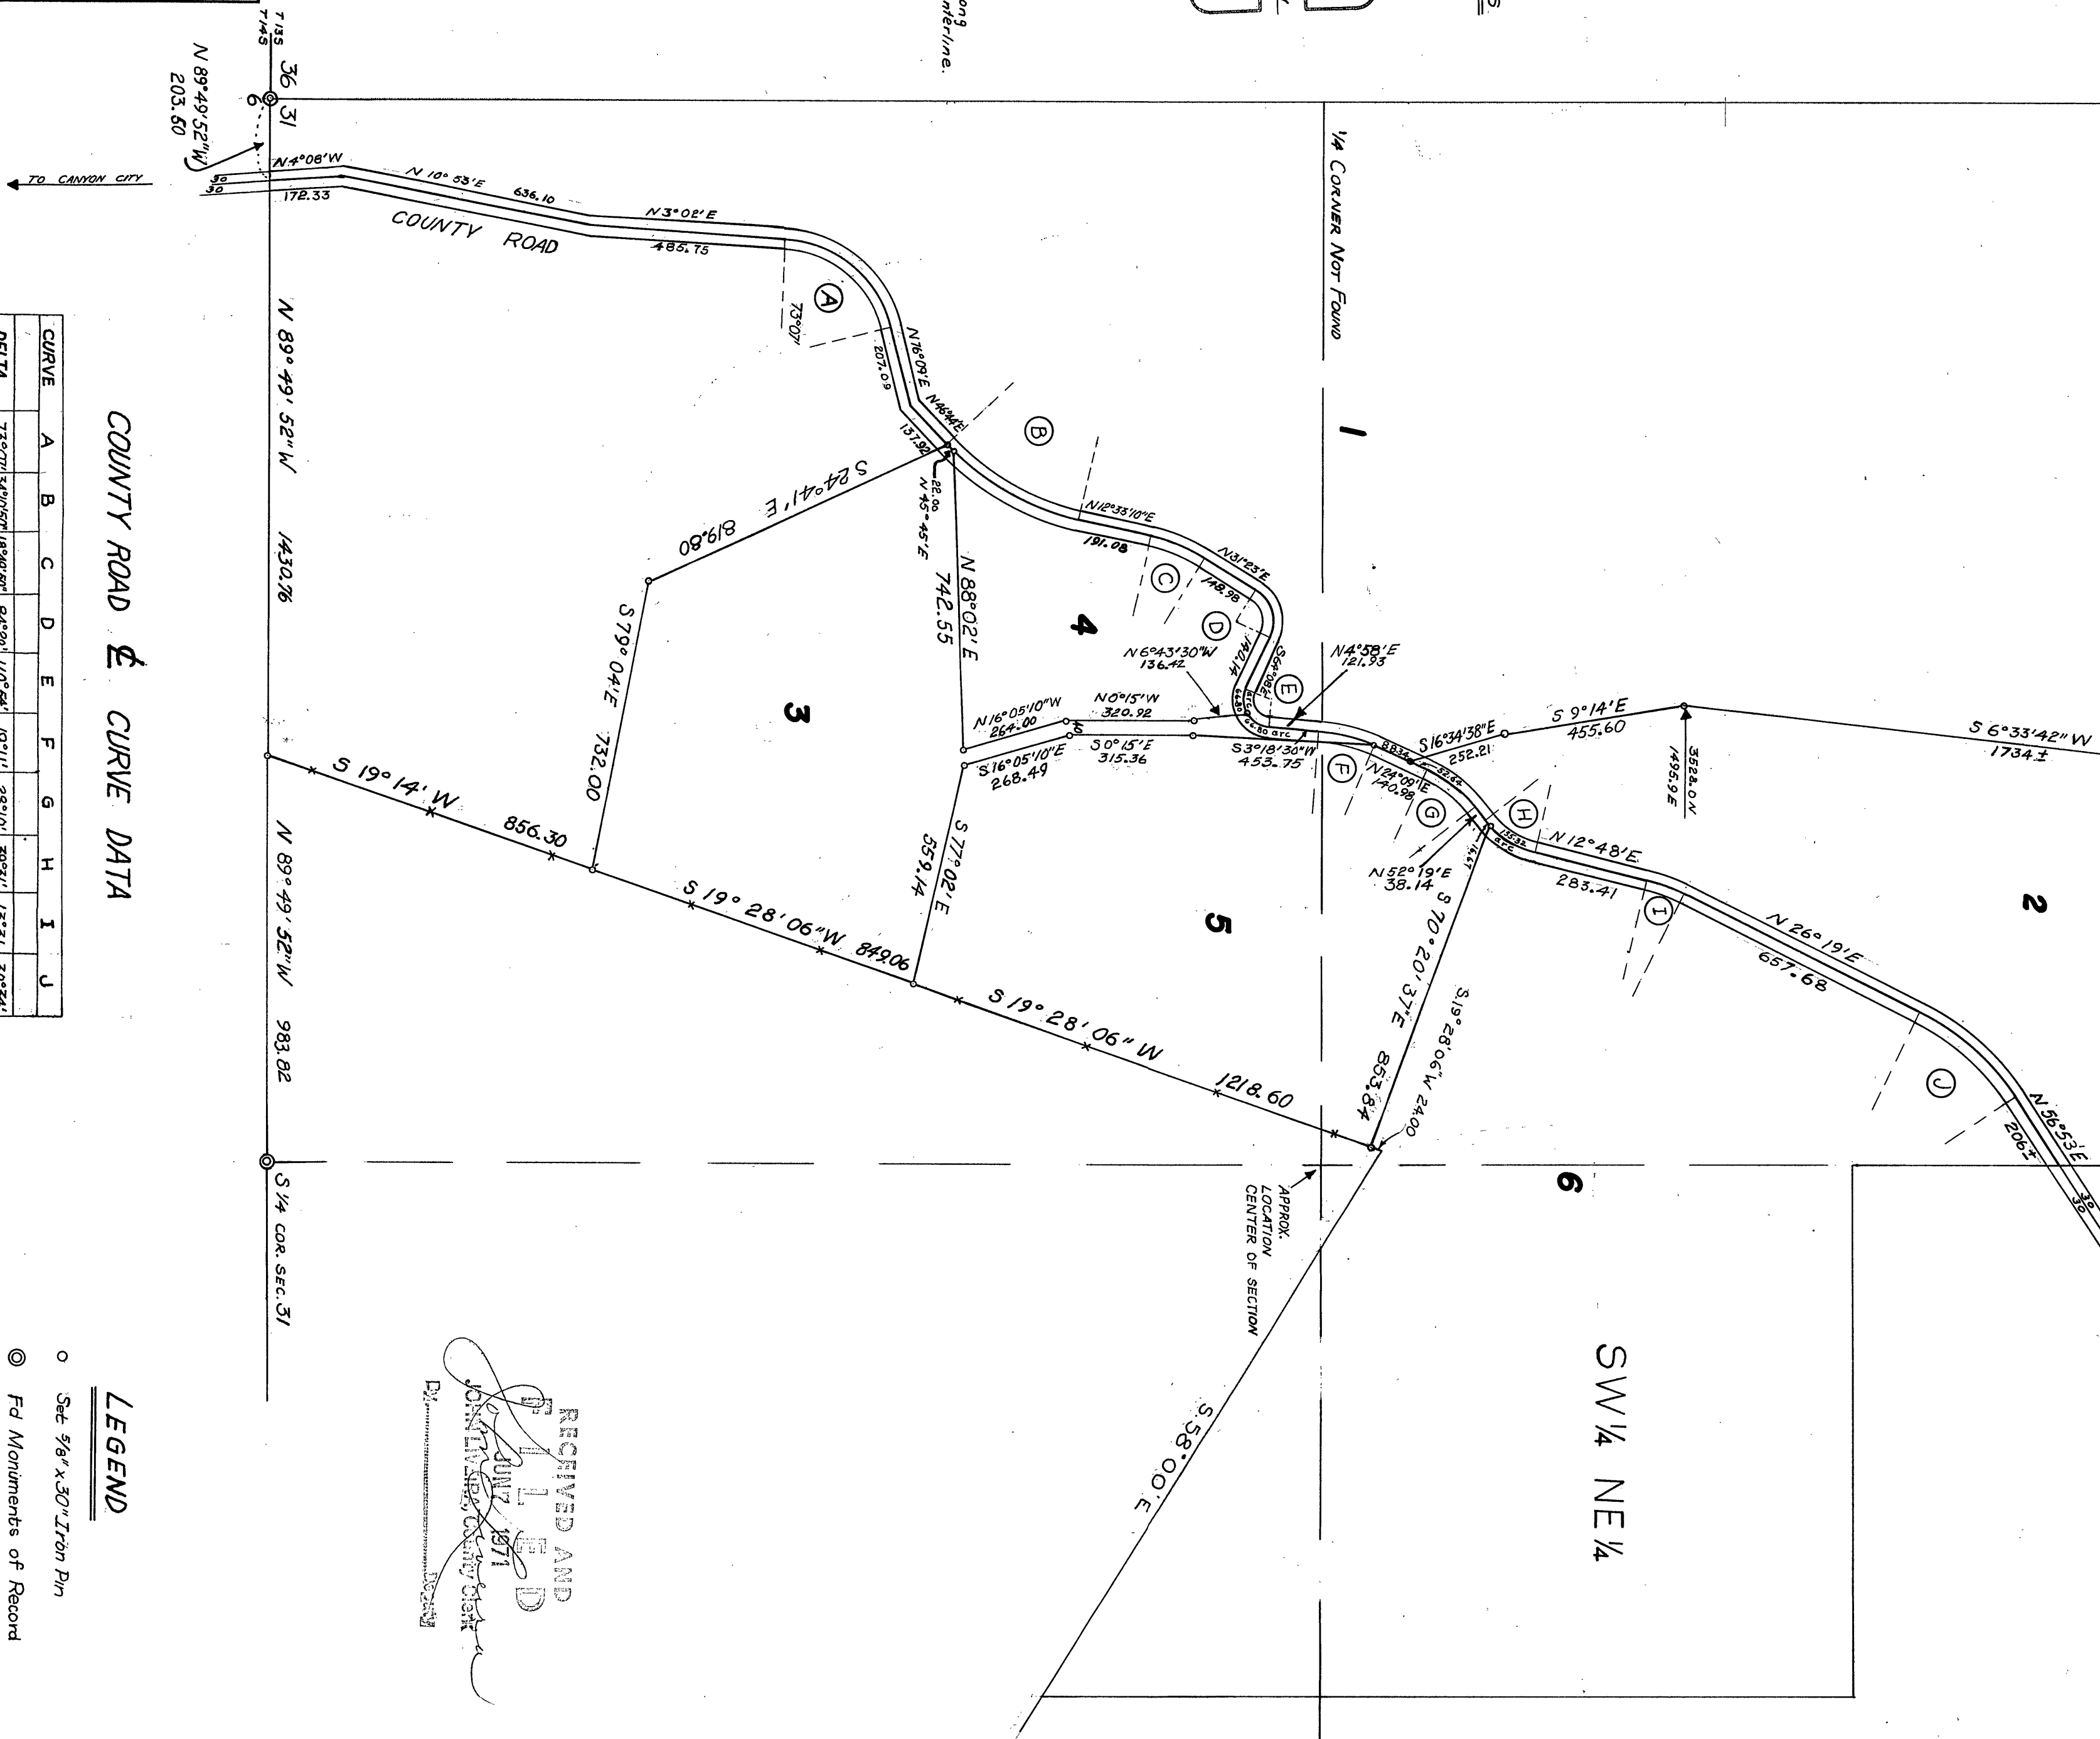

COUNTY ROAD & CURVE DATA

CURVE	A	B	C	D	E	F	G	H	I	J
DELTA	73°07'	34°10'50"	18°49'50"	84°23'	11°0'54"	19°11'	28°10'	39°31'	13°31'	30°34'
RADIUS	285.78	642.14	440.74	90.95	68.03	440.73	318.31	220.37	440.74	603.11
D°	20°02'53"	85°52'11"	13°00'	63°00'	83°00'	13°00'	18°00'	26°00'	13°00'	9°30'
LENGTH	364.63	383.09	144.87	134.10	133.61	147.56	156.48	161.99	103.97	321.75

LEGEND

- Set 5/8" x 30" Iron Pin
- ⊙ Fd Monuments of Record
- Fence

RECEIVED AND
FILED
COUNTY CLERK

BAGGETT & GRIFFITH SURVEYING
John Day, Oregon
MAP OF SURVEY
GRANT COUNTY, OREGON
SURVEYED FOR
CARL SHEEDY
SURVEYED BY
R.D.B. & D.I.G.
Scale: 1" = 300'
Drawn by: T.L.G.
10-15-69