
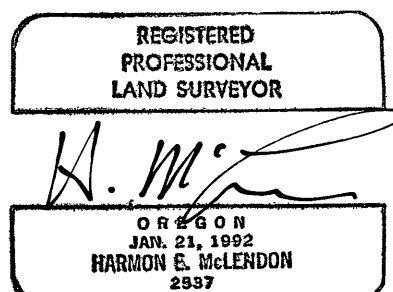


N.E. 1/4 SEC. 27 AND N.W. 1/4 SEC 26,
T. 13S, R. 30E, W.M.

**anderson
perry**
& associates, inc.

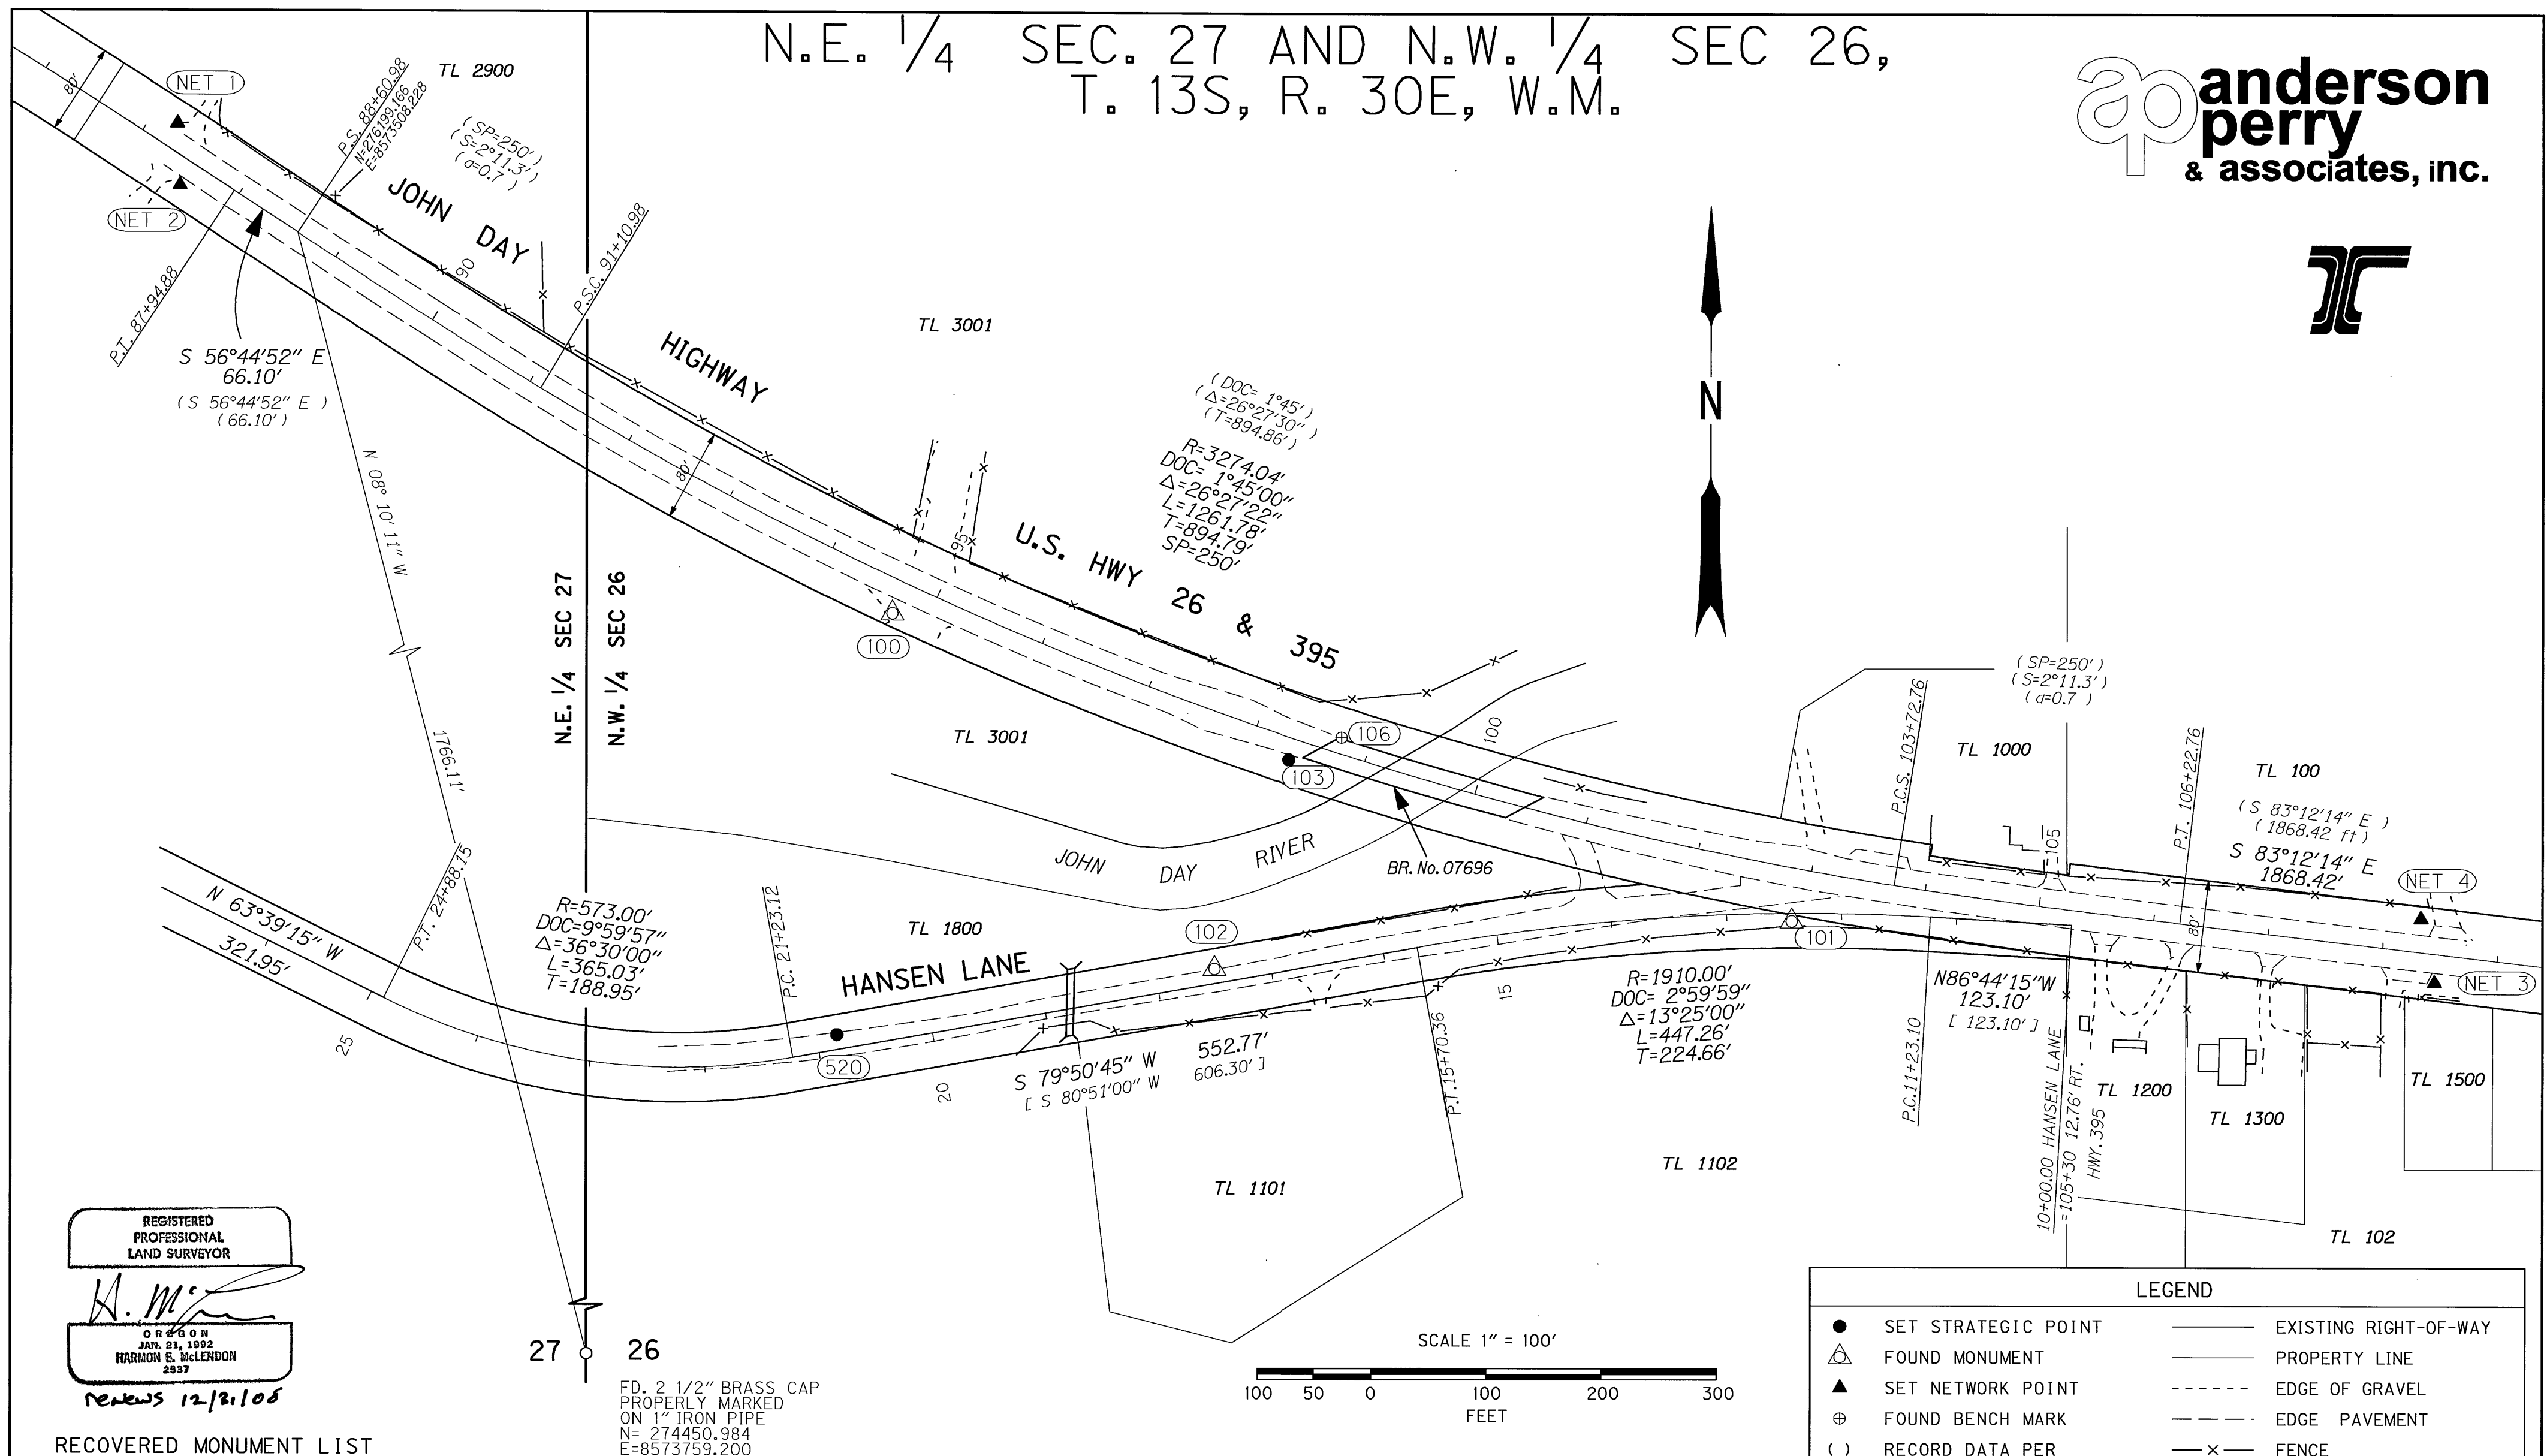

RENEWED 12/21/05

RECOVERED MONUMENT LIST

PT. NO.	LDP NORTHING	LDP EASTING	STATION & ALIGNMENT	OFFSET	DATE	DESCRIPTION & REFERENCE DOCUMENTS
100	275870.4049	8574024.6861	94+70.69 HWY 395	28.67' R	10/18/2006	FOUND 1 1/2" ALUMINUM CAP INSCRIBED "ODOT 2001 100"
106	275763.6056	8574417.0239	98+74.42 HWY 395	13.98' L	10/18/2006	FOUND 3 " BRASS CAP INSCRIBED "STATE HIGHWAY DEPT. BM No. " NO RECORD
101	275604.3052	8574808.0719	102+90.72 HWY 395	45.65' R	10/18/2006	FOUND 1 1/2" ALUMINUM CAP INSCRIBED "ODOT 2001 101"
101	275604.3052	8574808.0719	12+43.43 HANSEN LANE	6.90' L	10/18/2006	FOUND 1 1/2" ALUMINUM CAP INSCRIBED "ODOT 2001 101"
102	275562.1769	8574305.3022	17+48.52 HANSEN LANE	12.46' R	10/18/2006	FOUND 1 1/2" ALUMINUM CAP INSCRIBED "ODOT 2001 102"

SET MONUMENT LIST

PT. NO.	LDP NORTHING	LDP EASTING	STATION & ALIGNMENT	OFFSET	DESCRIPTION
103	275744.0743	8574371.1332	98+36.86 HWY 395	18.80' R	SET 1/2" IRON ROD (REBAR) WITH RED PLASTIC CAP INSCRIBED "APA CONTROL"
520	275503.6521	8573976.7818	20+82.21 HANSEN LANE	12.77' R	SET MAGNETIC PK NAIL

FD. 2 1/2" BRASS CAP
PROPERLY MARKED
ON 1" IRON PIPE
N= 274450.984
E=8573759.200

LEGEND	
●	SET STRATEGIC POINT
△	FOUND MONUMENT
▲	SET NETWORK POINT
⊕	FOUND BENCH MARK
()	RECORD DATA PER ODOT DRG. 7B-16-21
[]	RECORD DATA PER PARTITION PLAT 96-12
---	EXISTING RIGHT-OF-WAY
---	PROPERTY LINE
---	EDGE OF GRAVEL
---	EDGE PAVEMENT
-x-	FENCE
###	MONUMENT POINT NUMBER

ANDERSON-PERRY & ASSOCIATES
1901 N. FIR ST., LA GRANDE, OR., 97850

HORIZONTAL CONTROL, RECOVERY AND RETRACEMENT MAP
BRIDGE #07696, COLES
JOHN DAY HIGHWAY-OR HWY 5 (US 26, US 395) MP 155.75
GRANT COUNTY

FOR OBDP & ODOT REGION 5
1165 UNION ST., NE STE 200
SALEM, OR., 97301

AUGUST 2007
SCALE: 1"=100'
SHEET 2 OF 2

MAP OF SURVEY NO. 1821