
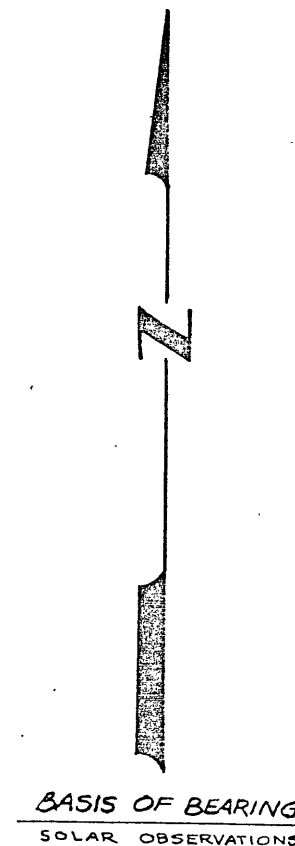


SURVEYOR'S CERTIFICATE:

I, Duane I. Griffith, do hereby certify that I made a survey of the area hereon shown and that these are the conditions I find: In researching the area, I find reason to believe the section line I now find is probably not the same line referred to in deed description in the area. I find unrecorded iron pipes to the east as shown - the E-W position of these pins are in harmony with fence lines and existing improvements to the west for a distance of 1000 ft. I therefore accept the position of these pins for East-West. The North-South position is based on the deed descriptions and existing improvements.

DUANE I. GRIFFITH
SURVEYOR
644

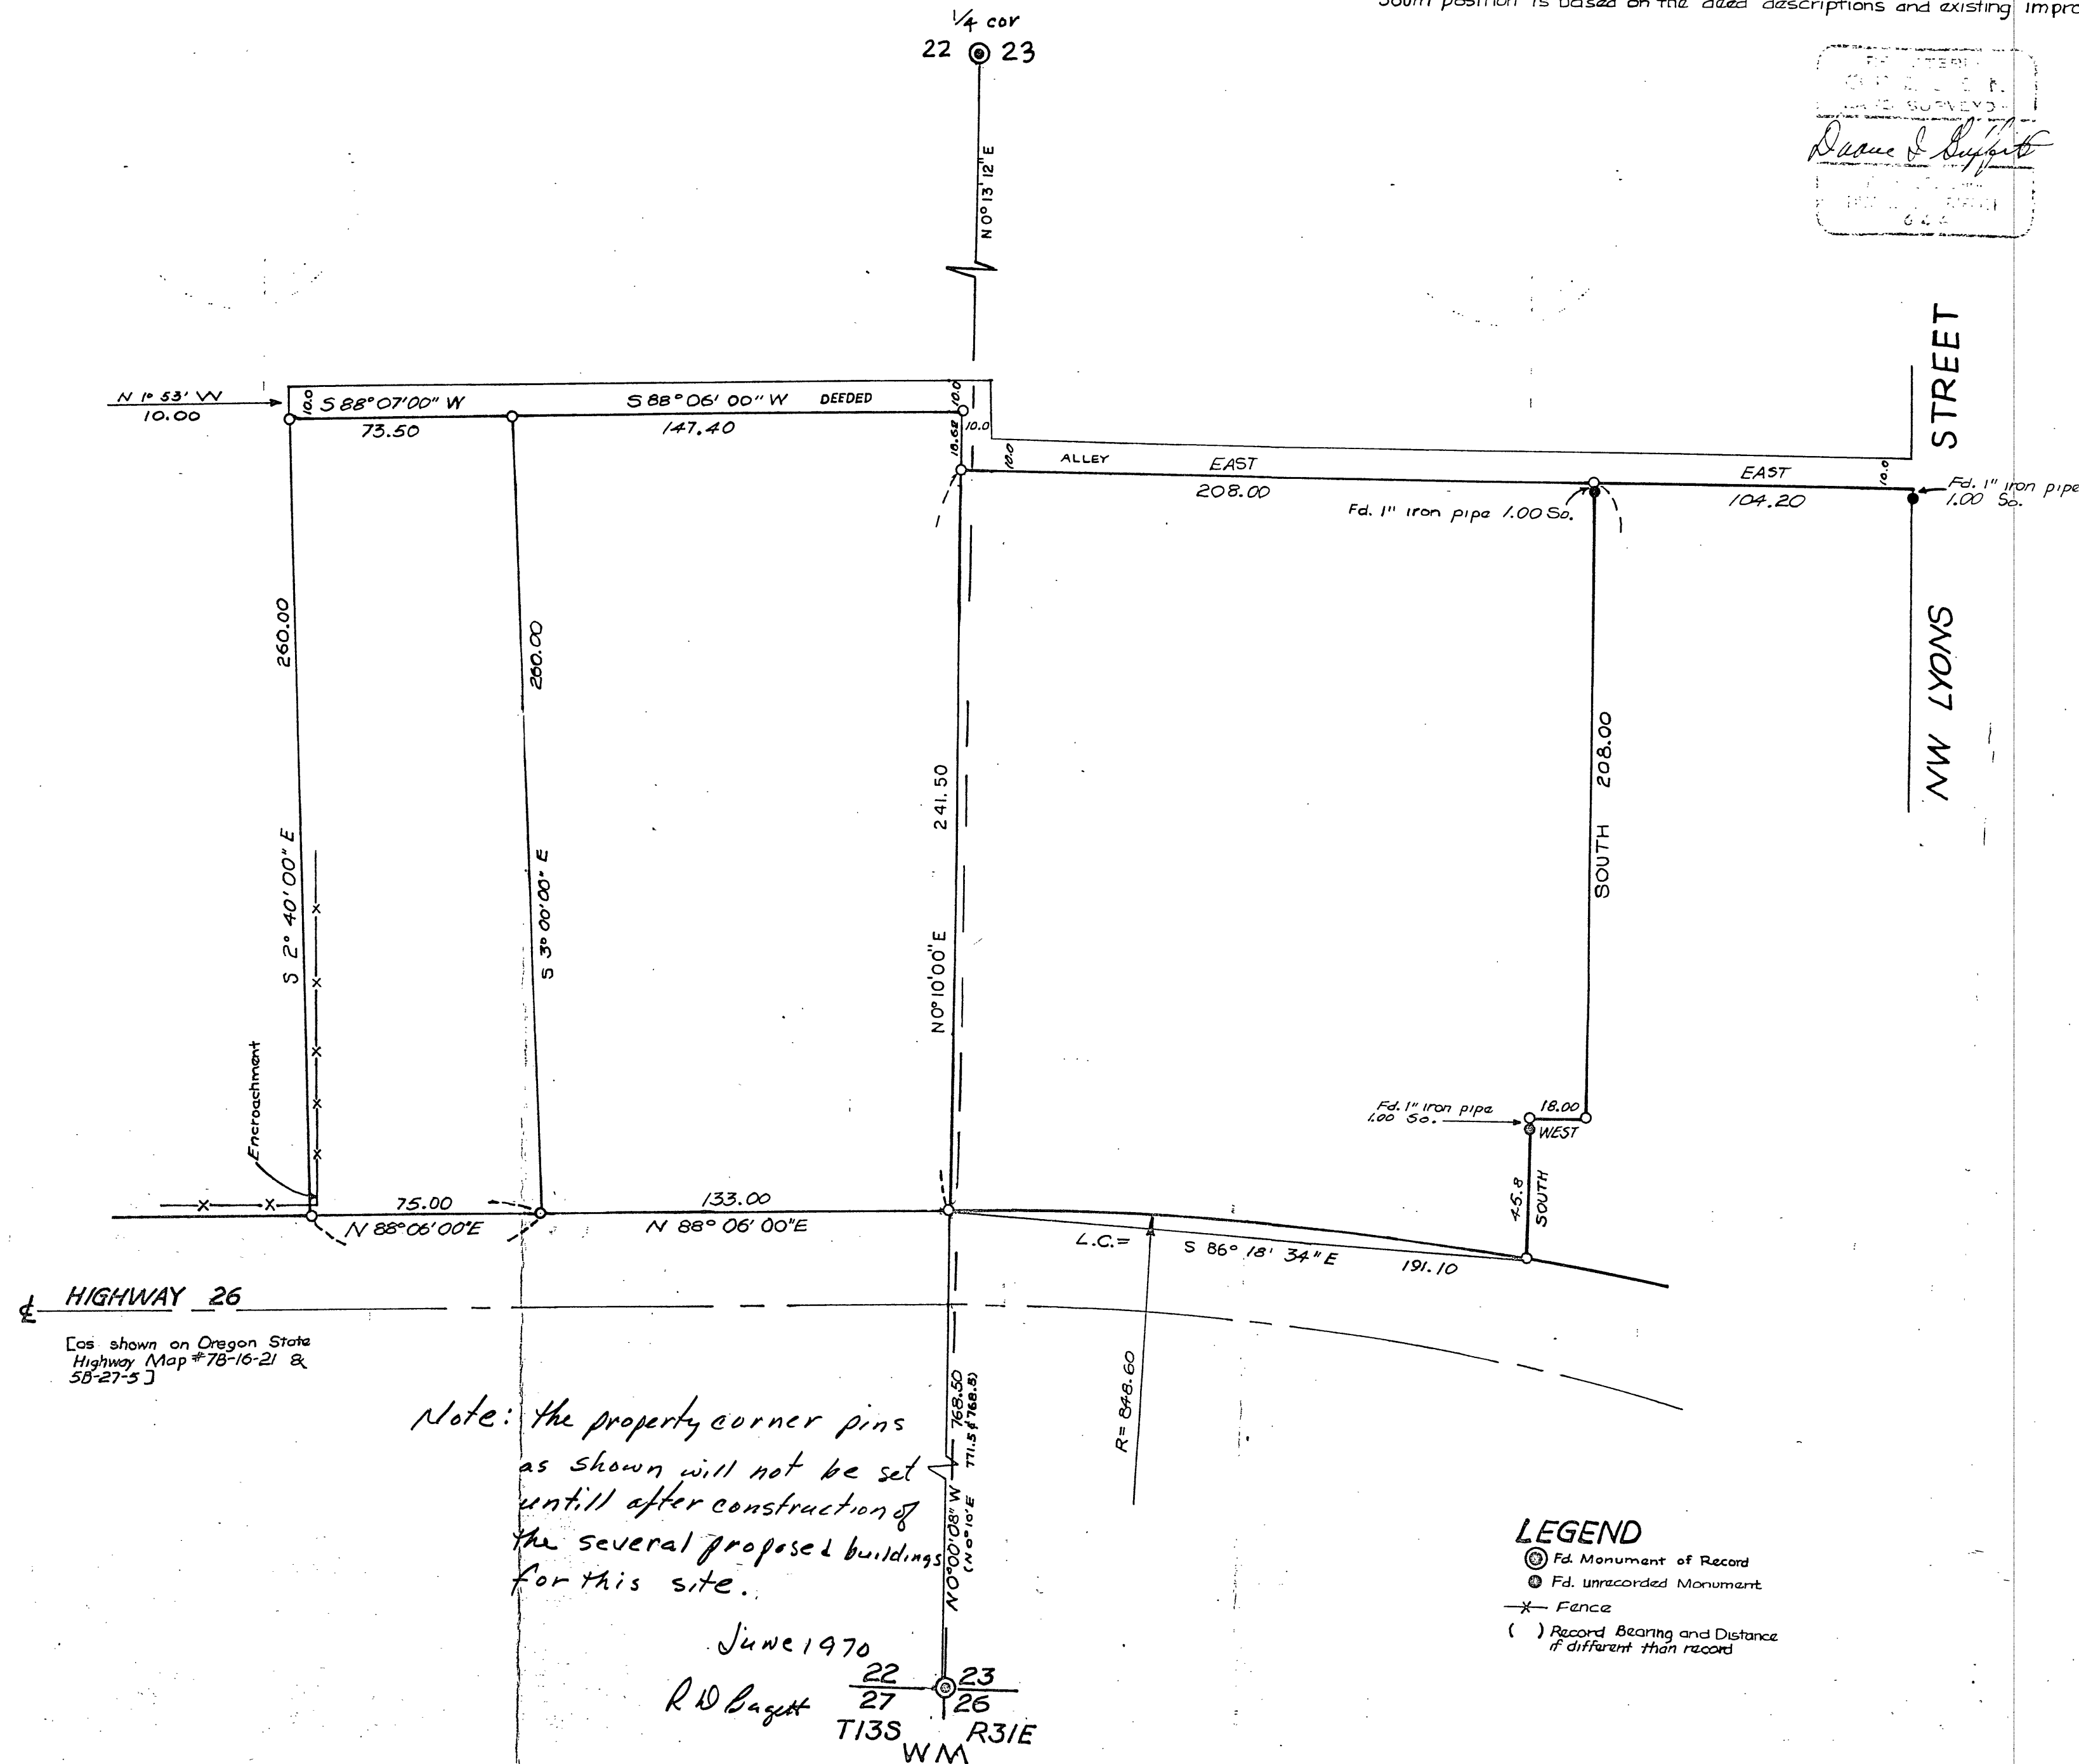

Note: the property corner pins as shown will not be set until after construction of the several proposed buildings for this site.

June 1970
R.D. Baggett

LEGEND

- ⊙ Fd. Monument of Record
- ⊙ Fd. Unrecorded Monument
- x- Fence
- () Record Bearing and Distance if different than record

BAGETT, GRIFFITH & FERGUSON John Day, Oregon MAP OF SURVEY		
PARCELS IN SECTIONS 22 & 23 T13S R31E W31E WEST JOHN DAY GRANT COUNTY, OREGON		
SURVEYED FOR	ERICKSON'S SUPER MARKET	
SURVEYED BY	D.I.G.	MAY-1970
Scale: 1" = 40'	Drawn by: T.D.G.	MAY-1970

Map of Survey # 186