

# NARRATIVE

THIS SURVEY WAS PERFORMED AT THE REQUEST OF STAN HORRELL, ON BEHALF OF THE CITY OF PRAIRIE CITY. THE PURPOSE OF THIS SURVEY WAS TO LOCATE AND MONUMENT THAT TRACT OF LAND DESCRIBED IN BOOK 92 PAGE 175, DEED RECORDS OF GRANT COUNTY, OREGON.

A SEARCH WAS MADE OF THE AVAILABLE RECORDS PERTAINING TO THIS SURVEY. FIELD MEASUREMENTS WERE MADE TO LOCATE APPURTENANT MONUMENTS SHOWN ON RECORD MAP OF SURVEY NO. 1195. I ACCEPT THE FOUND CONTROLLING MONUMENTS FROM SURVEY NO. 1195, WE SET NEW MONUMENTS ACCORDING TO THE EVIDENCE FOUND AND THE DEED RECORD, AS SHOWN HEREON.

## LEGEND

- FOUND 5/8" IRON PIN WITH ATTACHED ALUMINUM  
CAP MARKED BSA SURVEY MARKER AND WITH  
APPROPRIATE CENTERLINE STATION FROM SURVEY  
NO. 1195
- SET 5/8"x30" IRON PIN WITH ATTACHED YELLOW  
PLASTIC CAP MARKED BENCHMARK SURVEYING
- ( ) DEED RECORD BEARING AND DISTANCE
- [ ] RECORD BEARING AND DISTANCE FROM SURVEY NO. 1195
- X—X FENCE LINE

## REFERENCES

RECORD MAP OF SURVEY NO. 1195  
DEED RECORD INSTRUMENT NO. 221952  
DEED RECORD BOOK 92 PAGE 175


**REGISTERED  
PROFESSIONAL  
LAND SURVEYOR**

*James L Hatfield*  
OREGON  
NOVEMBER 30, 2007  
JASON L. HATFIELD  
#69454  
EXPIRES: 6/30/2011

**RECEIVED AND  
FILED**

OFFICE OF COUNTY SURVEYOR  
Oct 2, 2009

ATTEST: [Signature]

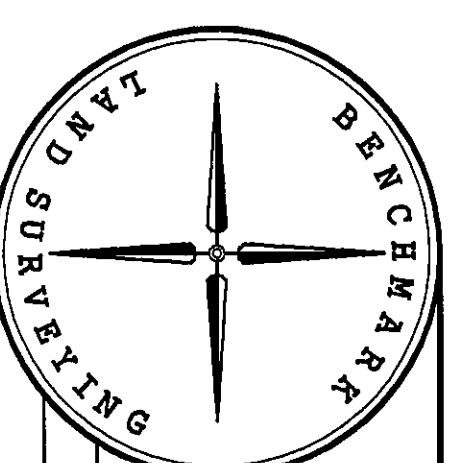

**BENCHMARK LAND SURVEYING**  
217 N. CANYON BLVD. JOHN DAY, OREGON  
2101 MAIN STREET, STE 223 BAKER CITY, OREGON  
541-575-1251 ~ 800-699-0516

**BASIS OF BEARINGS**

RECORD MAP OF SURVEY NO. 1195

AS SHOWN

RECORD MAP OF SURVEY NO. 1879