


RECEIVED AND
FILED

JUL 17 1970

JOHN L. LIVEIRA, County Clerk

Edna Campbell

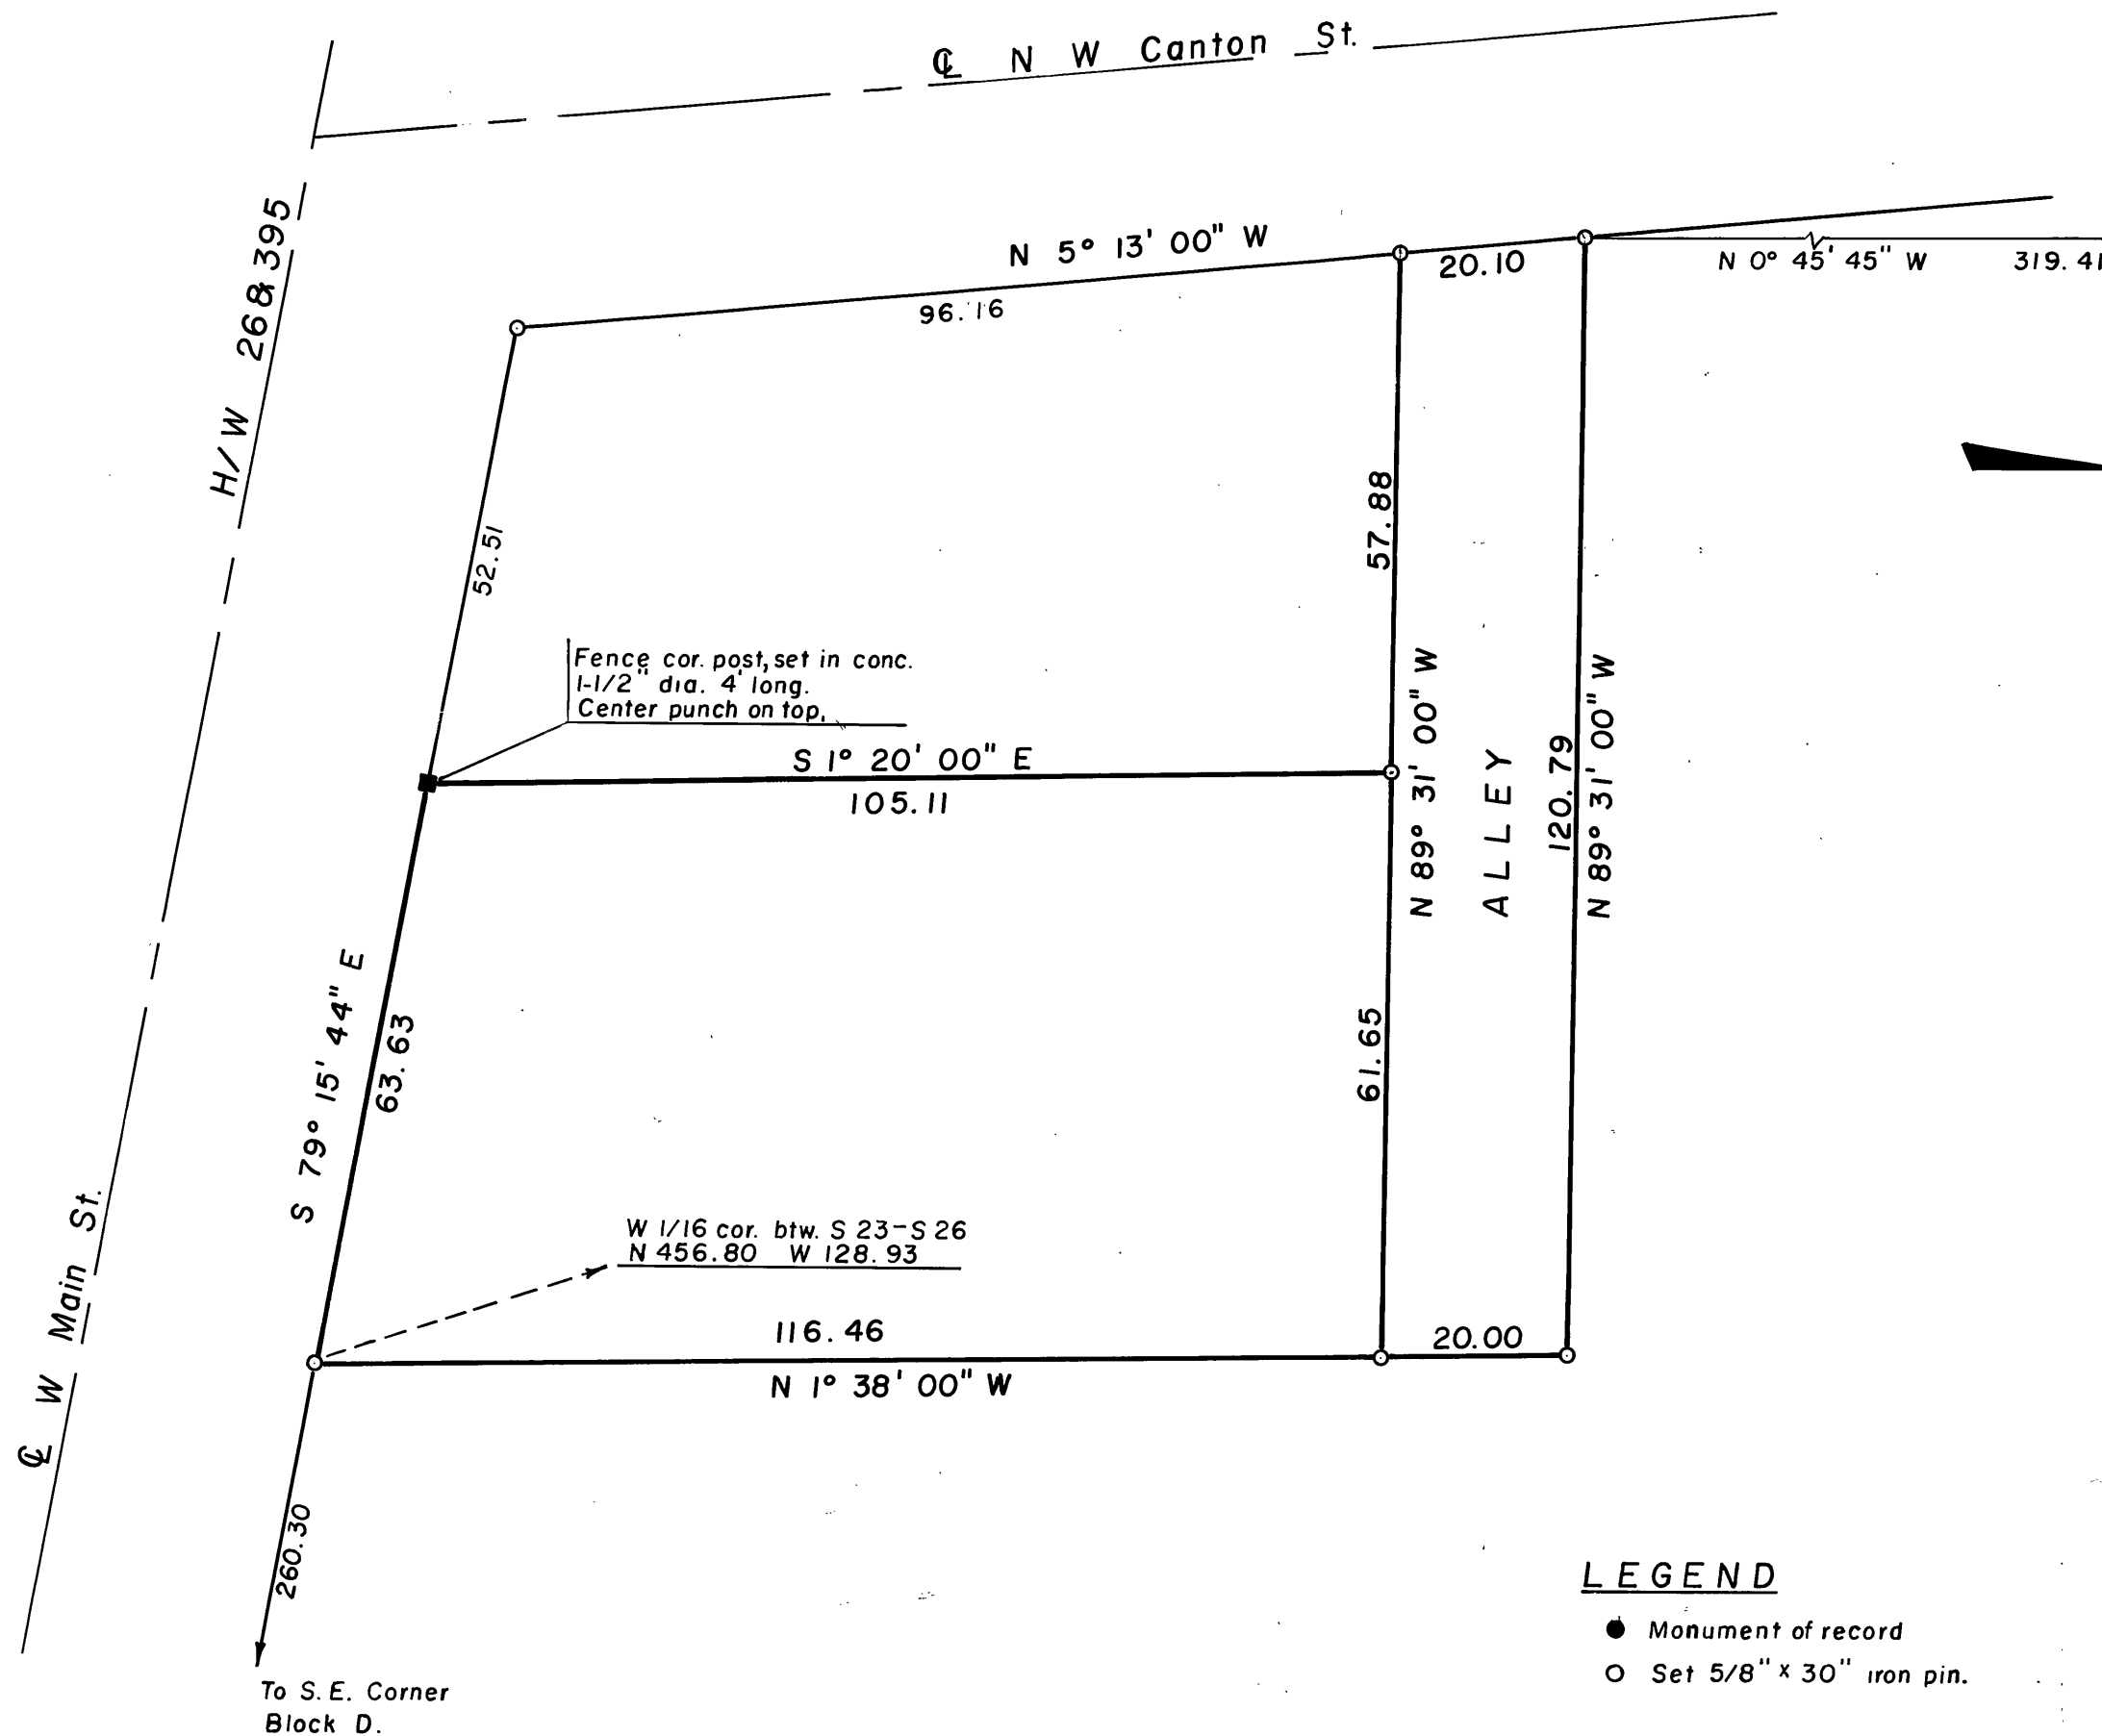

Basis of Bearing
Solar Observations

REGISTERED
OREGON
LAND SURVEYOR

Duane I. Griffith

JULY 10, 1964
DUANE I. GRIFFITH
644

LEGEND

- Monument of record
- Set 5/8" x 30" iron pin.

BAGETT-GRIFFITH-FERGUSON

John Day, Oregon

Map of Survey

Portions of

BLOCK "D"

City of John Day

Grant County, Oregon

SURVEYED FOR	ESTHER GUNTHER	
SURVEYED BY	D.I.G.	6/1970
Scale: 1" = 20'	Drawn by: D.I.G.	6/1970

Map of Survey #189