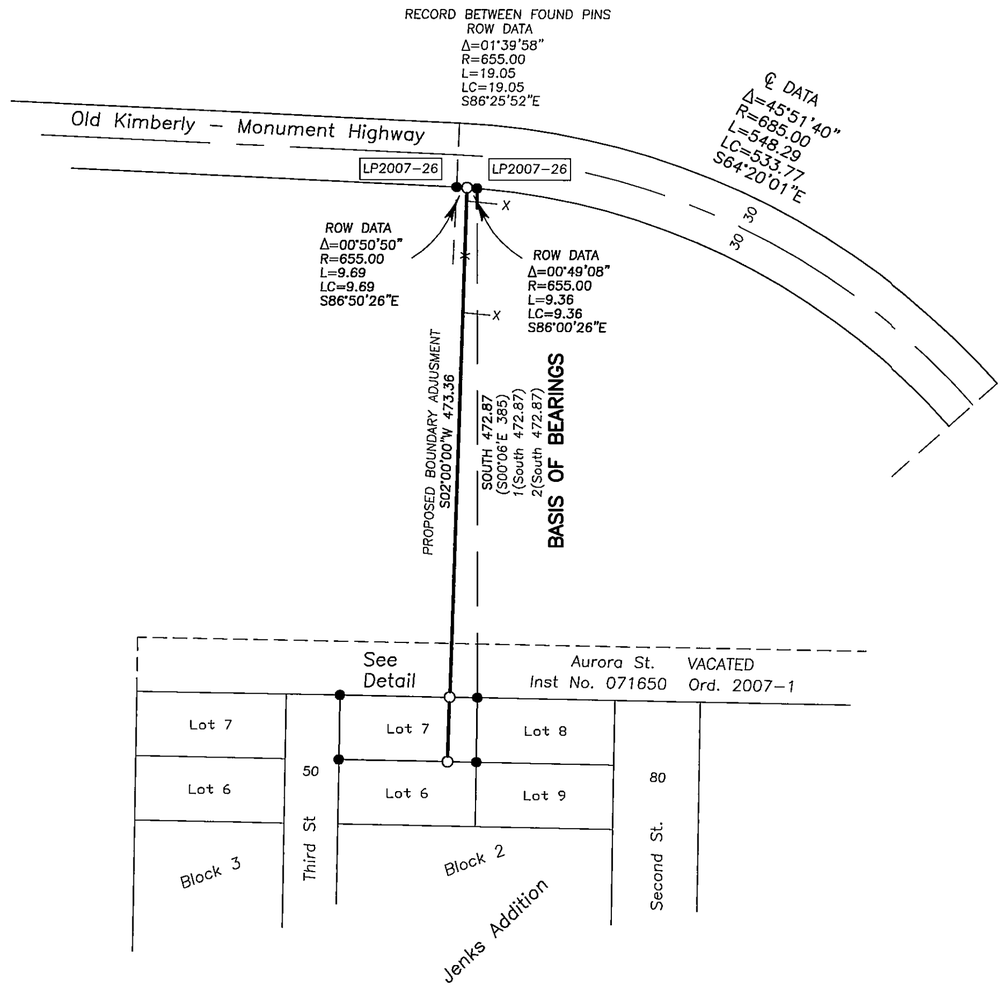

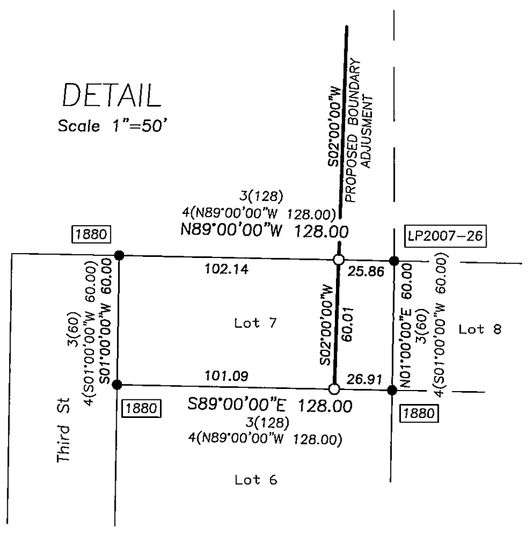

Scale 1"=100'

BASIS OF BEARINGS

Land Partition No. 2007–26

LEGEND

●	Found 5/8" iron pin with attached red plastic cap, see Land Partition No. 2007–26.
O	Set 5/8"x30" iron pin with attached red plastic cap marked CORNERSTONE SURVEYING, INC.
X——X	Fence Line
( )	Deed record bearing and distance.
1( )	Land Partition No. 2007–26 record bearing and distance.
2( )	Land Partition No. 2009–10 record bearing and distance.
3( )	Jenks Addition record bearing and distance.
4( )	Survey No.1880 record bearing and distance.
▭	Found monument, see record map of survey number shown in box.

NARRATIVE

This survey was performed at the request of Michael Reule, Monument School Principle. The purpose of this survey was to locate and monument a proposed boundary adjustment line along the west line of the school district property.

A search was made of the available records pertaining to this survey. Field measurements were made to locate the existing monuments. I accept the found monuments shown hereon. I met the representatives of the three affected property owners at the site. The proposed boundary adjustment line monumented in this survey was agreed to by all three representatives.

REGISTERED
PROFESSIONAL
LAND SURVEYOR
OREGON
SEPT 19, 1995
JACK L. WATSON
2734
Renewal Date 6/30/2010

CORNERSTONE SURVEYING, Inc.
233 S. Canyon Blvd., John Day, Oregon 97845
(541) 575–1813

MAP OF SURVEY
SITUATED IN THE NW1/4 OF SECTION 1
T9S, R27E, W.M.
TOWN OF MONUMENT
GRANT COUNTY, OREGON

SURVEYED FOR: **Monument School District No. 8**

SURVEYED BY : Jack Watson

SURVEY COMPLETED: 4/15/2010

RECEIVED AND FILED
MAY 3, 2010
OFFICE OF COUNTY SURVEYOR
Attest:

MAP OF SURVEY NO. 1892