



BASIS OF BEARINGS

RECORD SURVEY NO. 1604
AS SHOWN

NARRATIVE

ATTACHED AS A SEPARATE DOCUMENT

REFERENCES

RECORD MAP OF SURVEY NO.'S 130 & 1604
RECORD LAND PARTITION PLAT NO. 96-22
GLO FIELD NOTES
GRANT COUNTY CORNER RESTORATION RECORDS

LEGEND


- FOUND 1 1/2" GALV. IRON PIPE WITH ATTACHED GRANT COUNTY SURVEYOR BRASS CAP
SEE CORNER RESTORATION RECORDS
- ⊙ FOUND 2 1/2" IRON PIPE WITH ATTACHED BLM BRASS CAP FROM 1962 CADASTRAL SURVEY - SEE RECORD SURVEY NO. 130
- ⊙ FOUND 2 1/2" IRON PIPE WITH ATTACHED GLO BRASS CAP FROM 1962 CADASTRAL SURVEY - SEE RECORD SURVEY NO. 130
- ⊙ SET 1 1/2" IRON PIPE WITH ATTACHED 2 1/2" BRASS CAP MARKED AS SHOWN, UNLESS OTHERWISE NOTED
- SET 5/8"x30" IRON PIN WITH ATTACHED 2" ALUMINUM CAP MARKED "BENCHMARK LAND SURVEYING" AND WITH APPROPRIATE CORNER DESIGNATION

G() GLO RECORD BEARING AND DISTANCE
[] RECORD BEARING AND DISTANCE FROM SURVEY NO. 130
1[] RECORD BEARING AND DISTANCE FROM SURVEY NO. 1604
X—X FENCE LINE

RECEIVED AND
FILED
JUNE 30, 2010
OFFICE OF COUNTY SURVEYOR

ATTEST: *Robert D. Angert*

REGISTERED
PROFESSIONAL
LAND SURVEYOR
Michael C. Springer
OREGON
JULY 9, 2002
MICHAEL C. SPRINGER
#70918
EXPIRES: 6/30/2010

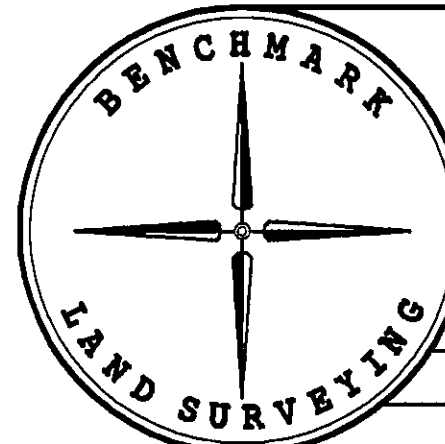

BENCHMARK LAND SURVEYING 217 N. CANYON BLVD. JOHN DAY, OREGON 2101 MAIN STREET, STE 223 BAKER CITY, OREGON 541-575-1251 ~ 800-699-0516		
MAP OF SURVEY A PORTION OF PARCEL 1 OF LAND PARTITION PLAT NO. 96-22 SITUATED IN SECTION 24, T.13S., R.26E., W.M., GRANT COUNTY, OREGON		
SURVEYED FOR	ART KILANDER	
SURVEYED BY	MCS & JLH	6/24/2010
Scale: 1"=1000'	Drawn by:	MCS

RECORD MAP OF SURVEY NO. 1893

