

**SURVEY OF OCHOCO NATIONAL FOREST BOUNDARY LINES IN THE SW 1/4 OF SECTION 14, IN THE NE 1/4 OF SECTION 19, IN THE NW 1/4 OF SECTION 20, IN THE SE 1/4 OF SECTION 27, IN THE E 1/2 OF SECTION 28, IN THE W 1/2 OF SECTION 31 AND IN THE NE 1/4 OF SECTION 34, TOWNSHIP 16 SOUTH, RANGE 26 EAST, W.M., GRANT COUNTY, OREGON
W.O. 09-3921 WILLOW CADASTRAL SURVEY CON. NO. AG-04NO-D-09-0012**


LEGEND

- FOUND 2-1/2 INS. O.D. GALVANIZED PIPE WITH 2-1/2 INS. BRASS CAP STAMPED AS SHOWN ON CORNER SUMMARY AS PER C.S. 67 BY L. C. STRATTON, PE4563, DATED 1962.
- FOUND 2-1/2 INS. O.D. GALVANIZED PIPE WITH 3-1/4 INS. BRASS CAP STAMPED AS SHOWN ON CORNER SUMMARY AS PER BLM DEPENDENT RESURVEY UNDER GROUP 359 BY C. ALBERT WHITE, DATED OCTOBER 18, 1957, PERFORMED 1959-1960, APPROVED MAY 1, 1962.
- 2 () ORIGINAL GENERAL LAND OFFICE RECORD BY ALONZO GESNER, DEPUTY SURVEYOR, UNDER CONTRACT NO. 206 DATED JULY 10, 1874.
- 3 () RECORD AS PER BLM SURVEY BY C. ALBERT WHITE, CADASTRAL SURVEYOR, UNDER GROUP 359 OREGON DATED OCTOBER 18, 1957 AND APPROVED MAY 1, 1962.
- 4 () RECORD AS PER C.S. 67 BY L. C. STRATTON, PE 4563, RECORDED 1962.

(V19) CORNER MONUMENT NUMBER - SEE CORNER SUMMARY FOR INFORMATION


— INDICATES OCHOCO NATIONAL FOREST BOUNDARY LINES POSTED UNDER THIS CONTRACT WITH SIX FEET LONG ALUMINUM POSTS WITH NATIONAL FOREST BOUNDARY SIGNS (54-2) ATTACHED.

NFSL NATIONAL FOREST SYSTEM LAND
PVT PRIVATE LANDS
CHS. CHAINS
C.S. COUNTY SURVEY

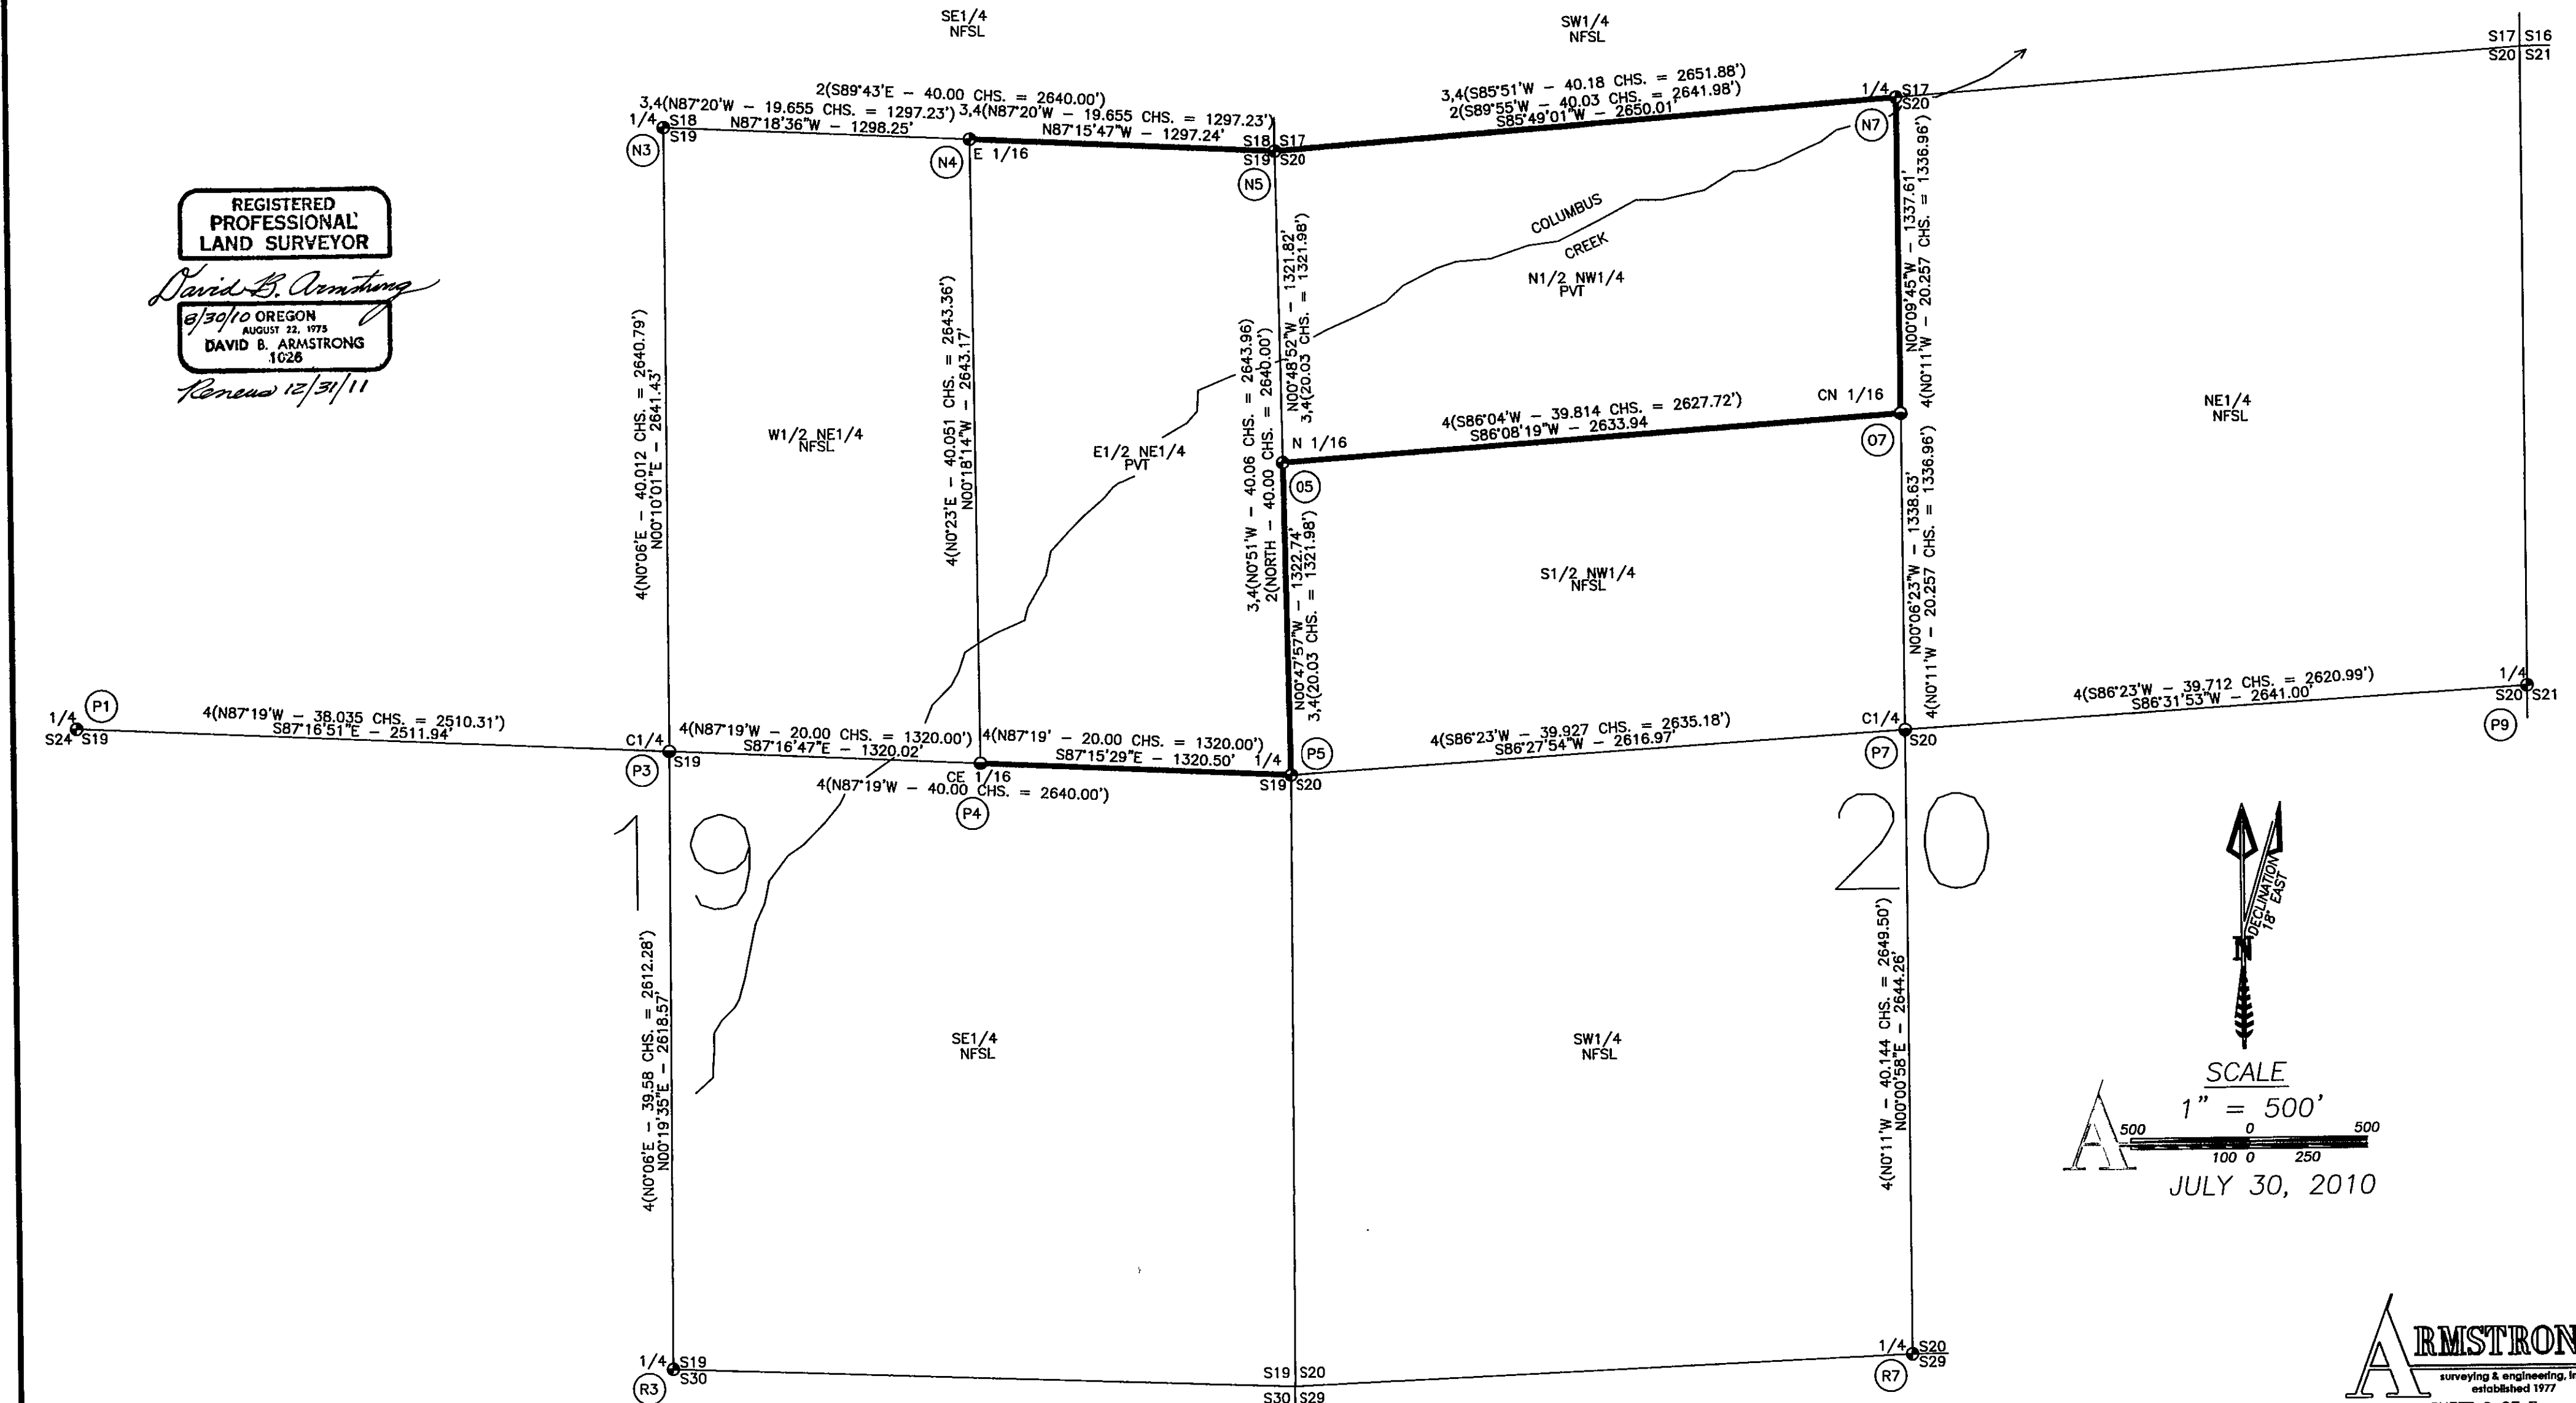

REGISTERED
PROFESSIONAL
LAND SURVEYOR

David B. Armstrong
8/30/10 OREGON
AUGUST 22, 1975
DAVID B. ARMSTRONG
1026
Renew 12/31/11

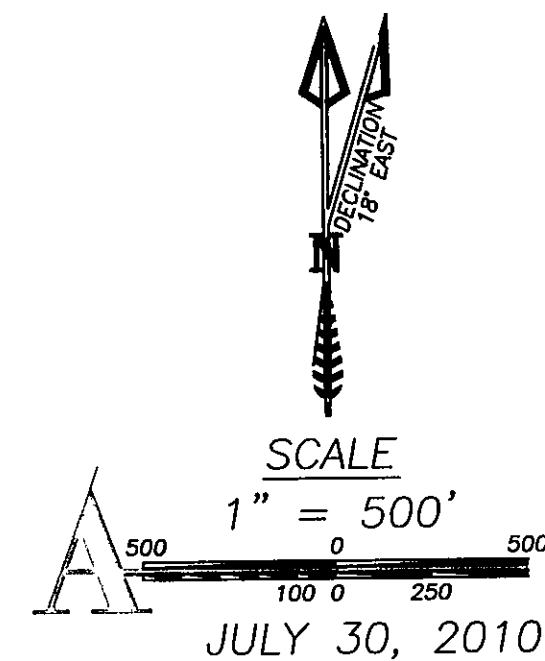

ARMSTRONG
surveying & engineering, inc.
established 1977

SHEET 2 OF 7
DRG. NO. 10-3921.DWG
W.O. 09-3921

GRANT COUNTY SURVEY 1899