


T8S R27E

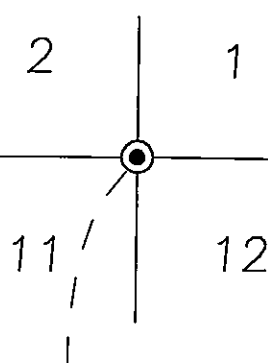

BASIS OF BEARINGS
(NORTH 2640)
1(N00°40'19"E 2514.81)
N00°40'19"E 2514.89

1257.45

1257.45

1/4 COR.

NW1/4NW1/4

SW1/4NW1/4

NW1/4SW1/4

1(S89°34'46"E 2566.72)

2(1283.36)

2(1283.36)

2(N00°20'58"E 1184.87)

NE1/4NW1/4

2(1112.33)

1(S00°00'56"E 2224.66)

2(1112.33)

2(N87°12'06"E 1292.39)

2(N87°12'06"E 1292.39)

S87°47'00"E 78.26

2(N00°20'58"E 1184.87)

SE1/4NW1/4

2(1305.44)

2(1305.43)

N02°35'00"E 86.20

N05°15'30"E 302.40

N04°22'30"E 558.00

N03°56'44"E 317.15

N01°57'00"W 138.22

N89°06'20"E 296.85

S87°30'00"E 280.00

S88°00'00"E 400.00

BETWEEN PINS
S88°12'30"E 1430.00

POINT BEING 179.52' SOUTH AND
1270.55' WEST OF THE E1/4
CORNER OF SECTION 11.

NE1/4SE1/4



Scale 1"=300'

BASIS OF BEARINGS

SURVEY NO. 1411

LEGEND

- Found 2½" aluminum pipe with attached 2½" aluminum cap, see Survey No. 1411.
- Set 5/8"x30" iron pin with attached red plastic cap marked CORNERSTONE SURVEYING, INC.
- X—X Fence Line
- () GLO record bearing and distance.
- 1() Survey No. 1411 record bearing and distance.
- 2() Calculated bearing and distance.

NARRATIVE

This survey was performed at the request of Roy Peterson, on behalf of the Gustav E. Peterson Family Trust and the Ruth L. Peterson Family Trust. The purpose of this survey was to locate and monument the existing fence lines in accordance with the Grant County Circuit Court Judgment and Decree in Case No. 97-07181CV.

A search was made of the available records pertaining to this survey and for certain corners from Grant County Survey No. 1411 which are shown hereon. The existing fence line was located and iron pins were set at the angle points in the fence line. The NW1/4 of Section 12 was not divided on Survey No. 1411. Calculations were made utilizing the data shown on Survey No. 1411 and descriptions were prepared. The landowners intend to exchange deeds to these fence lines in accordance with the Judgment and Decree in Case No. 97-07181CV.

RECEIVED AND FILED
GRANT COUNTY SURVEYOR

FEB 2 1 2011

BY: *[Signature]*

REGISTERED
PROFESSIONAL
LAND SURVEYOR

[Signature]
OREGON
SEPT 19, 1995
JACK L. WATSON
2734

Renewal Date 6/30/2012



CORNERSTONE SURVEYING, Inc.
233 S. Canyon Blvd., John Day, Oregon 97845
(541) 575-1813

MAP OF SURVEY
SITUATED IN SECTION 11 AND 12
T8S, R27E, W.M.
GRANT COUNTY, OREGON

SURVEYED FOR: **Roy Peterson**

SURVEYED BY: **Jack Watson**

SURVEY COMPLETED: 1/17/2011

MAP OF SURVEY NO. 1913