# UPPER DOG CREEK

MAP OF SURVEY No. 192

PORTIONS OF SECTIONS 8&9

Township 14 South Range 32 East Willamette Meridian

GRANT COUNTY OREGON

BEARING BASE FROM SURVEY No. 95

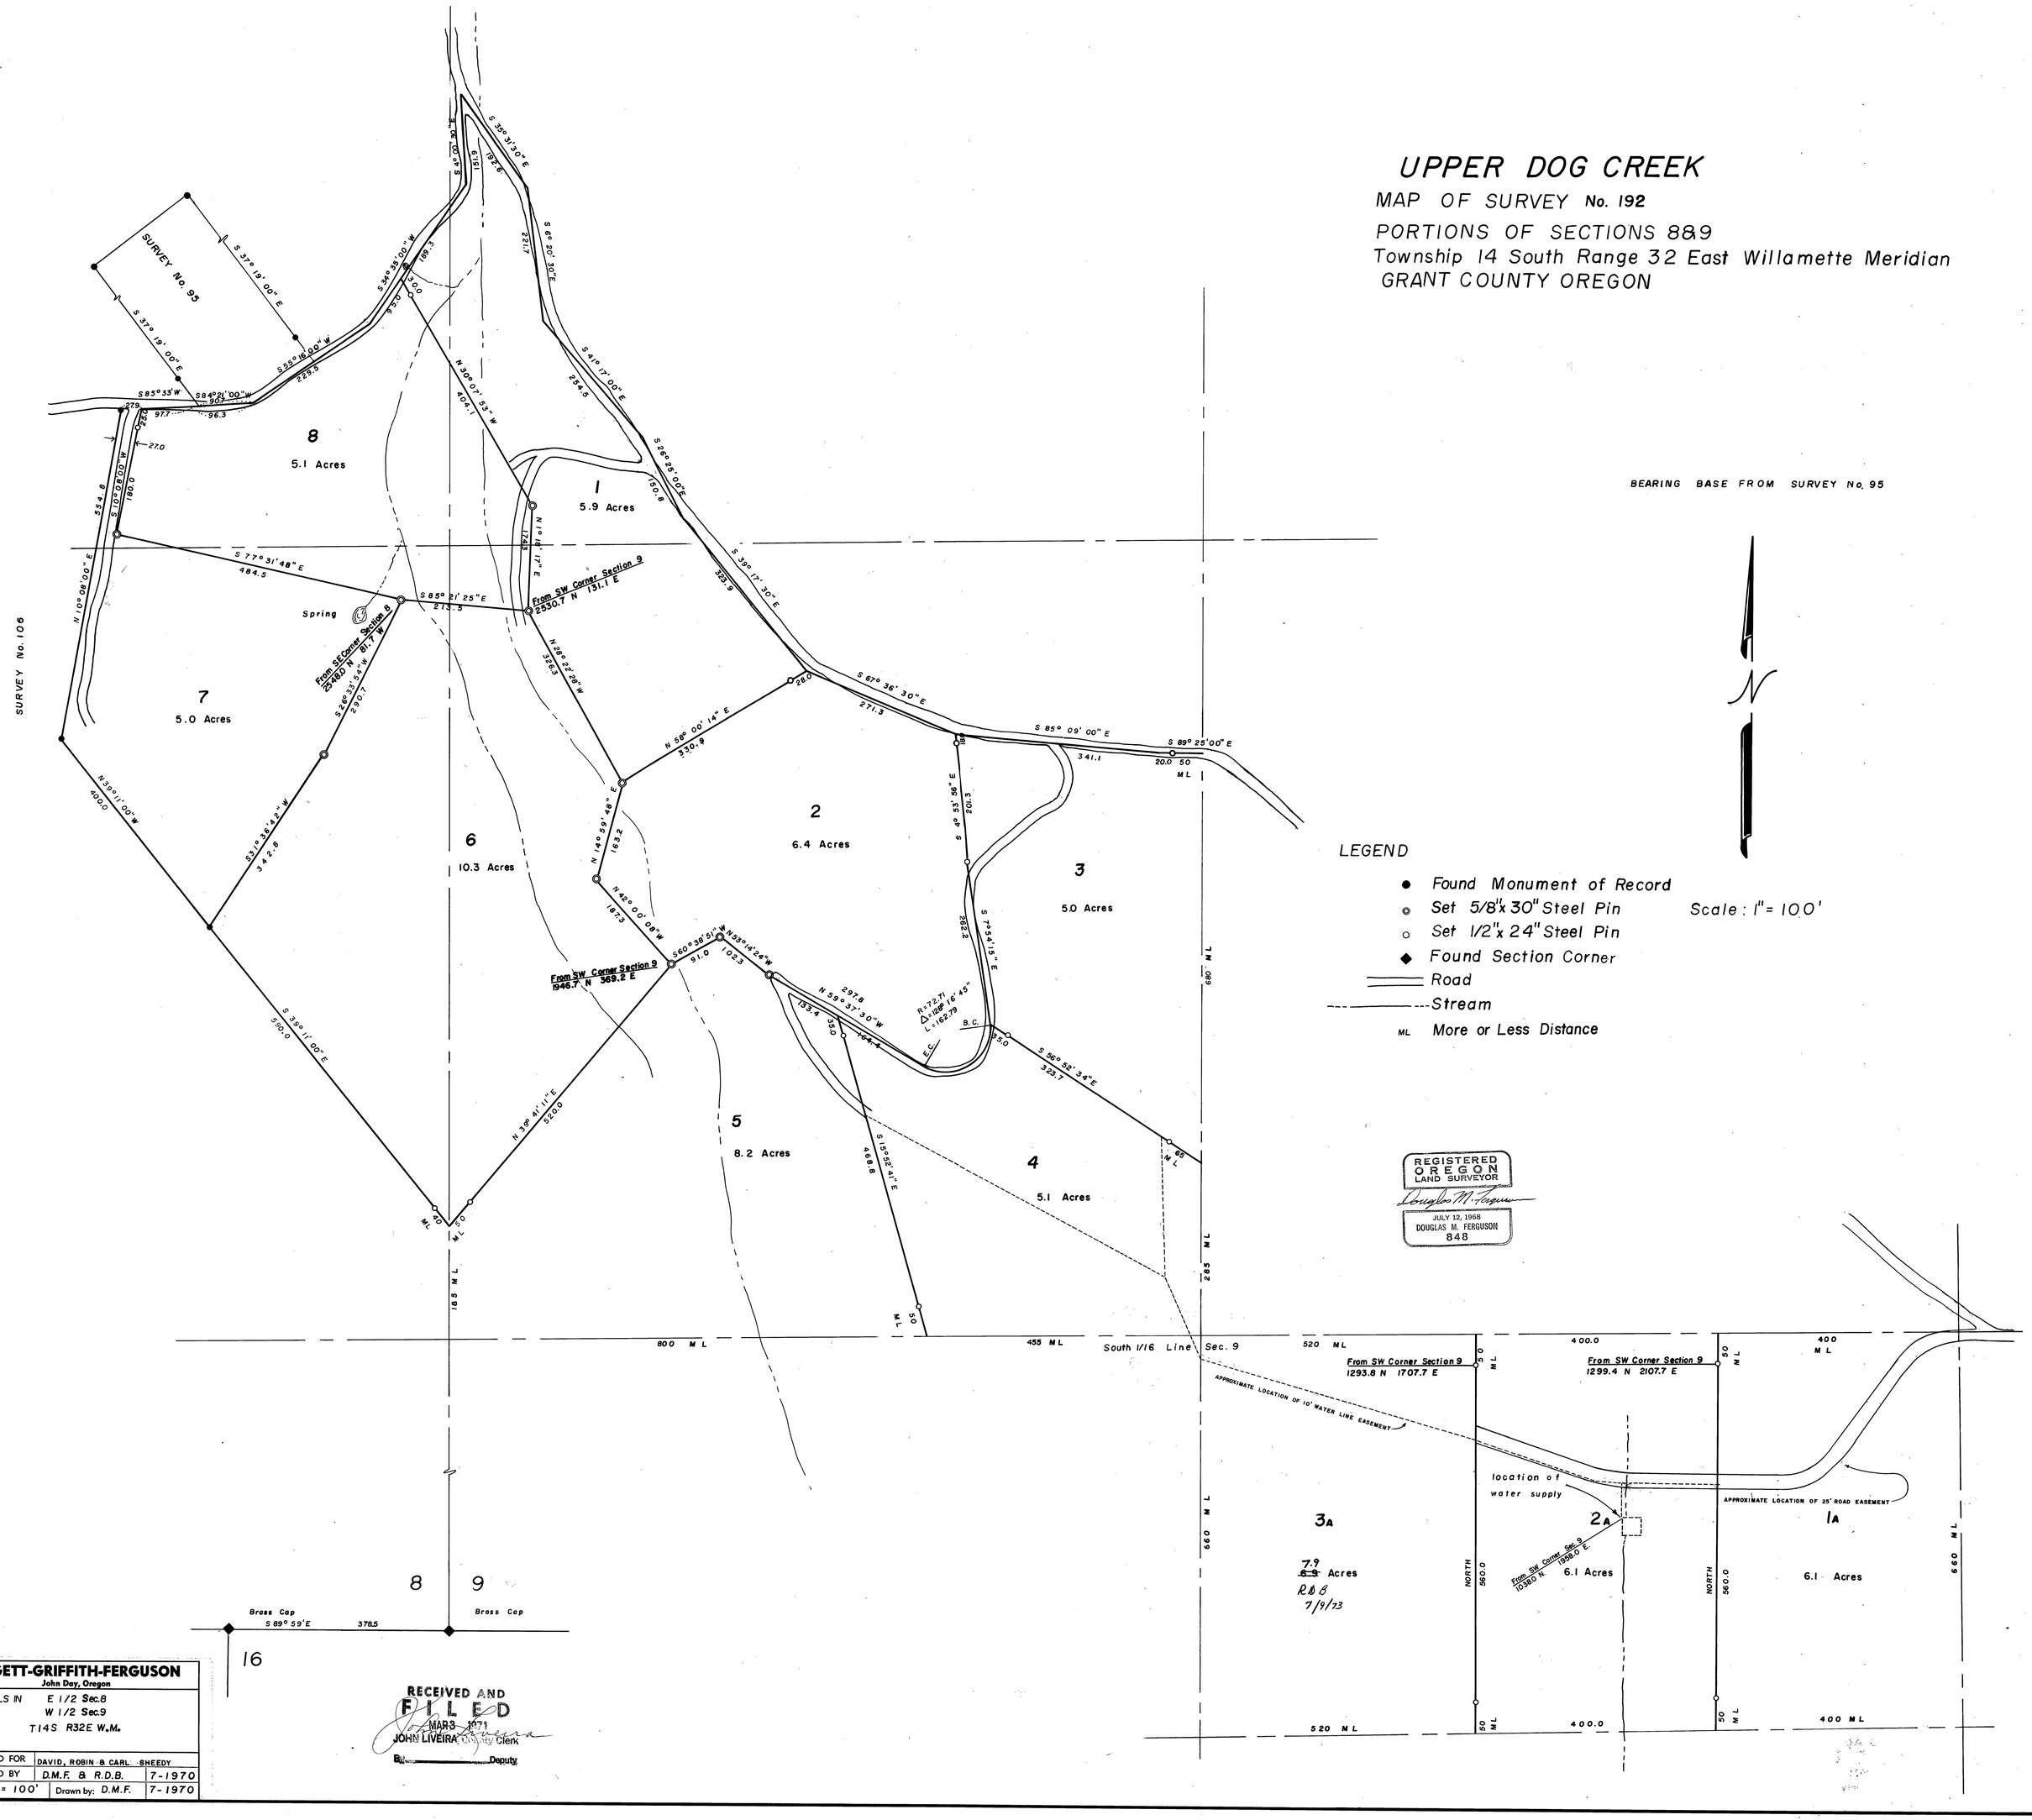


| BAGETT-GRIFFITH-FERGUSON<br>John Day, Oregon | | |
|---|---|---|
| PARCELS IN | E 1/2 Sec.8<br>W 1/2 Sec.9<br>T14S R32E W.M. | |
| SURVEYED FOR | DAVID, ROBIN & CARL SHEEDY | |
| SURVEYED BY | D.M.F. & R.D.B. | 7-1970 |
| Scale: 1"= 100' | Drawn by: D.M.F. | 7-1970 |

RECEIVED AND FILED
MAR 3 1971
JOHN LIVEIRA County Clerk
By _____ Deputy

#192