


COUNTY SURVEYOR'S NARRATIVE

THIS MAP IS FILED FOR THE RECORD, DURING THE COURSE OF RESEARCHING RECORDS AT THE GRANT COUNTY ROAD DEPARTMENT, JASON HATFIELD, PLS, LOCATED THIS SET OF UNRECORDED MAPS, WHICH WAS PREPARED BY JIM HANLEY, PLS.


THE MAPS HAVE BEEN SCANNED AND ARE IN THEIR ORIGINAL CONDITION OTHER THAN THIS NARRATIVE AND THE SHEET NUMBER AND MAP OF SURVEY NUMBER IN THE LOWER RIGHT CORNER.


THE ORIGINAL PAPER COPIES OF THIS MAP WERE RETURNED TO THE GRANT COUNTY ROAD DEPARTMENT.

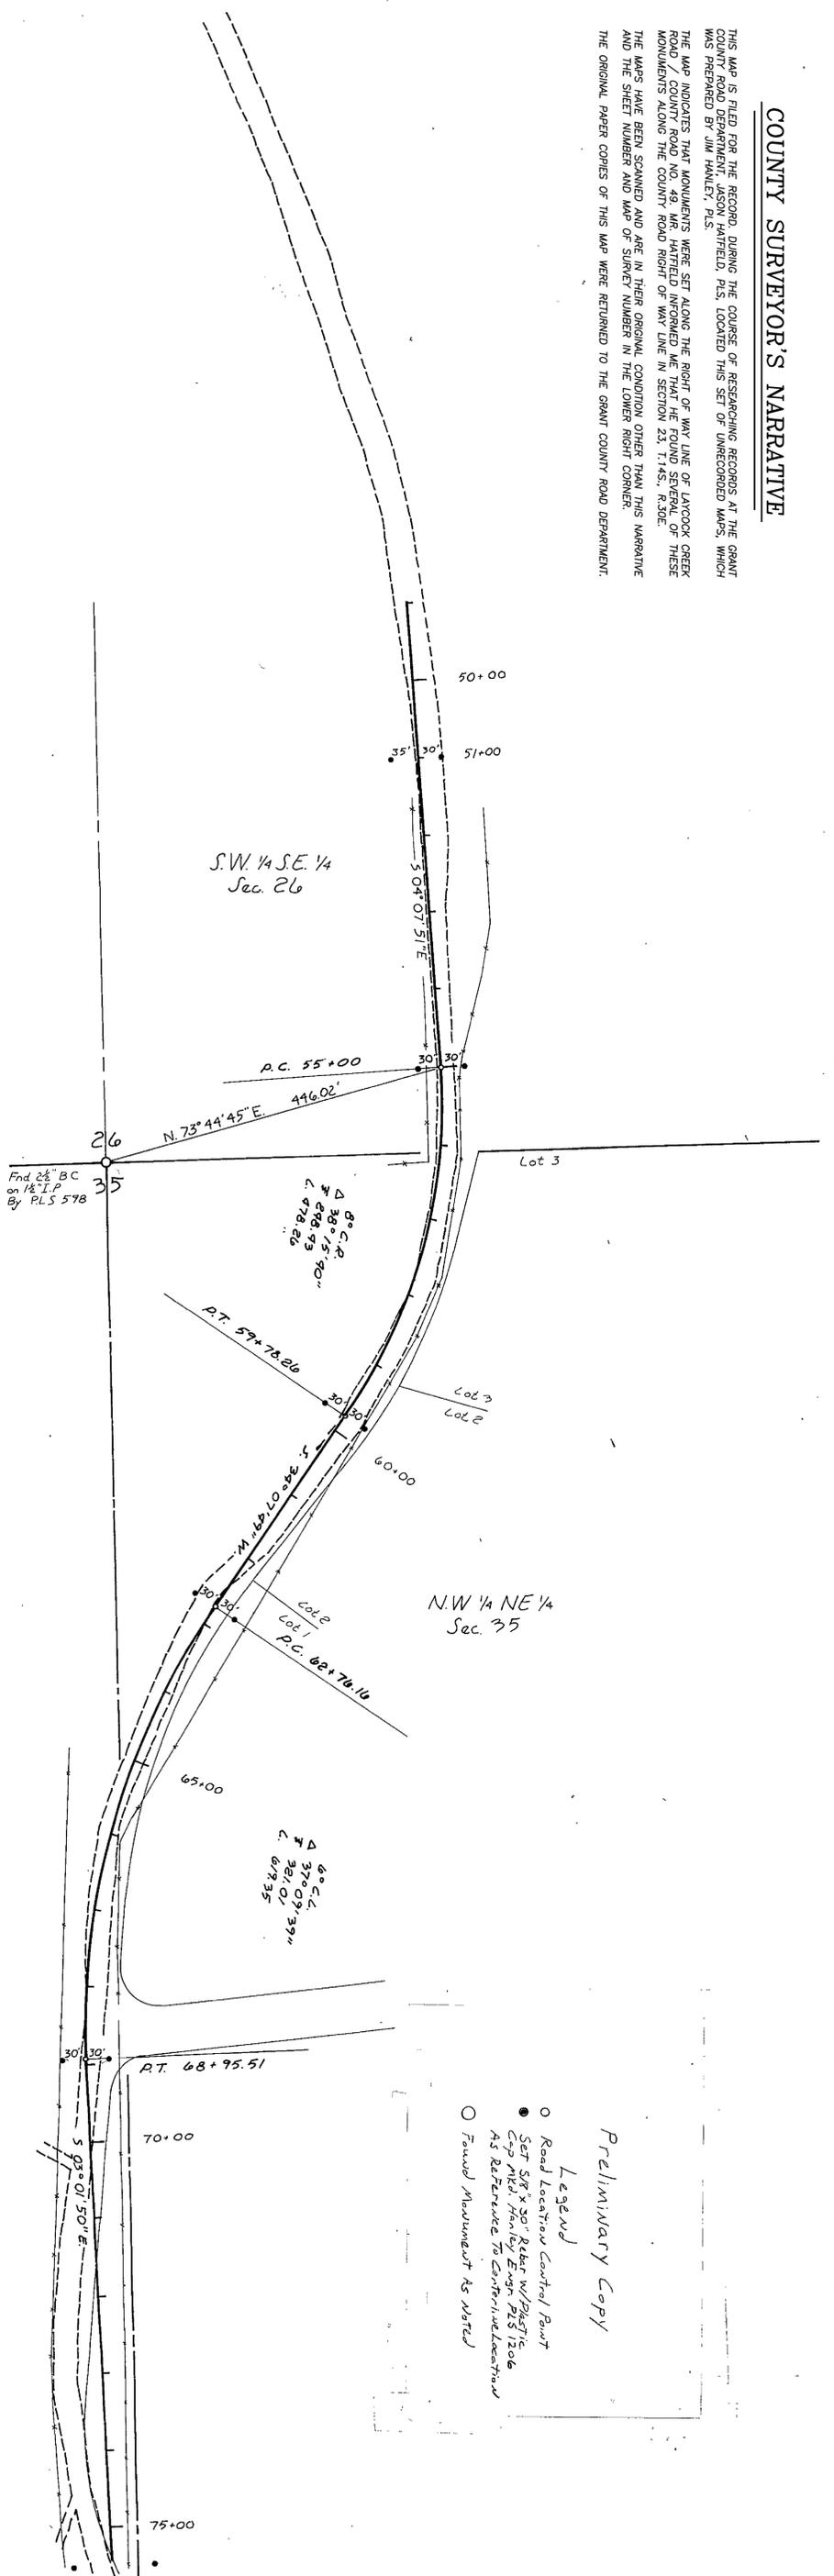

Preliminary Copy

Legend

- Road Location Control Point
- 45 REFERENCE TO CENTERLINE LOCATIONS
- FOUND MONUMENT AS NOTED

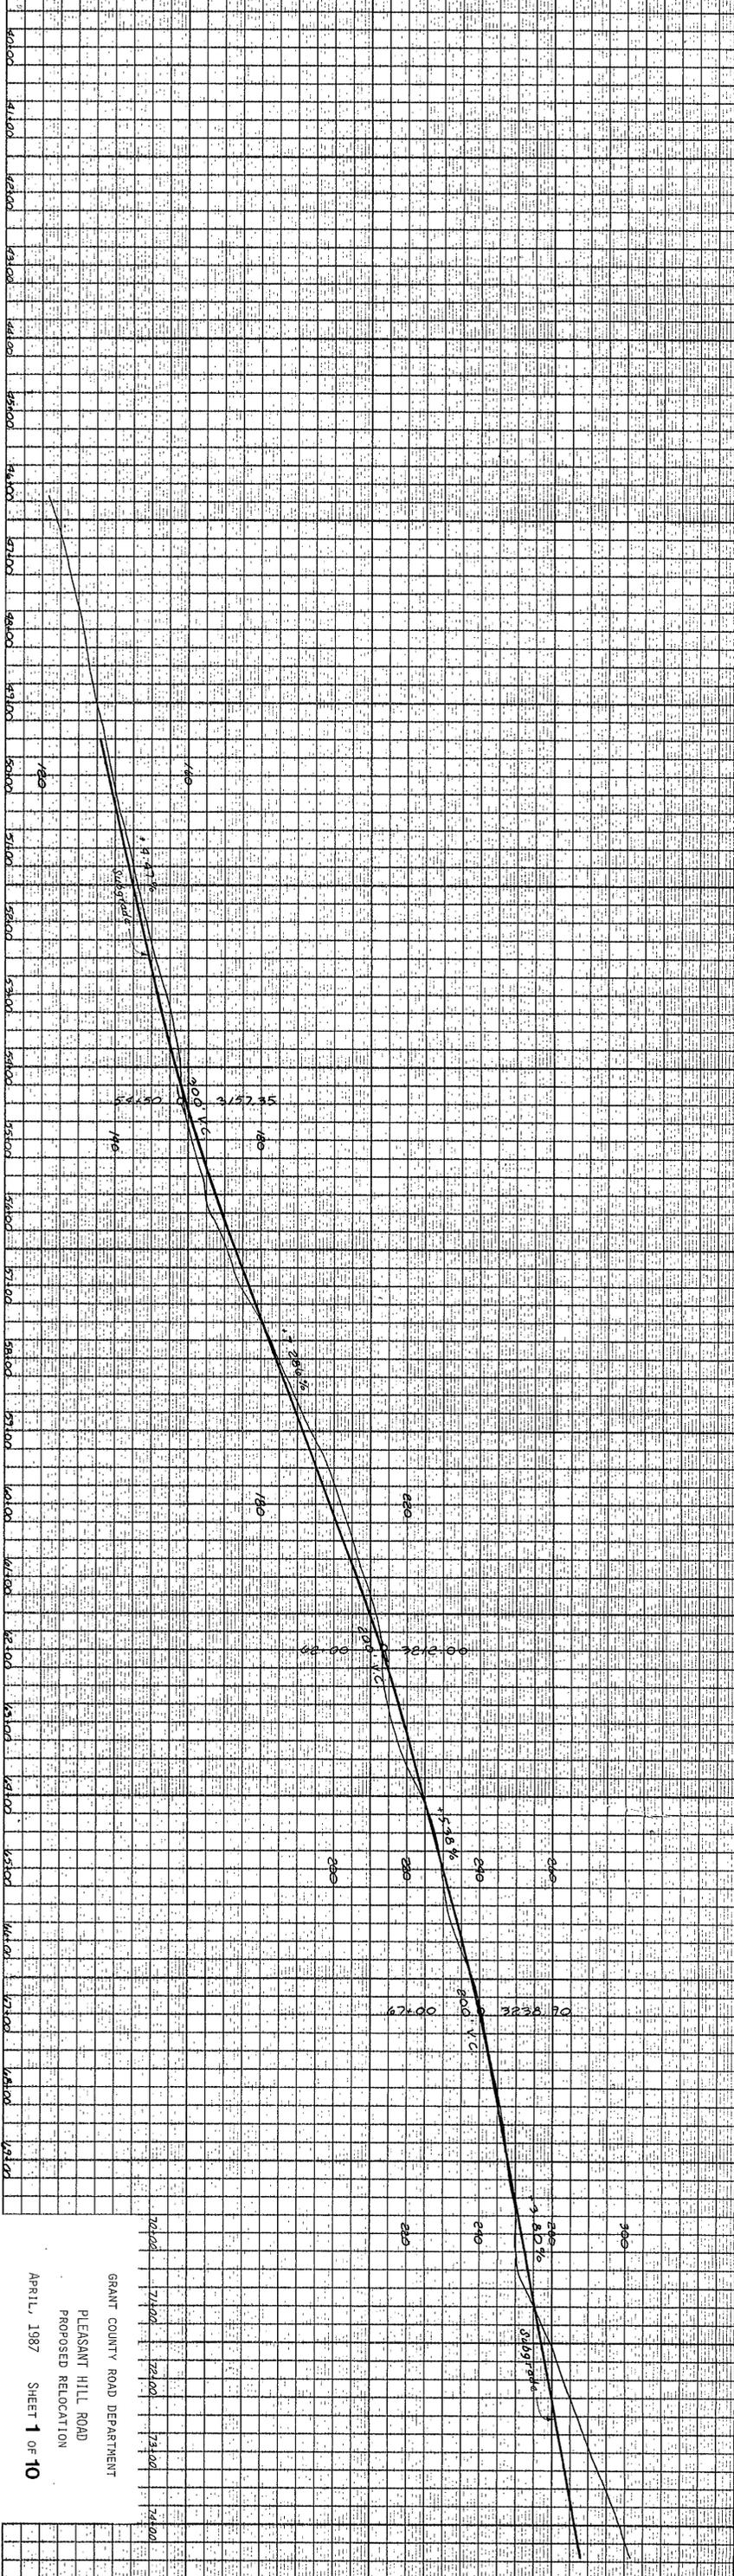

GRANT COUNTY ROAD DEPARTMENT
 PLEASANT HILL ROAD
 PROPOSED RELOCATION
 APRIL, 1987 SHEET 1 OF 10