

Map of Survey # 193

|                                        |                  |                 |
|----------------------------------------|------------------|-----------------|
| Scale: 1"=600'                         | Drawn by: T.O.G. | DATE: JUNE-1970 |
| SURVEYED BY: J.I.G. and D.M.F.         |                  |                 |
| SURVEYED FOR: MALLHEUR NATIONAL FOREST |                  |                 |
| Grant County, Oregon                   |                  |                 |
| FOX VALLEY CADASTRAL                   |                  |                 |
| BAGGETT-GRIFFITH-FERGUSON              |                  |                 |

**HISTORY OF SURVEYS**

T115 R29E  


**LEGEND**

- Found Monuments of Record
- Found original corner, replaced with brass cap on a 2 1/2" x 30" iron post
- Found original corner, replaced with brass cap on a 1 1/2" x 30" iron post
- Set, Brass Cap on a 2 1/2" x 30" iron post
- Set, Brass Cap on a 1 1/2" x 30" iron post
- Record Bearing and distance
- Old line fences considered in this survey
- Steel fence posts set on line
- USFS National Forest land
- Pvt Private owned land




**CERTIFICATION**

I, Duane I. Griffith, do hereby certify that during the summer of 1970, the area herein shown was surveyed under my direct supervision in accordance with the public land laws and under instructions of the Malheur National Forest Supervisor and from the B.L.M. Manual and the Oregon State Land Surveying Manual. Brass caps set, and staked with Grant County Surveyors' data.

U.S. 644, one with proper nomenclature as prescribed in the B.L.M. Manual.

*Duane I. Griffith*  
GRANT COUNTY SURVEYOR

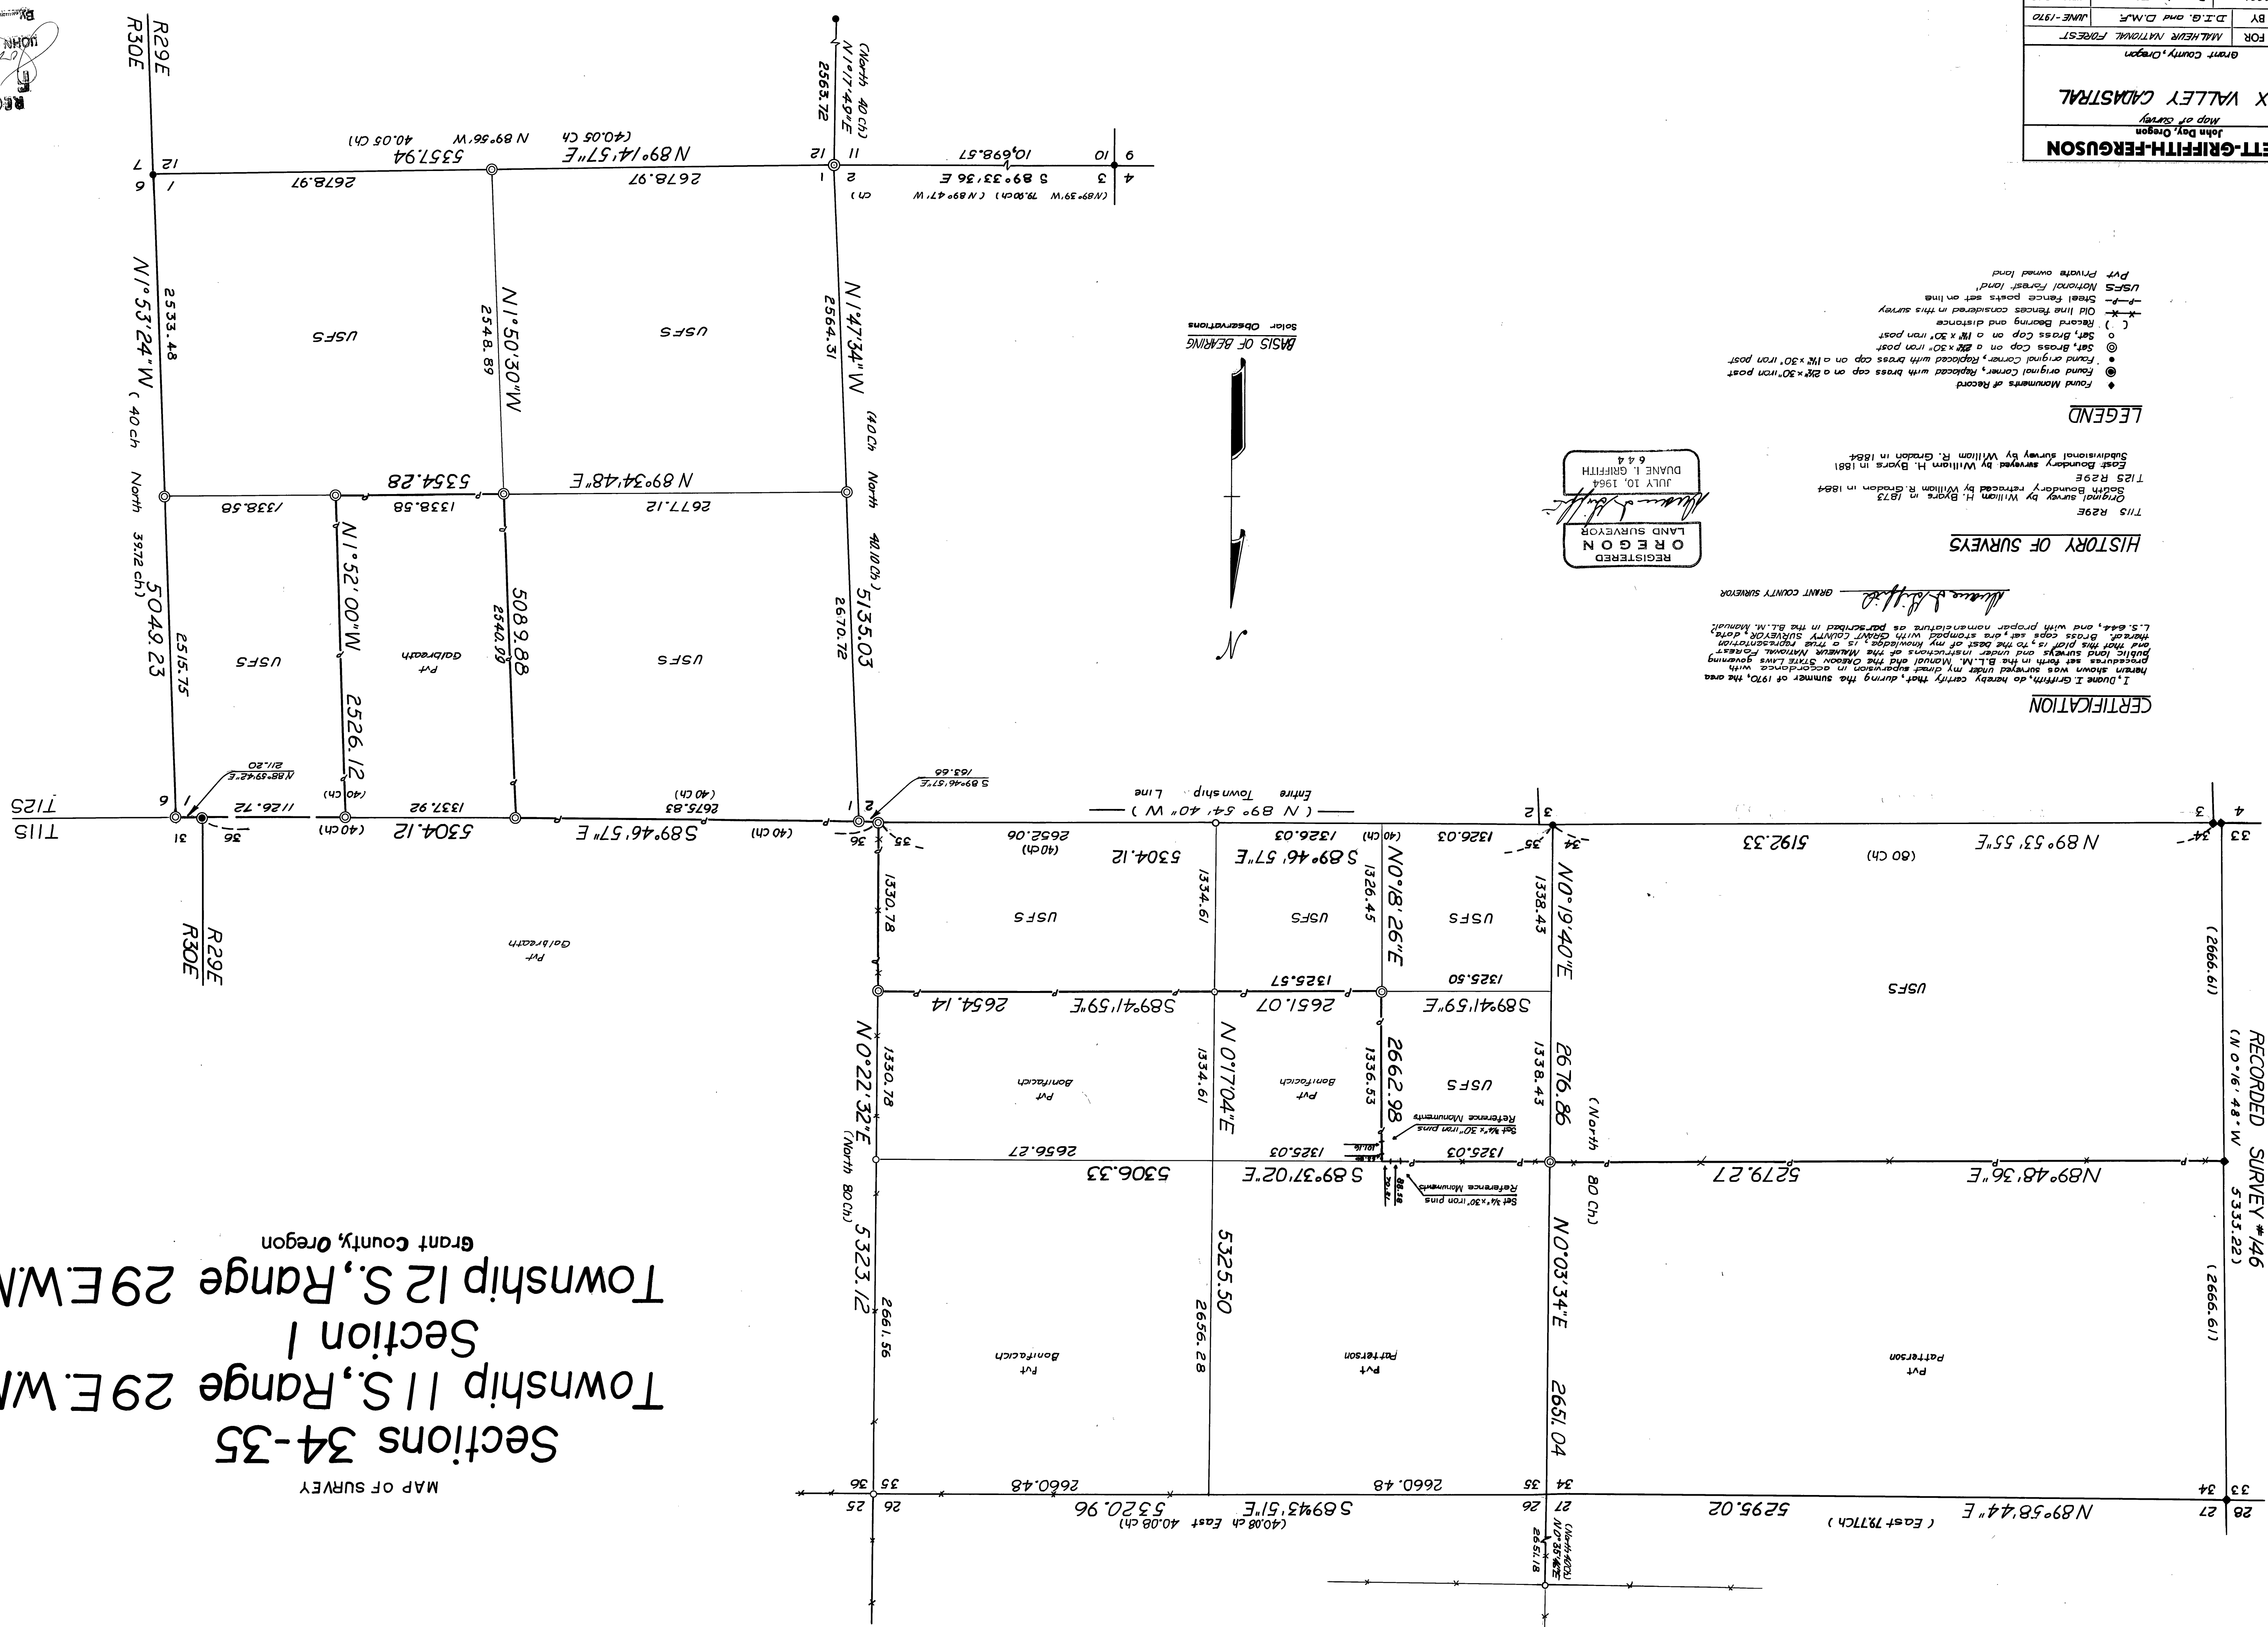

MAP OF SURVEY

Sections 34-35

Township 11 S, Range 29 E, W.M.

Section 1

Township 12 S, Range 29 E, W.M.

Grant County, Oregon

RECEIVED AND  
FILED  
JUL 14 1970  
JOHN L. VANCE, JR., CLERK