

Scale 1"=200'

BASIS OF BEARINGS

Survey No. 1151


LEGEND

- Found 2" aluminum pipe with attached 2 1/2" aluminum cap, see Survey No. 1151.
- Set 5/8"x30" iron pin with attached 2" aluminum cap marked CORNERSTONE SURVEYING, INC. and appropriate corner markings.
- X—X Fence Line
- () Survey No. 1151 record bearing and distance.

NARRATIVE

This survey was performed at the request of Allen Piquet. The purpose of this survey was to establish the NE corner of Mr. Piquet's property as described in Instrument No. 20110233, deeds of Grant County, Oregon.

A search was made of the available records pertaining to this survey. Field measurements were made to locate the existing monuments shown and the fence line. I accept the found monuments and establish the NE corner of Mr. Piquet's property at the CE1/16 corner, on line and at the mid-point between the C1/4 corner and the E1/4 corner of Section 15.

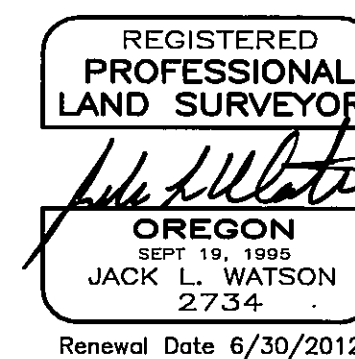

CORNERSTONE SURVEYING, Inc.
233 S. Canyon Blvd., John Day, Oregon 97845
(541) 575-1813

MAP OF SURVEY
SITUATED IN THE SE1/4 OF SECTION 15
T9S, R31E, W.M.
GRANT COUNTY, OREGON

SURVEYED FOR: **Allen Piquet**

SURVEYED BY: Jack Watson

SURVEY COMPLETED: 9/21/2011

RECEIVED AND FILED
GRANT COUNTY SURVEYOR

OCT 21 2011

BY: