

N.E. 1/4 SEC. 27 and N.W. 1/4 SEC. 26, T. 13 S., R. 30 E., W.M.

SET AND RECOVERED MONUMENT LIST

PT. NO.	LDP NORTHING	LDP EASTING	STATION & ALIGNMENT	OFFSET	DATE	DESCRIPTION & REFERENCE DOCUMENTS
NET 1	276293.368	8573403.753	87+21.96 HWY 395	21.55' Lt.	6/20/2012	FOUND 5/8" IRON ROD WITH 1 1/2" DIA. ALUMINUM CAP, STAMPED "APA OR 2537 WA 35140 NET 1", FLUSH WITH THE GROUND
NET 2	276239.960	8573405.910	87+53.03 HWY 395	21.98' Rt.	6/20/2012	FOUND 5/8" IRON ROD WITH 1 1/2" DIA. ALUMINUM CAP, STAMPED "APA OR 2537 WA 35140 NET 2", BURIED 4" BELOW GROUND
NET 3	275551.071	8575365.960	108+48.54 HWY 395	25.07' Rt.	6/20/2012	FOUND 5/8" IRON ROD WITH 1 1/2" DIA. ALUMINUM CAP, STAMPED "APA OR 2537 WA 35140 NET 3", BURIED 3" BELOW GROUND
NET 4	275606.728	8575354.233	108+30.07 HWY 395	29.60' Lt.	6/20/2012	FOUND 5/8" IRON ROD WITH 1 1/2" DIA. ALUMINUM CAP, STAMPED "APA OR 2537 WA 35140 NET 4", BURIED 1" BELOW GROUND
100 RESET	275870.415	8574024.704	94+70.69 HWY 395	28.67' Rt.	6/20/2012	SET 5/8"x30" IRON ROD WITH 1 1/2" DIA. ALUMINUM CAP INSCRIBED "ODOT 2001 100 RESET 2012", FLUSH WITH THE GROUND
101	275604.305	8574808.072	102+90.72 HWY 395	45.65' Rt.	6/20/2012	FOUND 5/8" IRON ROD WITH 1 1/2" DIA. ALUMINUM CAP INSCRIBED "ODOT 2001 101", FLUSH WITH THE GROUND
101	275604.305	8574808.072	12+43.43 HANSEN LANE	6.90' Lt.	6/20/2012	FOUND 5/8" IRON ROD WITH 1 1/2" DIA. ALUMINUM CAP INSCRIBED "ODOT 2001 101", FLUSH WITH THE GROUND
102	275562.152	8574305.225	17+48.60 HANSEN LANE	12.46' Rt.	6/20/2012	FOUND 5/8" IRON ROD WITH 1 1/2" DIA. ALUMINUM CAP INSCRIBED "ODOT 2001 102", FLUSH WITH THE GROUND

RIGHT-OF-WAY POINTS LIST

PT. NO.	LDP NORTHING	LDP EASTING	STATION & ALIGNMENT	OFFSET	DATE	DESCRIPTION
5000	276113.969	8573734.271	91+00 HWY 395	50.00' Lt.	6/20/2012	RIGHT-OF-WAY POINT (FALSE CALL), NO MONUMENT SET
5001	276101.796	8573759.198	91+26.55 HWY 395	52.42' Lt.	6/20/2012	RIGHT-OF-WAY POINT, NO MONUMENT SET
5002	275919.155	8574132.917	95+50 HWY 395	60.00' Lt.	6/20/2012	RIGHT-OF-WAY POINT, NO MONUMENT SET
5003	275785.699	8574501.952	99+50 HWY 395	60.00' Lt.	6/20/2012	RIGHT-OF-WAY POINT, NO MONUMENT SET
5004	275766.510	8574496.310	99+50 HWY 395	40.00' Lt.	6/20/2012	RIGHT-OF-WAY POINT, NO MONUMENT SET
5005	275988.757	8573719.677	91+50 HWY 395	65.00' Rt.	6/20/2012	RIGHT-OF-WAY POINT (FALSE CALL), NO MONUMENT SET
5006	275965.947	8573759.200	91+94.75 HWY 395	65.00' Rt.	6/20/2012	RIGHT-OF-WAY POINT, NO MONUMENT SET
5007	275746.947	8574225.067	97+00 HWY 395	65.00' Rt.	6/20/2012	RIGHT-OF-WAY POINT, NO MONUMENT SET
5008	275685.699	8574201.854	97+00 HWY 395	130.50' Rt.	6/20/2012	RIGHT-OF-WAY POINT, NO MONUMENT SET
5009	275697.619	8574364.456	98+45 HWY 395	65.00' Rt.	6/20/2012	RIGHT-OF-WAY POINT, NO MONUMENT SET
5011	275651.766	8574515.728	100+00 HWY 395	65.00' Rt.	6/20/2012	RIGHT-OF-WAY POINT, NO MONUMENT SET
5012	275618.149	8574521.173	100+13.83 HWY 395	95.97' Rt.	6/20/2012	RIGHT-OF-WAY POINT, NO MONUMENT SET
5013	275602.937	8574523.637	100+20 HWY 395	110.00' Rt.	6/20/2012	RIGHT-OF-WAY POINT (FALSE CALL), NO MONUMENT SET

LEGEND

▲

SET NETWORK POINT

△

FOUND NETWORK POINT

EXISTING RIGHT-OF-WAY

NEW RIGHT-OF-WAY


.....

FALSE CALL LINE

EDGE PAVE. OR CURB

○

RIGHT-OF-WAY POINT NO.

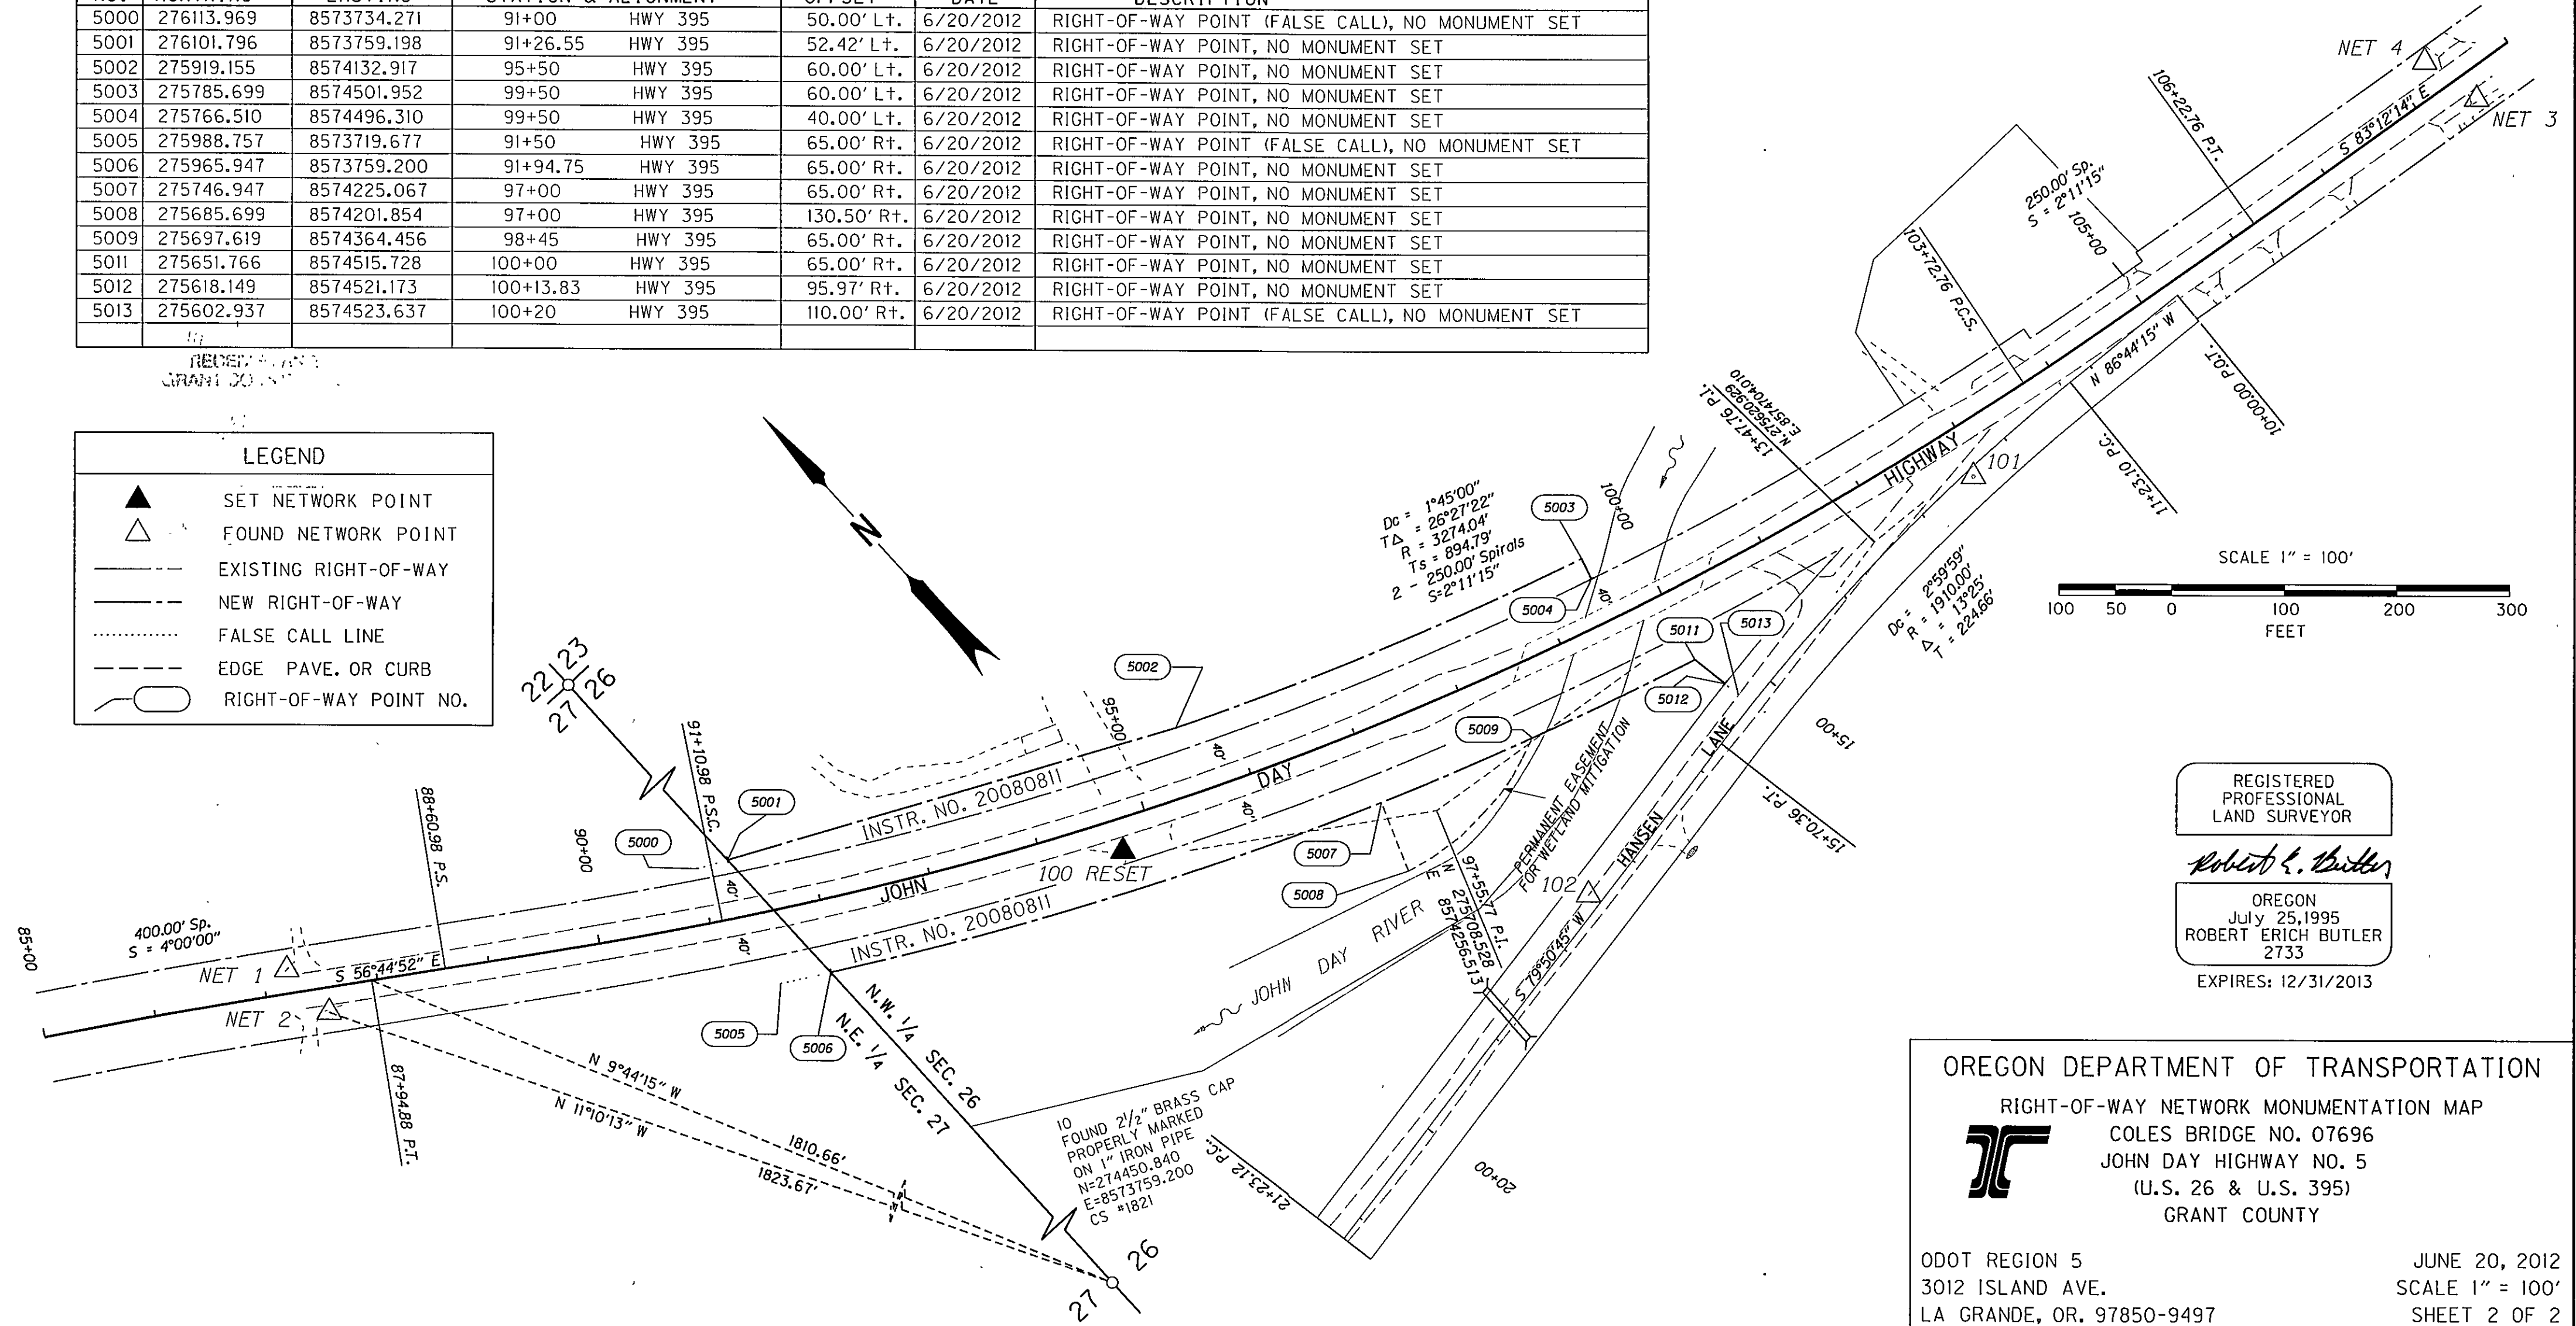

REGISTERED
PROFESSIONAL
LAND SURVEYOR

Robert E. Butler

OREGON
July 25, 1995
ROBERT ERICH BUTLER
2733

EXPIRES: 12/31/2013

OREGON DEPARTMENT OF TRANSPORTATION

RIGHT-OF-WAY NETWORK MONUMENTATION MAP



COLES BRIDGE NO. 07696
JOHN DAY HIGHWAY NO. 5
(U.S. 26 & U.S. 395)
GRANT COUNTY

ODOT REGION 5
3012 ISLAND AVE.
LA GRANDE, OR. 97850-9497

JUNE 20, 2012
SCALE 1" = 100'
SHEET 2 OF 2