


SEC. 30, T. 11 S., R. 26 E., W.M.

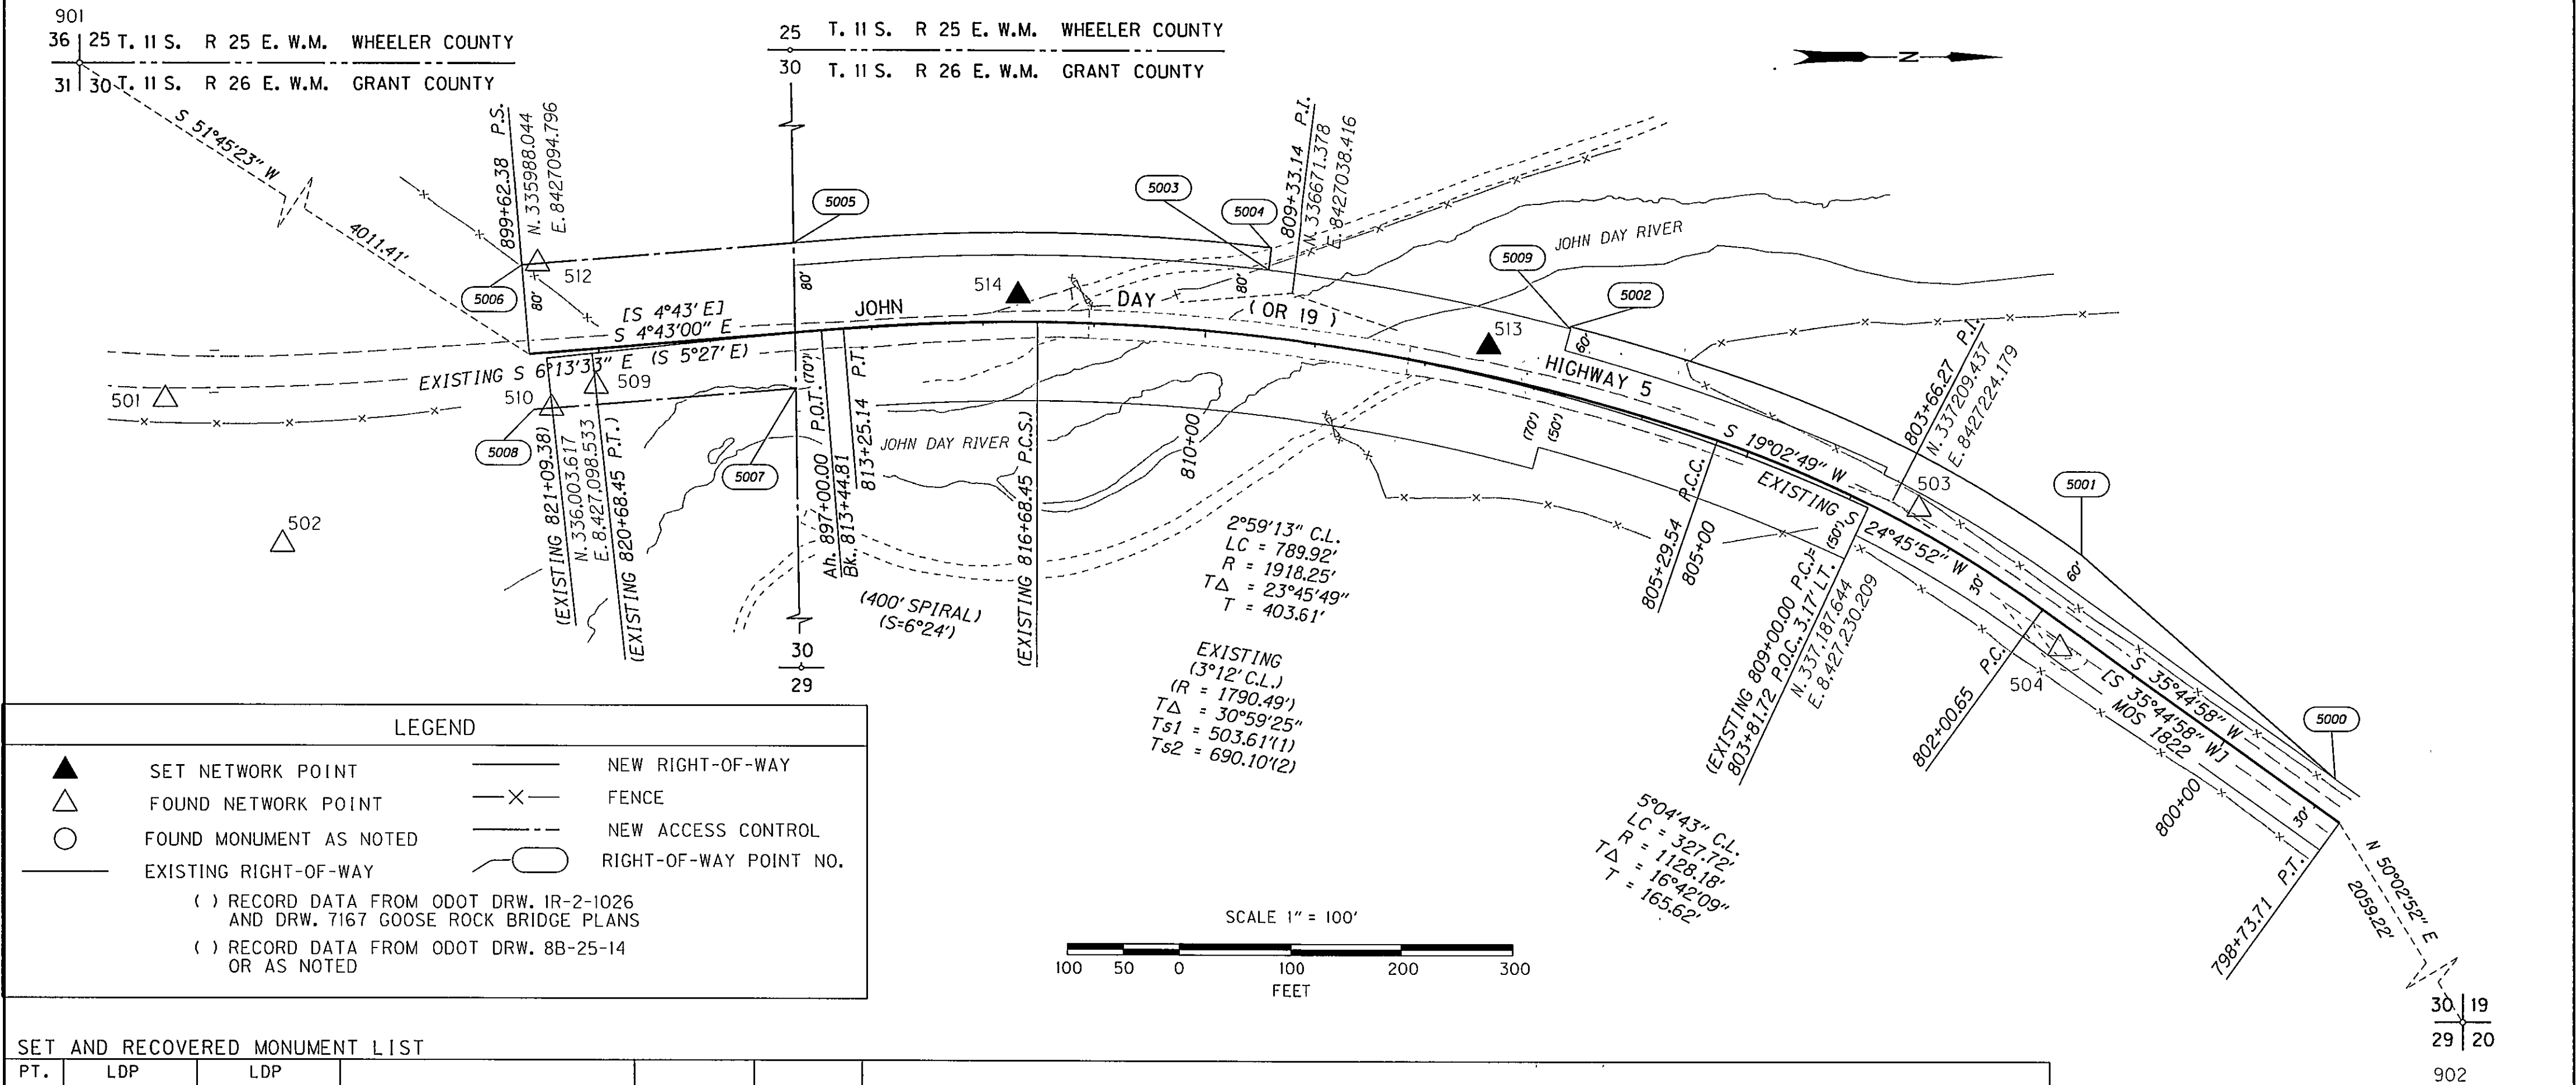

LEGEND

▲ SET NETWORK POINT
△ FOUND NETWORK POINT
○ FOUND MONUMENT AS NOTED
— EXISTING RIGHT-OF-WAY
— NEW RIGHT-OF-WAY
— X — FENCE
- - - NEW ACCESS CONTROL
— RIGHT-OF-WAY POINT NO.

() RECORD DATA FROM ODOT DRW. IR-2-1026 AND DRW. 7167 GOOSE ROCK BRIDGE PLANS
() RECORD DATA FROM ODOT DRW. 8B-25-14 OR AS NOTED

SET AND RECOVERED MONUMENT LIST							
PT. NO.	LDP NORTHING	LDP EASTING	STATION & ALIGNMENT		OFFSET	DATE	DESCRIPTION & REFERENCE DOCUMENTS
501	335662.942	8427136.139	N/A	OR 19	N/A	6/20/2012	FOUND 5/8" IRON ROD WITH 2" DIA. ALUMINUM CAP STAMPED "NET 1 APA OR2537 WA35140", WITH CARSONITE POST
502	335767.666	8427265.559	N/A	OR 19	N/A	6/20/2012	FOUND 5/8" IRON ROD WITH 2" DIA. ALUMINUM CAP STAMPED "NET 2 APA OR2537 WA35140", WITH CARSONITE POST
503	337233.295	8427231.400	803+40.95	OR 19	16.92 Rt.	6/20/2012	FOUND 5/8" IRON ROD WITH 2" DIA. ALUMINUM CAP STAMPED "NET 3 APA OR2537 WA35140", WITH CARSONITE POST
504	337359.333	8427355.837	801+67.72	OR 19	19.28 Lt.	6/20/2012	FOUND 5/8" IRON ROD WITH RED PLASTIC CAP, STAMPED "OTAK CONTROL"
509	336047.885	8427123.323	869+05.09	OR 19	33.35 Lt.	6/20/2012	FOUND 3" DIA. BRASS CAP STAMPED "STATE HIGHWAY DEPARTMENT, BM, NO, ELEVATION, FEET", 18" OF CONCRETE, 8" ABOVE GROUND
510	336007.972	8427143.264		OR 19	49.94 Lt.	6/20/2012	FOUND 5/8" IRON ROD, BENT TO THE SOUTH, TIE IN TO POINT USING ORIGINAL HOLE
512	335995.381	8427013.924	869+48.42	OR 19	79.99 Rt.	6/20/2012	FOUND 5/8" IRON ROD
513	336848.605	8427086.106	807+47.65	OR 19	25.31 Rt.	6/20/2012	SET 5/8"x30" IRON ROD WITH 1 1/2" DIA. ALUMINUM CAP STAMP "ODOT, 513, 2012"
514	336425.680	8427041.670	811+68.41	OR 19	23.44 Rt.	6/20/2012	SET 5/8"x30" IRON ROD WITH 1 1/2" DIA. ALUMINUM CAP STAMP "ODOT, 514, 2012"
901	333504.950	8423944.290	N/A	OR 19	N/A	6/20/2012	FOUND 60D NAIL IN MOUND OF STONE, 13' WEST OF NORTH-SOUTH FENCE IN OPEN SADDLE OF RIDGE RUNNING EAST-WEST, NO VISIBLE MARKINGS ON STONES CS*716
902	338931.505	8429090.510	N/A	OR 19	N/A	6/20/2012	FOUND 1 INCH IRON PIPE WITH 3 INCH BRASS CAP PROPERLY MARKED BY GRANT COUNTY SURVEYOR 1979, GRANT C.S NO. 571

RIGHT-OF-WAY POINTS LIST							
PT. NO.	LDP NORTHING	LDP EASTING	STATION & ALIGNMENT		OFFSET	DATE	DESCRIPTION
5000	337605.377	8427472.246	799+00.00	OR 19	30.00' Rt.	6/20/2012	RIGHT-OF-WAY POINT, NO MONUMENT SET
5001	337378.904	8427272.246	802+00.65	OR 19	60.00' Rt.	6/20/2012	RIGHT-OF-WAY POINT, NO MONUMENT SET
5002	336921.573	8427067.960	806+82.39	OR 19	60.00' Rt.	6/20/2012	RIGHT-OF-WAY POINT, NO MONUMENT SET
5003	336650.420	8427017.778	809+50.00	OR 19	60.00' Rt.	6/20/2012	RIGHT-OF-WAY POINT, NO MONUMENT SET
5004	336652.680	8426997.907	809+50.00	OR 19	80.00' Rt.	6/20/2012	RIGHT-OF-WAY POINT, NO MONUMENT SET
5005	336224.442	8426995.019	867+18.58	OR 19	80.00' Rt.	6/20/2012	RIGHT-OF-WAY POINT, NO MONUMENT SET
5006	335981.466	8427015.067	869+62.38	OR 19	80.00' Rt.	6/20/2012	RIGHT-OF-WAY POINT, NO MONUMENT SET
5007	336226.652	8427125.279	867+27.09	OR 19	50.00' Lt.	6/20/2012	RIGHT-OF-WAY POINT, NO MONUMENT SET
5008	335992.155	8427144.627	869+62.38	OR 19	50.00' Lt.	6/20/2012	RIGHT-OF-WAY POINT, NO MONUMENT SET
5009	336921.092	8427069.823	806+82.39	OR 19	58.08' Rt.	6/20/2012	RIGHT-OF-WAY POINT, NO MONUMENT SET

RECEIVED AND FILED
GRANT COUNTY SURVEYOR

SEP 18 2012

BY *[Signature]*

OREGON DEPARTMENT OF TRANSPORTATION

RIGHT-OF-WAY NETWORK MONUMENTATION MAP
GOOSE ROCK BRIDGE NO. 02655
JOHN DAY HIGHWAY NO. 5
(OR 19)
GRANT COUNTY

ODOT REGION 5
3012 ISLAND AVE.
LA GRANDE, OR. 97850-9497

JUNE 20, 2012
SHEET 2 OF 2

REGISTERED
PROFESSIONAL
LAND SURVEYOR

Robert E. Butler

OREGON
July 25, 1995
ROBERT ERICH BUTLER
2733

EXPIRES: 12/31/2013