
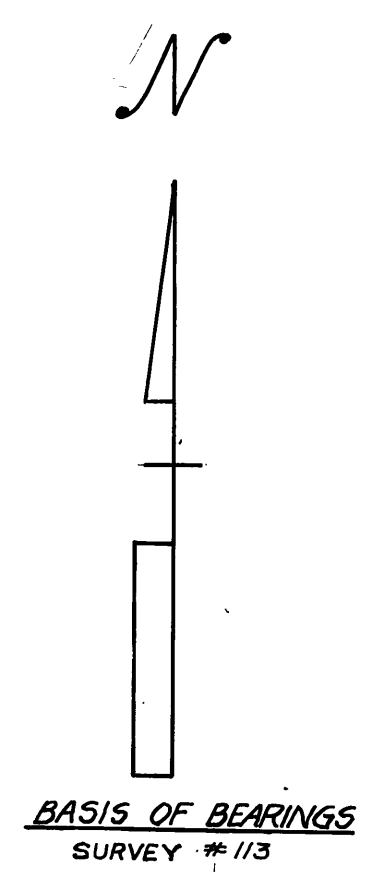


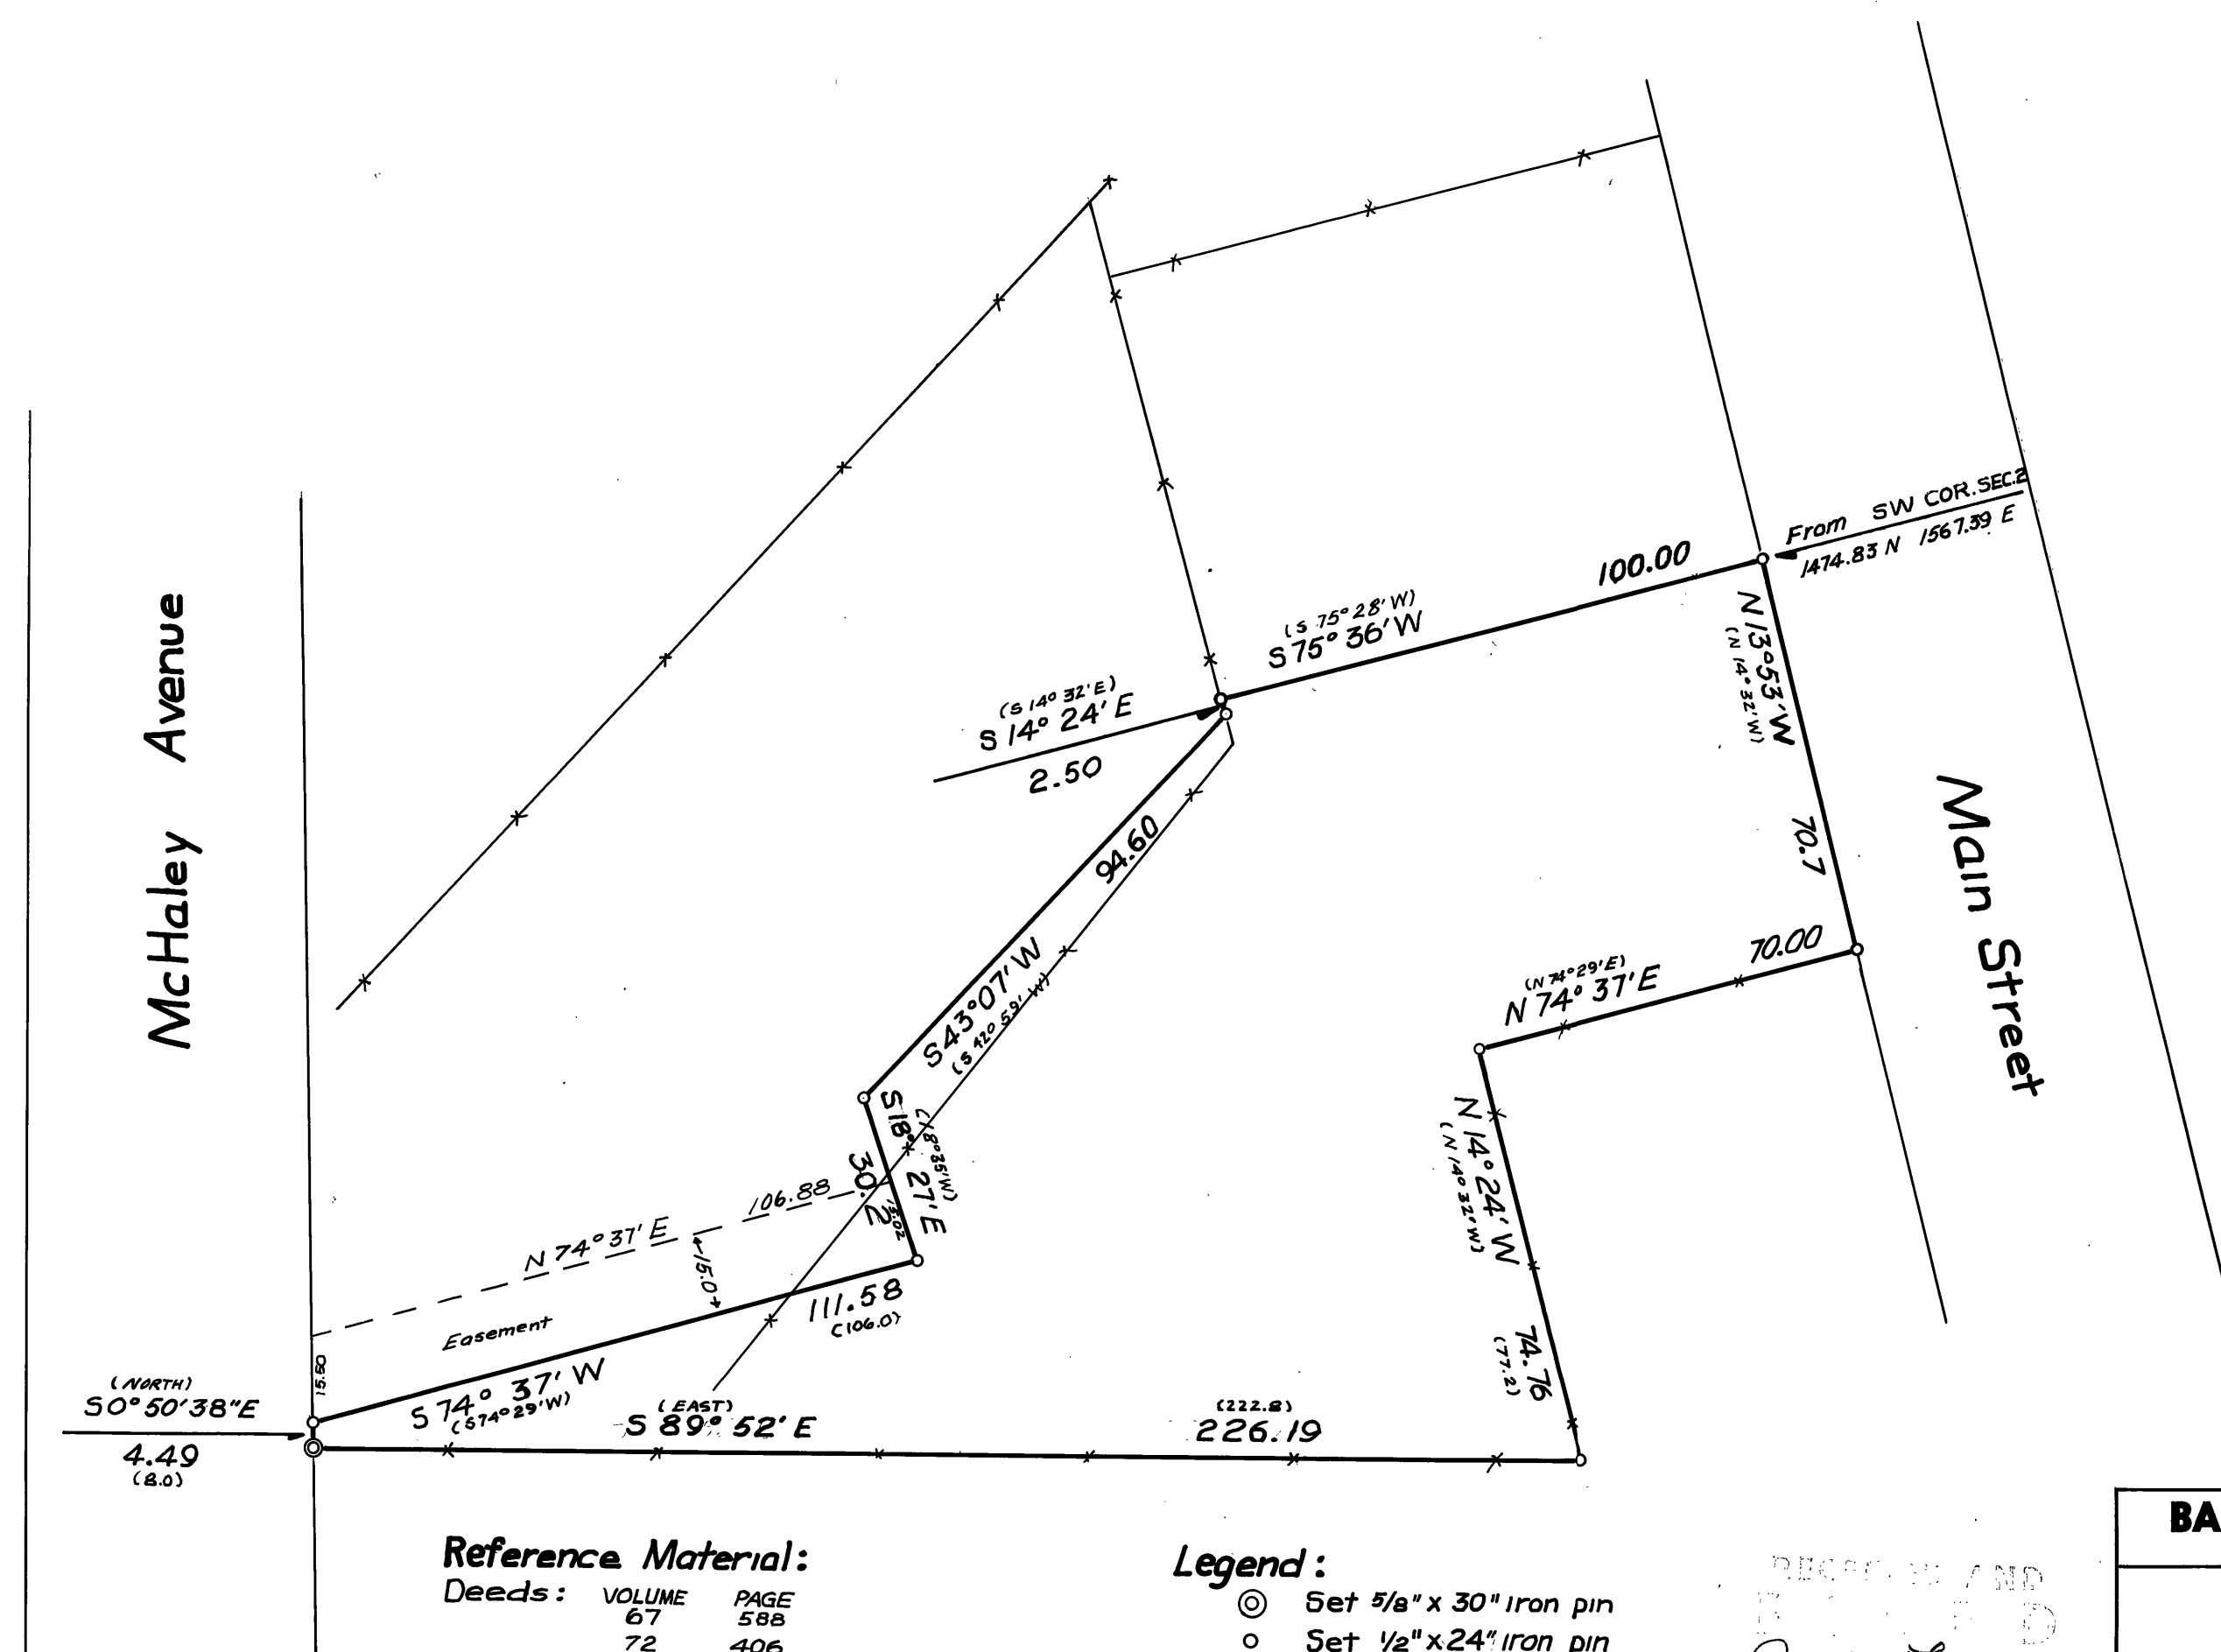

REGISTERED
OREGON
LAND SURVEYOR

Duane I. Griffith

JULY 10, 1964
DUANE I. GRIFFITH
644

Reference Material:

Deeds: VOLUME PAGE

67 588

72 406

79 233

87 566

Map of Survey # 113

Legend:

⊙ Set 5/8" x 30" Iron pin

○ Set 1/2" x 24" Iron pin

— Fences

() Record Bearing & Distance

RECORDED AND
INDEXED

John D. ...

BAGETT-GRIFFITH-FERGUSON		
John Day, Oregon		
MAP OF SURVEY		
Parcel in the NW 1/4 of		
Section 2 T13S R33E W.M.		
PRAIRIE CITY Grant County, Oregon		
SURVEYED FOR	LEWIS SMITH	
SURVEYED BY	D.I.G.	Aug.-1970
Scale: 1" = 30'	Drawn by: T.D.G.	Aug.-1970

Map of Survey # 197