


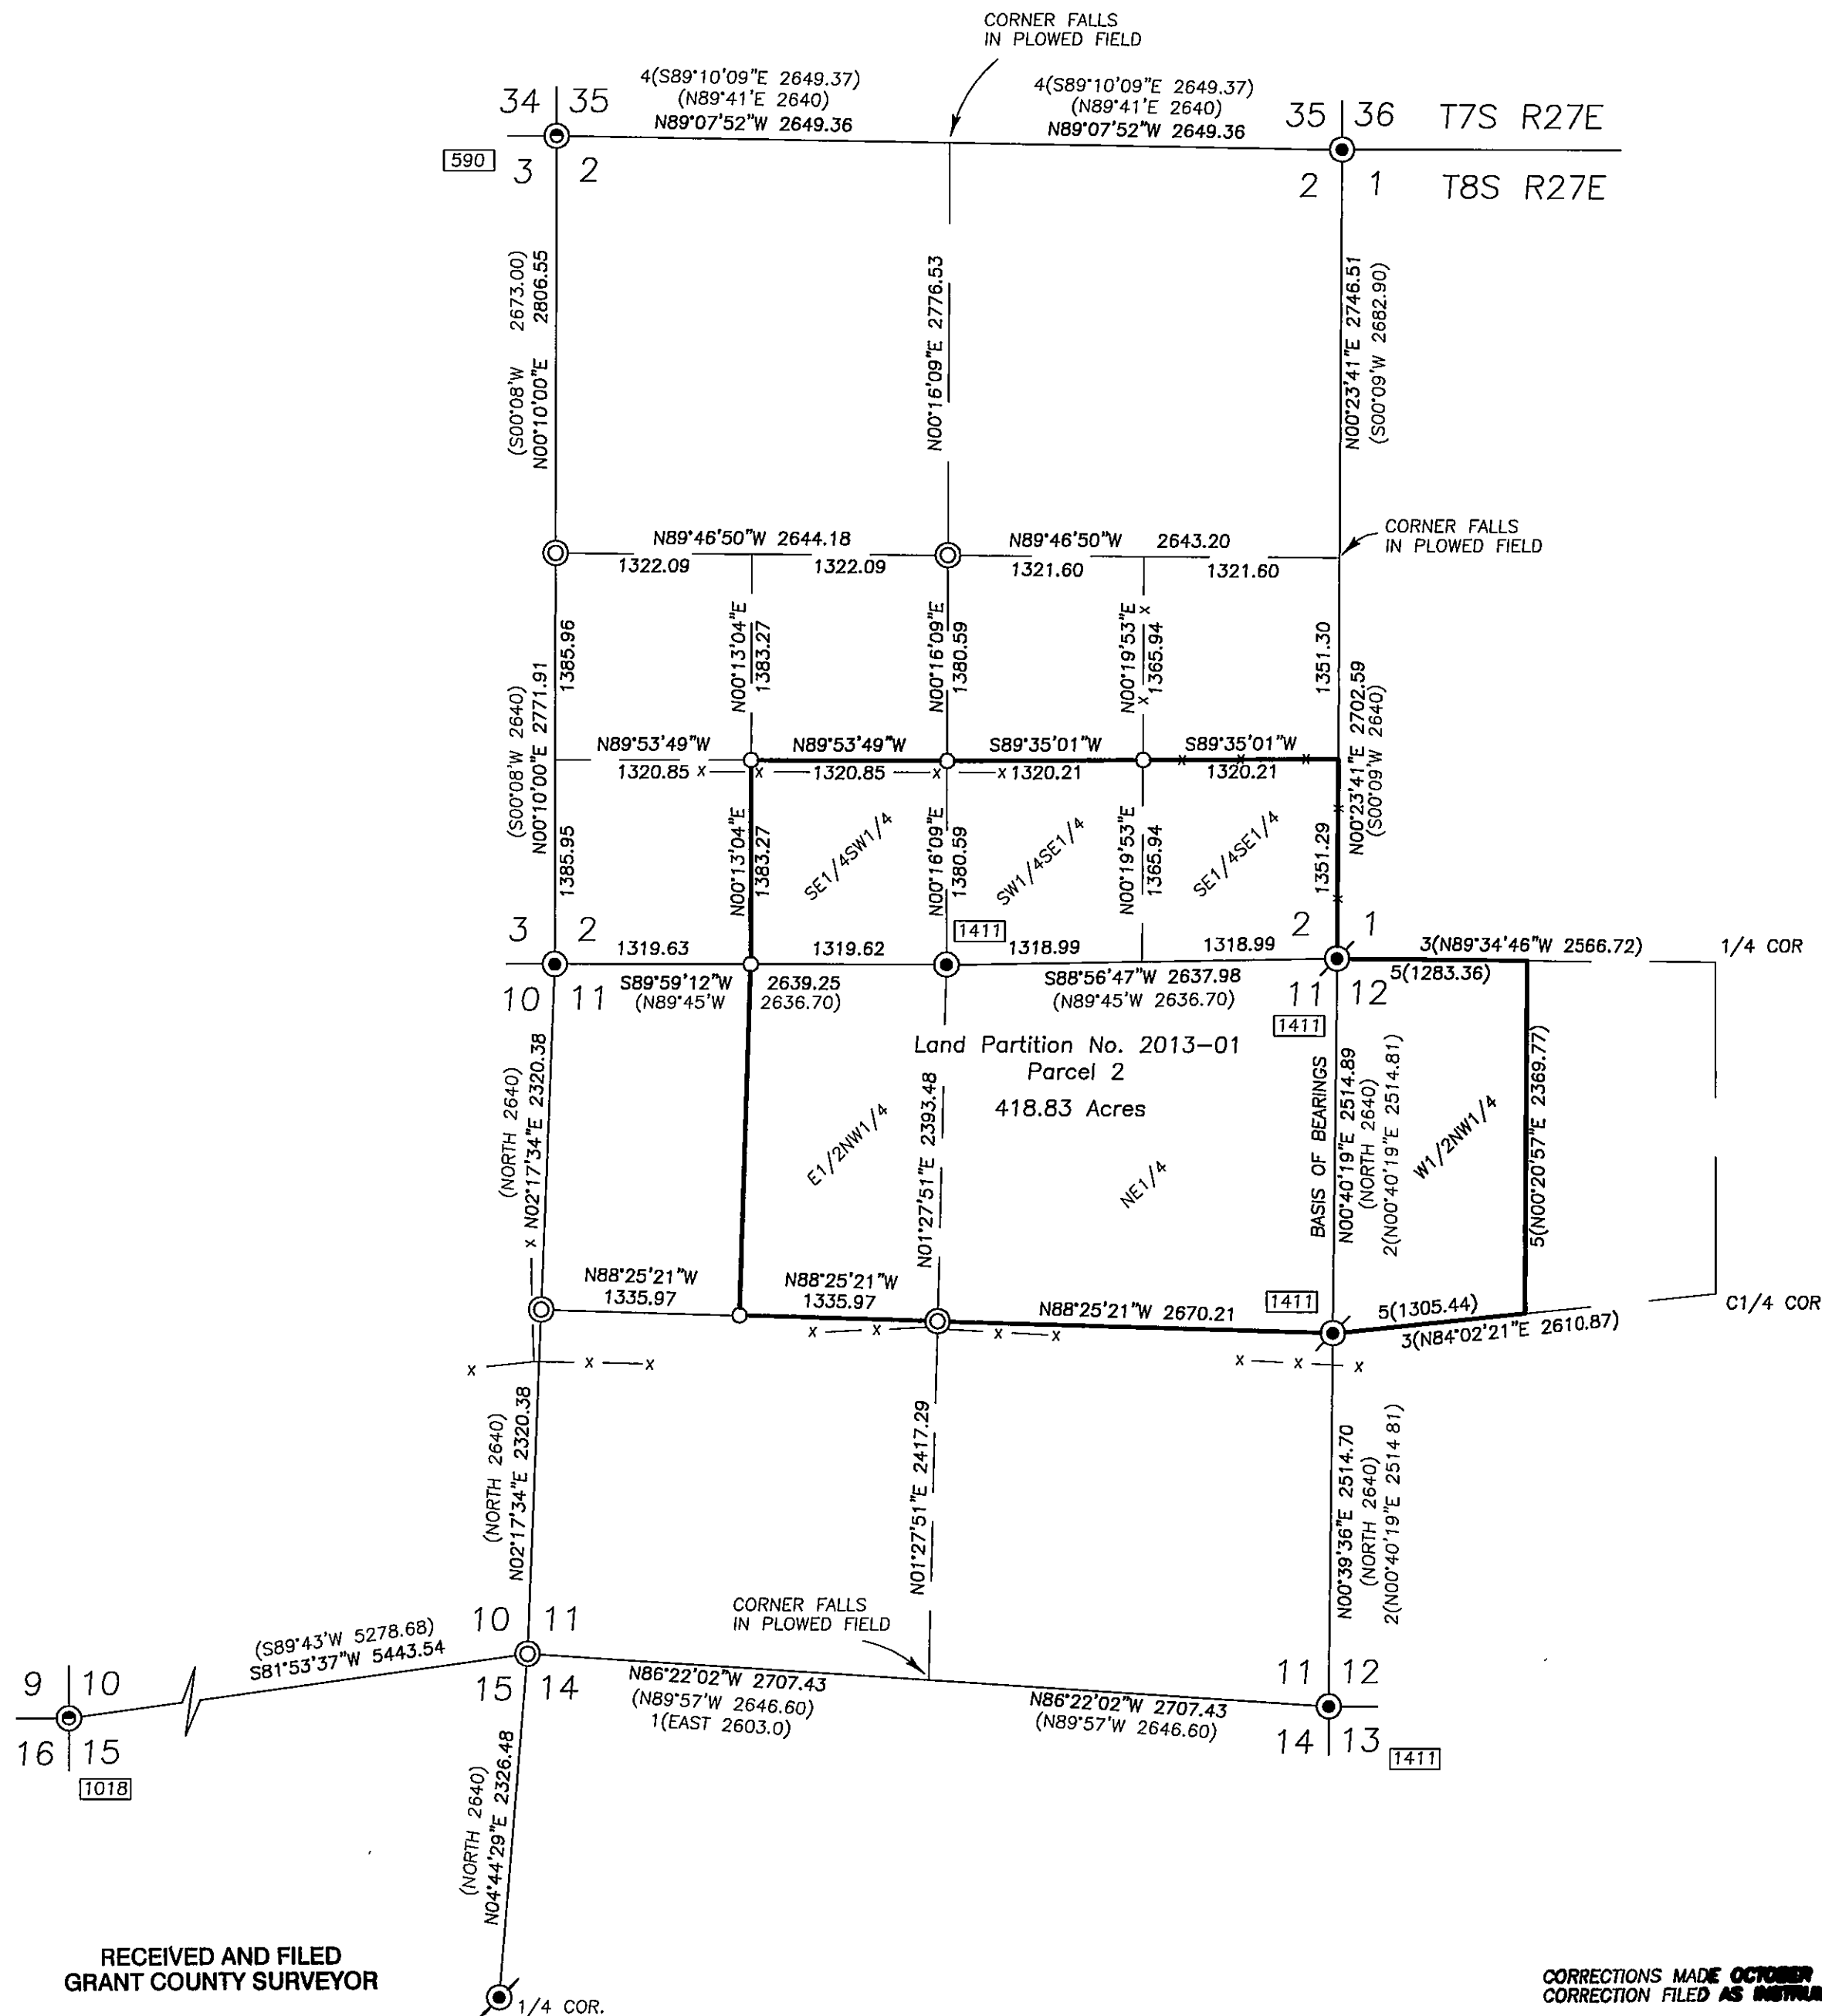

RECEIVED AND FILED
GRANT COUNTY SURVEYOR

APR 24 2013

BY: *[Signature]*

CORRECTIONS MADE OCTOBER 1, 2013 PER AFFIDAVIT OF
CORRECTION FILED AS INSTRUMENT NO. 20131000, DEED RECORDS.

[Signature]
GRANT COUNTY SURVEYOR



Scale 1"=1000'

BASIS OF BEARINGS

Survey No. 1411

LEGEND

- ⊙ Found 2" iron pipe with attached brass cap.
- ⊙ Found 2½" aluminum pipe with attached aluminum cap.
- ⊙ Found 1½" iron pipe with attached Grant County Surveyor brass cap.
- Set 5/8"x30" iron pin with attached 2" alum. cap marked CORNERSTONE SURVEYING, INC. and the corner designation.
- ⊙ Set 2½" aluminum pipe with attached 3½" aluminum cap. See Corner Restoration records for details.
- x—x Fence Line
- () GLO record bearing and distance.
- 1() Survey No. 6G record bearing and distance.
- 2() Survey No. 1018 record bearing and distance.
- 3() Survey No. 1411 record bearing and distance.
- 4() Survey No. 1966 record bearing and distance.
- 5() Calculated measurement
- Found monument, see record map of survey number shown in box.

See attached narrative for this survey.

REGISTERED
PROFESSIONAL
LAND SURVEYOR

[Signature]
OREGON
SEPT 19, 1995
JACK L. WATSON
2734

Renewal Date 6/30/2014



CORNERSTONE SURVEYING, Inc.
233 S. Canyon Blvd., John Day, Oregon 97845
(541) 575-1813

MAP OF SURVEY
SITUATED IN SECTION 2 & 11, T8S, R27E, W.M.
GRANT COUNTY, OREGON

SURVEYED FOR: **Roy Peterson**

SURVEYED BY: Jack Watson

SURVEY COMPLETED: 4/17/2013

MAP OF SURVEY NO. 1971