



SE 1/4 OF SEC. 21, T. 13 S., R. 32 E., W.M.

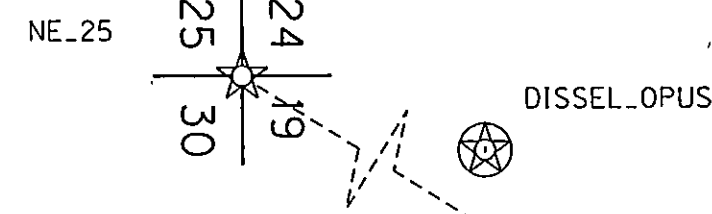

LEGEND	
[]	RECORD DATA USED PER ODOT DRG. 11-06-0004
()	RECORD DATA USED PER ODOT DRG. 5B-11-10
⊙	SET GPS OPUS POINT
☆	FOUND MONUMENT USED AS GPS POINT
★	RESET MONUMENT AS NOTED
○	FOUND MONUMENT AS NOTED
●	SET R/W MONUMENT
---	EXISTING RIGHT-OF-WAY
- - -	NEW RIGHT-OF-WAY
-X-	FENCE
- - -	EDGE PAVE. OR CURB
○	RIGHT-OF-WAY POINT NO.

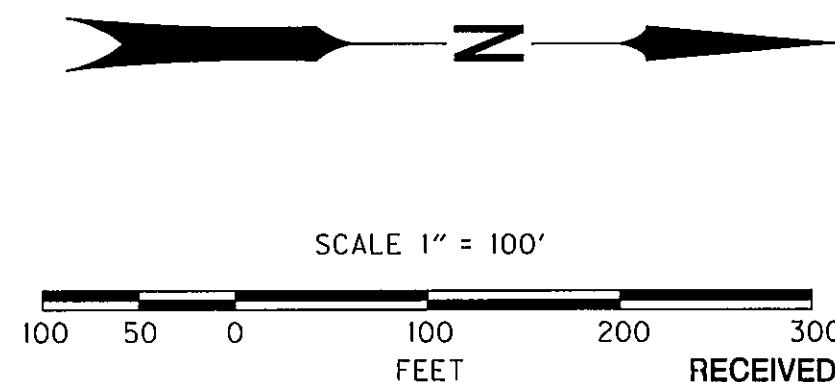

RECEIVED AND FILED
GRANT COUNTY SURVEYOR

FEB 27 2013

BY: *[Signature]*

RIGHT-OF-WAY POINTS LIST

PT. NO.	LDP NORTHING	LDP EASTING	STATION & ALIGNMENT	OFFSET	DATE	DESCRIPTION
5000	278,750.302	8,630,676.945	262+70 U.S. 26	40.00' Lt.	11/20/2012	SET 5/8" X 30" IRON ROD W/ 1 1/2" DIA. ALUMINUM CAP MARKED "ODOT 2012", SET STEEL POST 1.0' WEST
5001	278,751.998	8,630,674.470	262+70 U.S. 26	43.00' Lt.	11/20/2012	SET 5/8" X 30" IRON ROD W/ 1 1/2" DIA. ALUMINUM CAP MARKED "ODOT 2012", SET STEEL POST 1.0' EAST
5002	278,793.183	8,630,704.123	263+20 U.S. 26	43.00' Lt.	11/20/2012	SET 5/8" X 30" IRON ROD W/ 1 1/2" DIA. ALUMINUM CAP MARKED "ODOT 2012", SET STEEL POST 1.0' WEST
5003	278,791.444	8,630,706.495	263+20 U.S. 26	40.00' Lt.	11/20/2012	SET 5/8" X 30" IRON ROD W/ 1 1/2" DIA. ALUMINUM CAP MARKED "ODOT 2012", SET STEEL POST 1.0' WEST

SET AND RECOVERED MONUMENT LIST

PT. NO.	LDP NORTHING	LDP EASTING	STATION & ALIGNMENT	OFFSET	DATE	DESCRIPTION & REFERENCE DOCUMENTS
NW_25	277,856.169	8,611,057.161	N/A U.S. 26	N/A	6/20/2012	FND 3 1/2" DIA. BLM BRASS CAP ON 2 1/2" IRON PIPE
NE_25	277,980.890	8,616,404.777	N/A U.S. 26	N/A	6/20/2012	FND 3 1/2" DIA. BLM BRASS CAP ON 2 1/2" IRON PIPE
SE_25	272,669.232	8,616,532.256	N/A U.S. 26	N/A	6/20/2012	FND 3 1/2" DIA. BLM BRASS CAP ON 2 1/2" IRON PIPE
DISSEL_OPUS	277,936.653	8,630,187.567	N/A U.S. 26	N/A	6/20/2012	SET 5/8" X 30" IRON ROD WITH 1 1/2" DIA. ALUMINUM CAP MARKED "ODOT"
400	278,642.722	8,630,699.850	261+94.35 U.S. 26	40.00' Rt.	11/20/2012	RESET 5/8" X 30" IRON ROD, W/ 1 1/2" DIA. ALUMINUM CAP MARKED "ODOT 2012", SET STEEL POST 1.0 FT. WEST
401	278,185.224	8,630,335.531	256+13.42 U.S. 26	40.32' Lt.	11/20/2012	RESET 5/8" X 30" IRON ROD, W/ 1 1/2" DIA. ALUMINUM CAP MARKED "ODOT 2012", SET STEEL POST 1.0 FT. EAST
402	279,995.357	8,631,879.729	279+96.39 U.S. 26	40.08' Lt.	2/03/2011	FND 3/4" DIA. IRON ROD
403	279,938.385	8,631,936.118	279+96.39 U.S. 26	40.08' Rt.	2/03/2011	FND 3/4" DIA. IRON ROD
404	278,687.103	8,630,633.709	261+94.54 U.S. 26	40.00' Lt.	11/20/2012	RESET 5/8" X 30" IRON ROD, W/ 1 1/2" DIA. ALUMINUM CAP MARKED "ODOT 2012", SET STEEL POST 1.0 FT. WEST
405	279,004.221	8,630,878.832	265+90.30 U.S. 26	39.84' Lt.	11/20/2012	RESET 5/8" X 30" IRON ROD, W/ 1 1/2" DIA. ALUMINUM CAP MARKED "ODOT 2012", SET STEEL POST 1.0 FT. WEST

Donna R. Carter, Trustee
D. R. Carter, LLC
Instr. No. 990835
Instr. No. 982769

Donna R. Carter, Trustee
D. R. Carter, LLC
Instr. No. 990835
Instr. No. 982769

CURVE DATA
USED BY
THIS SURVEY
[2°00'00" C.R.]
[R = 2864.79']
[TA = 15°56'00"]
[LTs = 601.21']
[CS = 4°00'00"]
[S = 601.21']

SEE DETAIL A

DEAN CREEK

JOHN DAY HIGHWAY
U.S. 26

NOT TO SCALE

DETAIL A

REGISTERED
PROFESSIONAL
LAND SURVEYOR

Robert E. Butler

OREGON
July 25, 1995
ROBERT ERICH BUTLER
2733

EXPIRES: 12/31/2013

OREGON DEPARTMENT OF TRANSPORTATION

RIGHT-OF-WAY NETWORK MONUMENTATION MAP

DEAN CREEK BRIDGE NO. 21549

JOHN DAY HIGHWAY NO. 5

(U.S. 26) M.P. 166.83

GRANT COUNTY



ODOT REGION 5
3012 ISLAND AVE.
LA GRANDE, OR. 97850-9497

JUNE 20, 2012
SCALE 1" = 100'
SHEET 2 OF 2

RECORD MAP OF SURVEY NO. 1972