


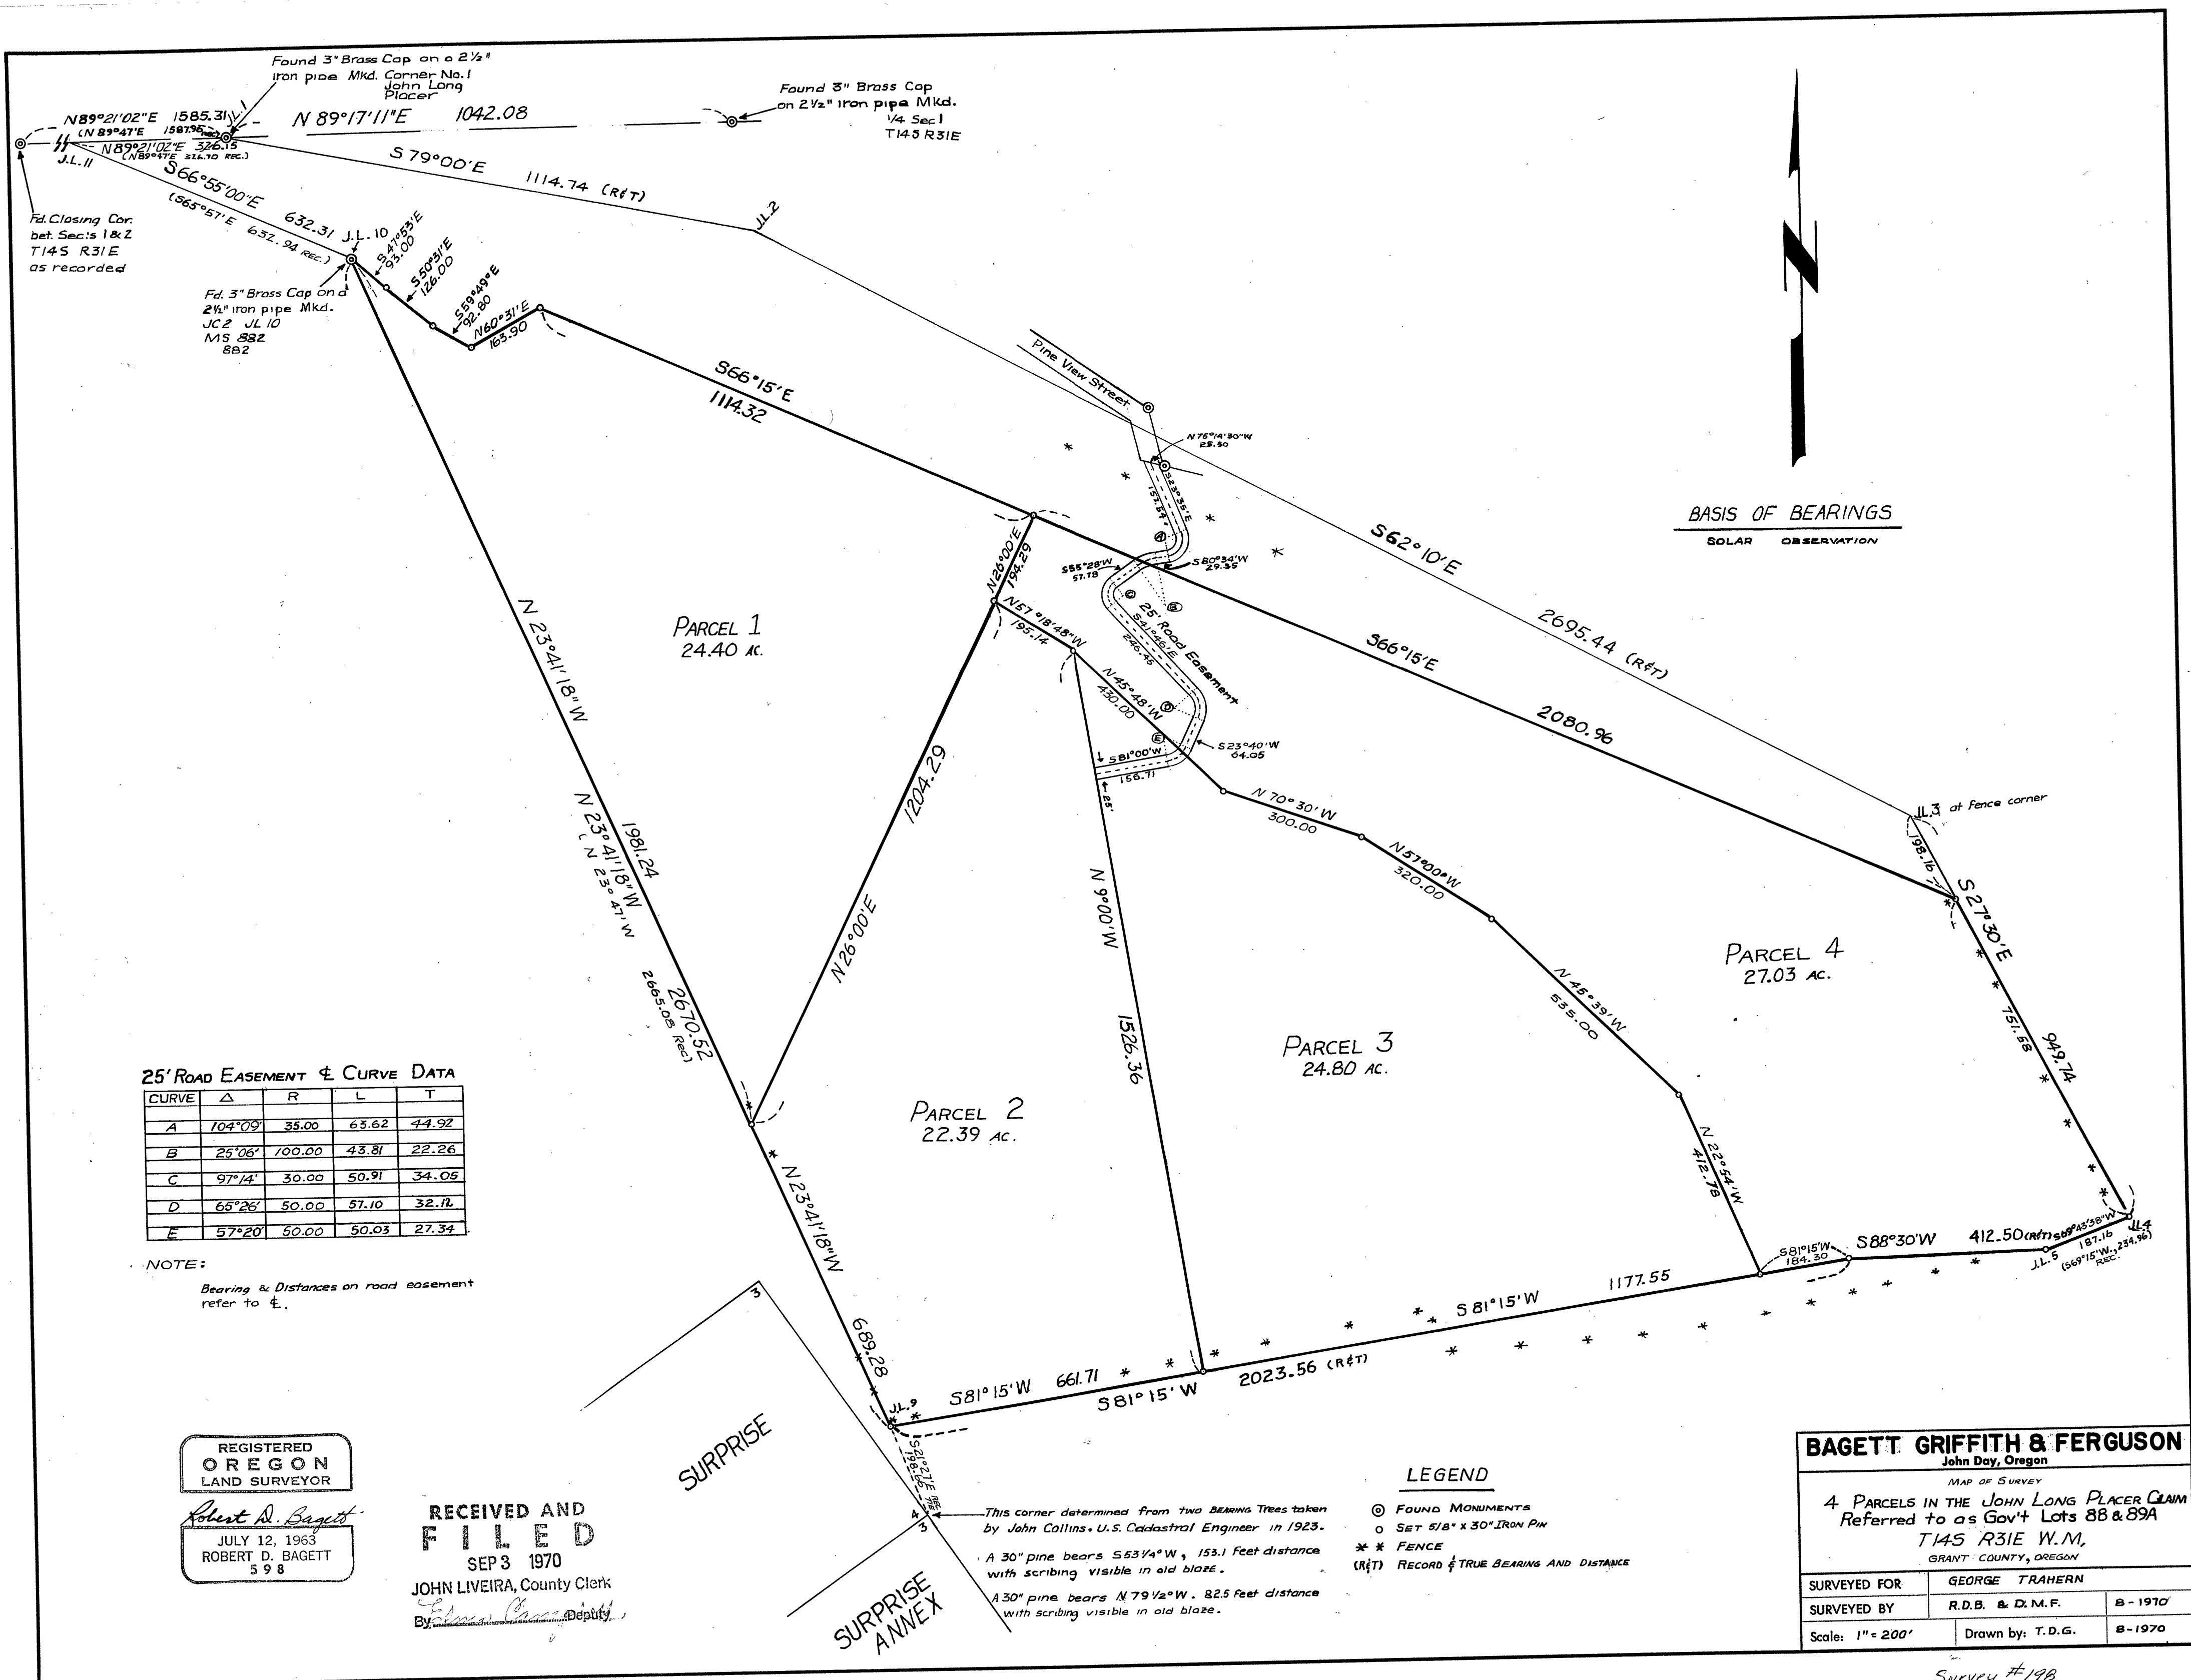

25' ROAD EASEMENT & CURVE DATA

CURVE	Δ	R	L	T
A	104°09'	35.00	63.62	44.92
B	25°06'	100.00	43.81	22.26
C	97°14'	30.00	50.91	34.05
D	65°26'	50.00	57.10	32.12
E	57°20'	50.00	50.03	27.34

NOTE:

Bearing & Distances on road easement refer to Δ.

REGISTERED
OREGON
LAND SURVEYOR
Robert D. Baggett
JULY 12, 1963
ROBERT D. BAGGETT
598

RECEIVED AND
FILED
SEP 3 1970
JOHN LIVEIRA, County Clerk
By *[Signature]* Deputy

SURPRISE

SURPRISE
ANNEX

This corner determined from two BEARING TREES taken by John Collins, U.S. Cadastral Engineer in 1923.
A 30" pine bears S53 1/4°W, 153.1 feet distance with scribing visible in old blaze.
A 30" pine bears N79 1/2°W, 82.5 feet distance with scribing visible in old blaze.

LEGEND

- FOUND MONUMENTS
- SET 5/8" x 30" IRON PIN
- ** FENCE
- (R&T) RECORD & TRUE BEARING AND DISTANCE

BAGETT GRIFFITH & FERGUSON			
John Day, Oregon			
MAP OF SURVEY			
4 PARCELS IN THE JOHN LONG PLACER CLAIM Referred to as Gov't Lots 88 & 89A T14S R31E W.M., GRANT COUNTY, OREGON			
SURVEYED FOR	GEORGE TRAHERN		
SURVEYED BY	R.D.B. & D.M.F.	8-1970	
Scale: 1" = 200'	Drawn by: T.D.G.	8-1970	

Survey #198