


NW 1/4 AND NE 1/4 OF SEC. 26, T. 13 S., R. 31 E., W.M.

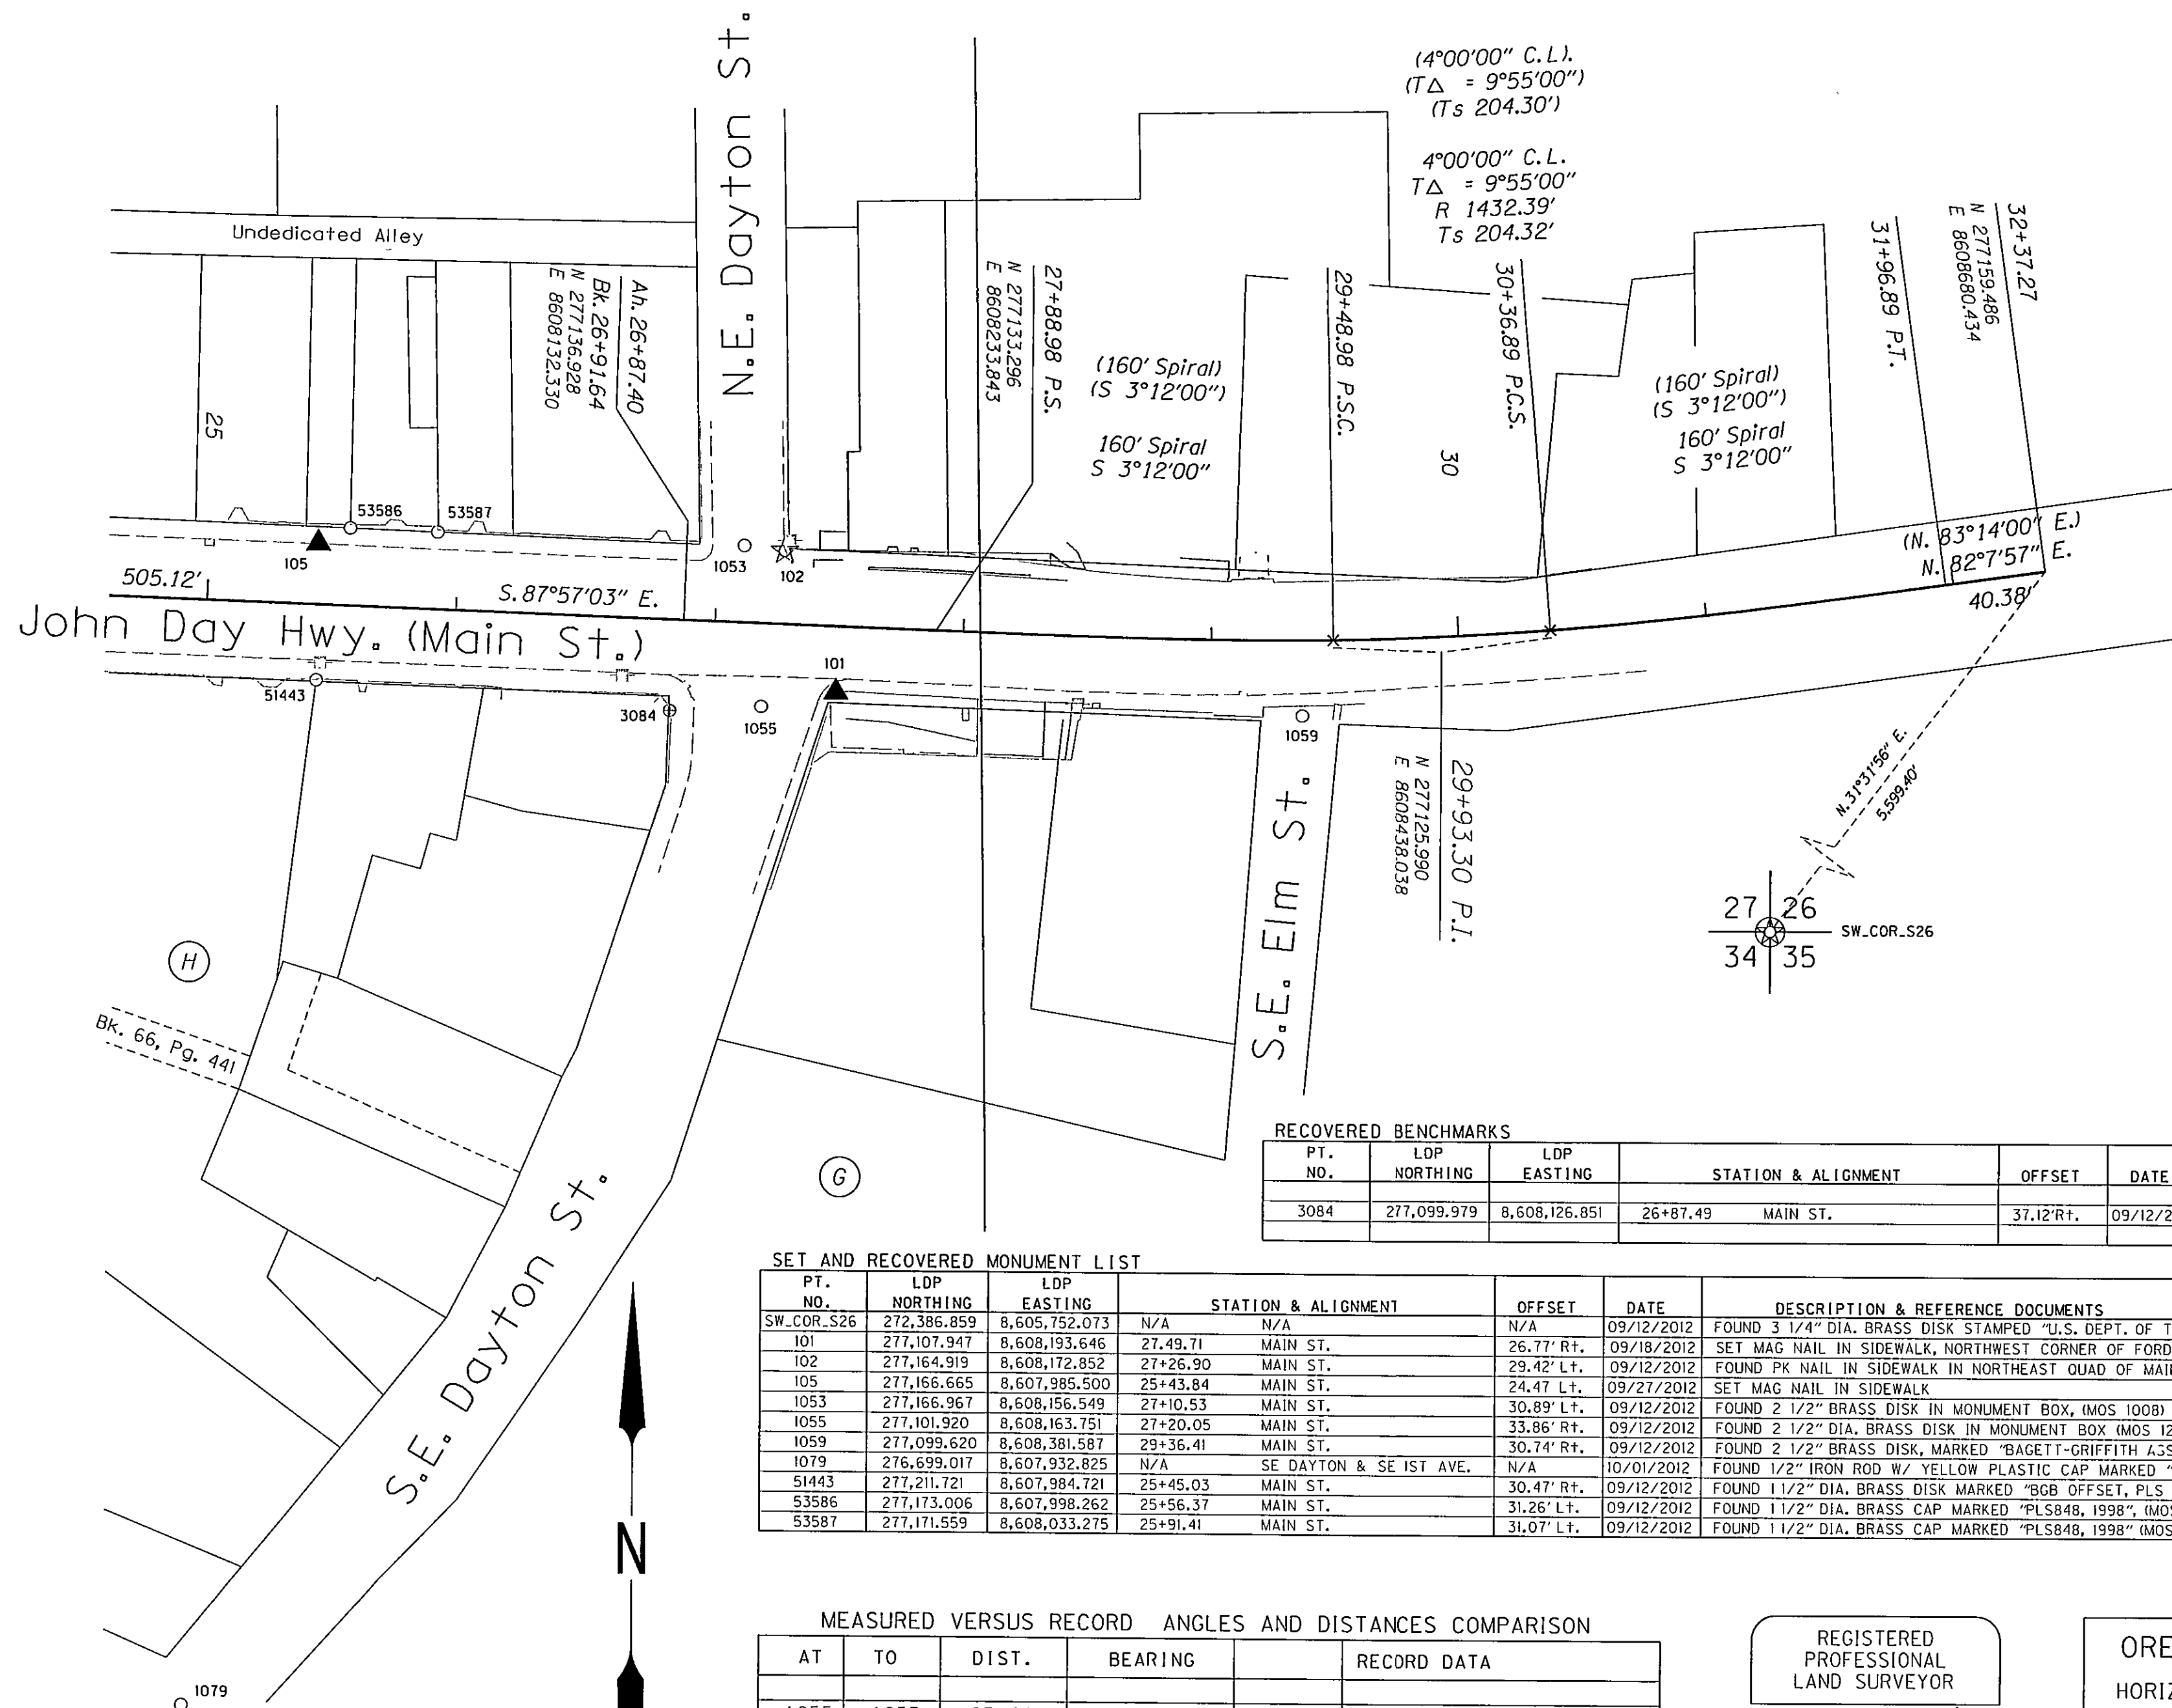

SET AND RECOVERED MONUMENT LIST

PT. NO.	LDP NORTHING	LDP EASTING	STATION & ALIGNMENT	OFFSET	DATE	DESCRIPTION & REFERENCE DOCUMENTS
SW_COR_S26	272,386.859	8,605,752.073	N/A	N/A	09/12/2012	FOUND 3 1/4" DIA. BRASS DISK STAMPED "U.S. DEPT. OF THE INTERIOR BUR. OF LAND MANG., T13S R31E, S27 S26, S34 S35, 1971"
101	277,107.947	8,608,193.646	27+49.71 MAIN ST.	26.77' Rt.	09/18/2012	SET MAG NAIL IN SIDEWALK, NORTHWEST CORNER OF FORD DEALERSHIP
102	277,164.919	8,608,172.852	27+26.90 MAIN ST.	29.42' Lt.	09/12/2012	FOUND PK NAIL IN SIDEWALK IN NORTHEAST QUAD OF MAIN ST. AND DAYTON ST.
105	277,166.665	8,607,985.500	25+43.84 MAIN ST.	24.47' Lt.	09/27/2012	SET MAG NAIL IN SIDEWALK
1053	277,166.967	8,608,156.549	27+10.53 MAIN ST.	30.89' Lt.	09/12/2012	FOUND 2 1/2" BRASS DISK IN MONUMENT BOX, (MOS 1008)
1055	277,101.920	8,608,163.751	27+20.05 MAIN ST.	33.86' Rt.	09/12/2012	FOUND 2 1/2" DIA. BRASS DISK IN MONUMENT BOX (MOS 1211)
1059	277,099.620	8,608,381.587	29+36.41 MAIN ST.	30.74' Rt.	09/12/2012	FOUND 2 1/2" BRASS DISK, MARKED "BAGETT-GRIFFITH ASSOC, MON NO 44" IN MONUMENT BOX, (MOS 1211)
1079	276,699.017	8,607,932.825	N/A	N/A	10/01/2012	FOUND 1/2" IRON ROD W/ YELLOW PLASTIC CAP MARKED "APA" IN MONUMENT BOX, (MOS 1764)
51443	277,211.721	8,607,984.721	25+45.03 MAIN ST.	30.47' Rt.	09/12/2012	FOUND 1 1/2" DIA. BRASS DISK MARKED "BGB OFFSET, PLS 70918", (LP 2005-27)
53586	277,173.006	8,607,998.262	25+56.37 MAIN ST.	31.26' Lt.	09/12/2012	FOUND 1 1/2" DIA. BRASS CAP MARKED "PLS848, 1998", (MOS 1246)
53587	277,171.559	8,608,033.275	25+91.41 MAIN ST.	31.07' Lt.	09/12/2012	FOUND 1 1/2" DIA. BRASS CAP MARKED "PLS848, 1998" (MOS 1739)

MEASURED VERSUS RECORD ANGLES AND DISTANCES COMPARISON

AT	TO	DIST.	BEARING	RECORD DATA
1055	1053	65.44'	N06°19'05"W	65.45' N5°12'02"W (MOS 1211)
1055	1059	217.85'	S89°23'42"E	217.81' S88°18'47"E (MOS 1211)
53586	1053	158.40'	S87°48'54"E	158.49' S86°42'51"E (MOS 1475)
53586	53587	35.04'	S87°38'00"E	35.05' S86°36'07"E (MOS 1739)
51444	51443	105.94'	S87°57'02"E	105.90' S86°51'00"E (MOS 336)
				105.90' S86°51'00"E (PP 2005-27)

REGISTERED
PROFESSIONAL
LAND SURVEYOR

Robert E. Butler

OREGON
July 25, 1995
ROBERT ERICH BUTLER
2733

EXPIRES: 12/31/2015

OREGON DEPARTMENT OF TRANSPORTATION
HORIZONTAL CONTROL, RECOVERY AND RETRACEMENT MAP
US26: JOHN DAY HWY. NO. 005
US395: JOHN DAY - BURNS HWY. NO. 048
CITY OF JOHN DAY
GRANT COUNTY

ODOT REGION 5
3012 ISLAND AVE.
LA GRANDE, OR. 97850-9497

MARCH 17, 2014
SCALE: 1" = 50'
SHEET 4 OF 5