


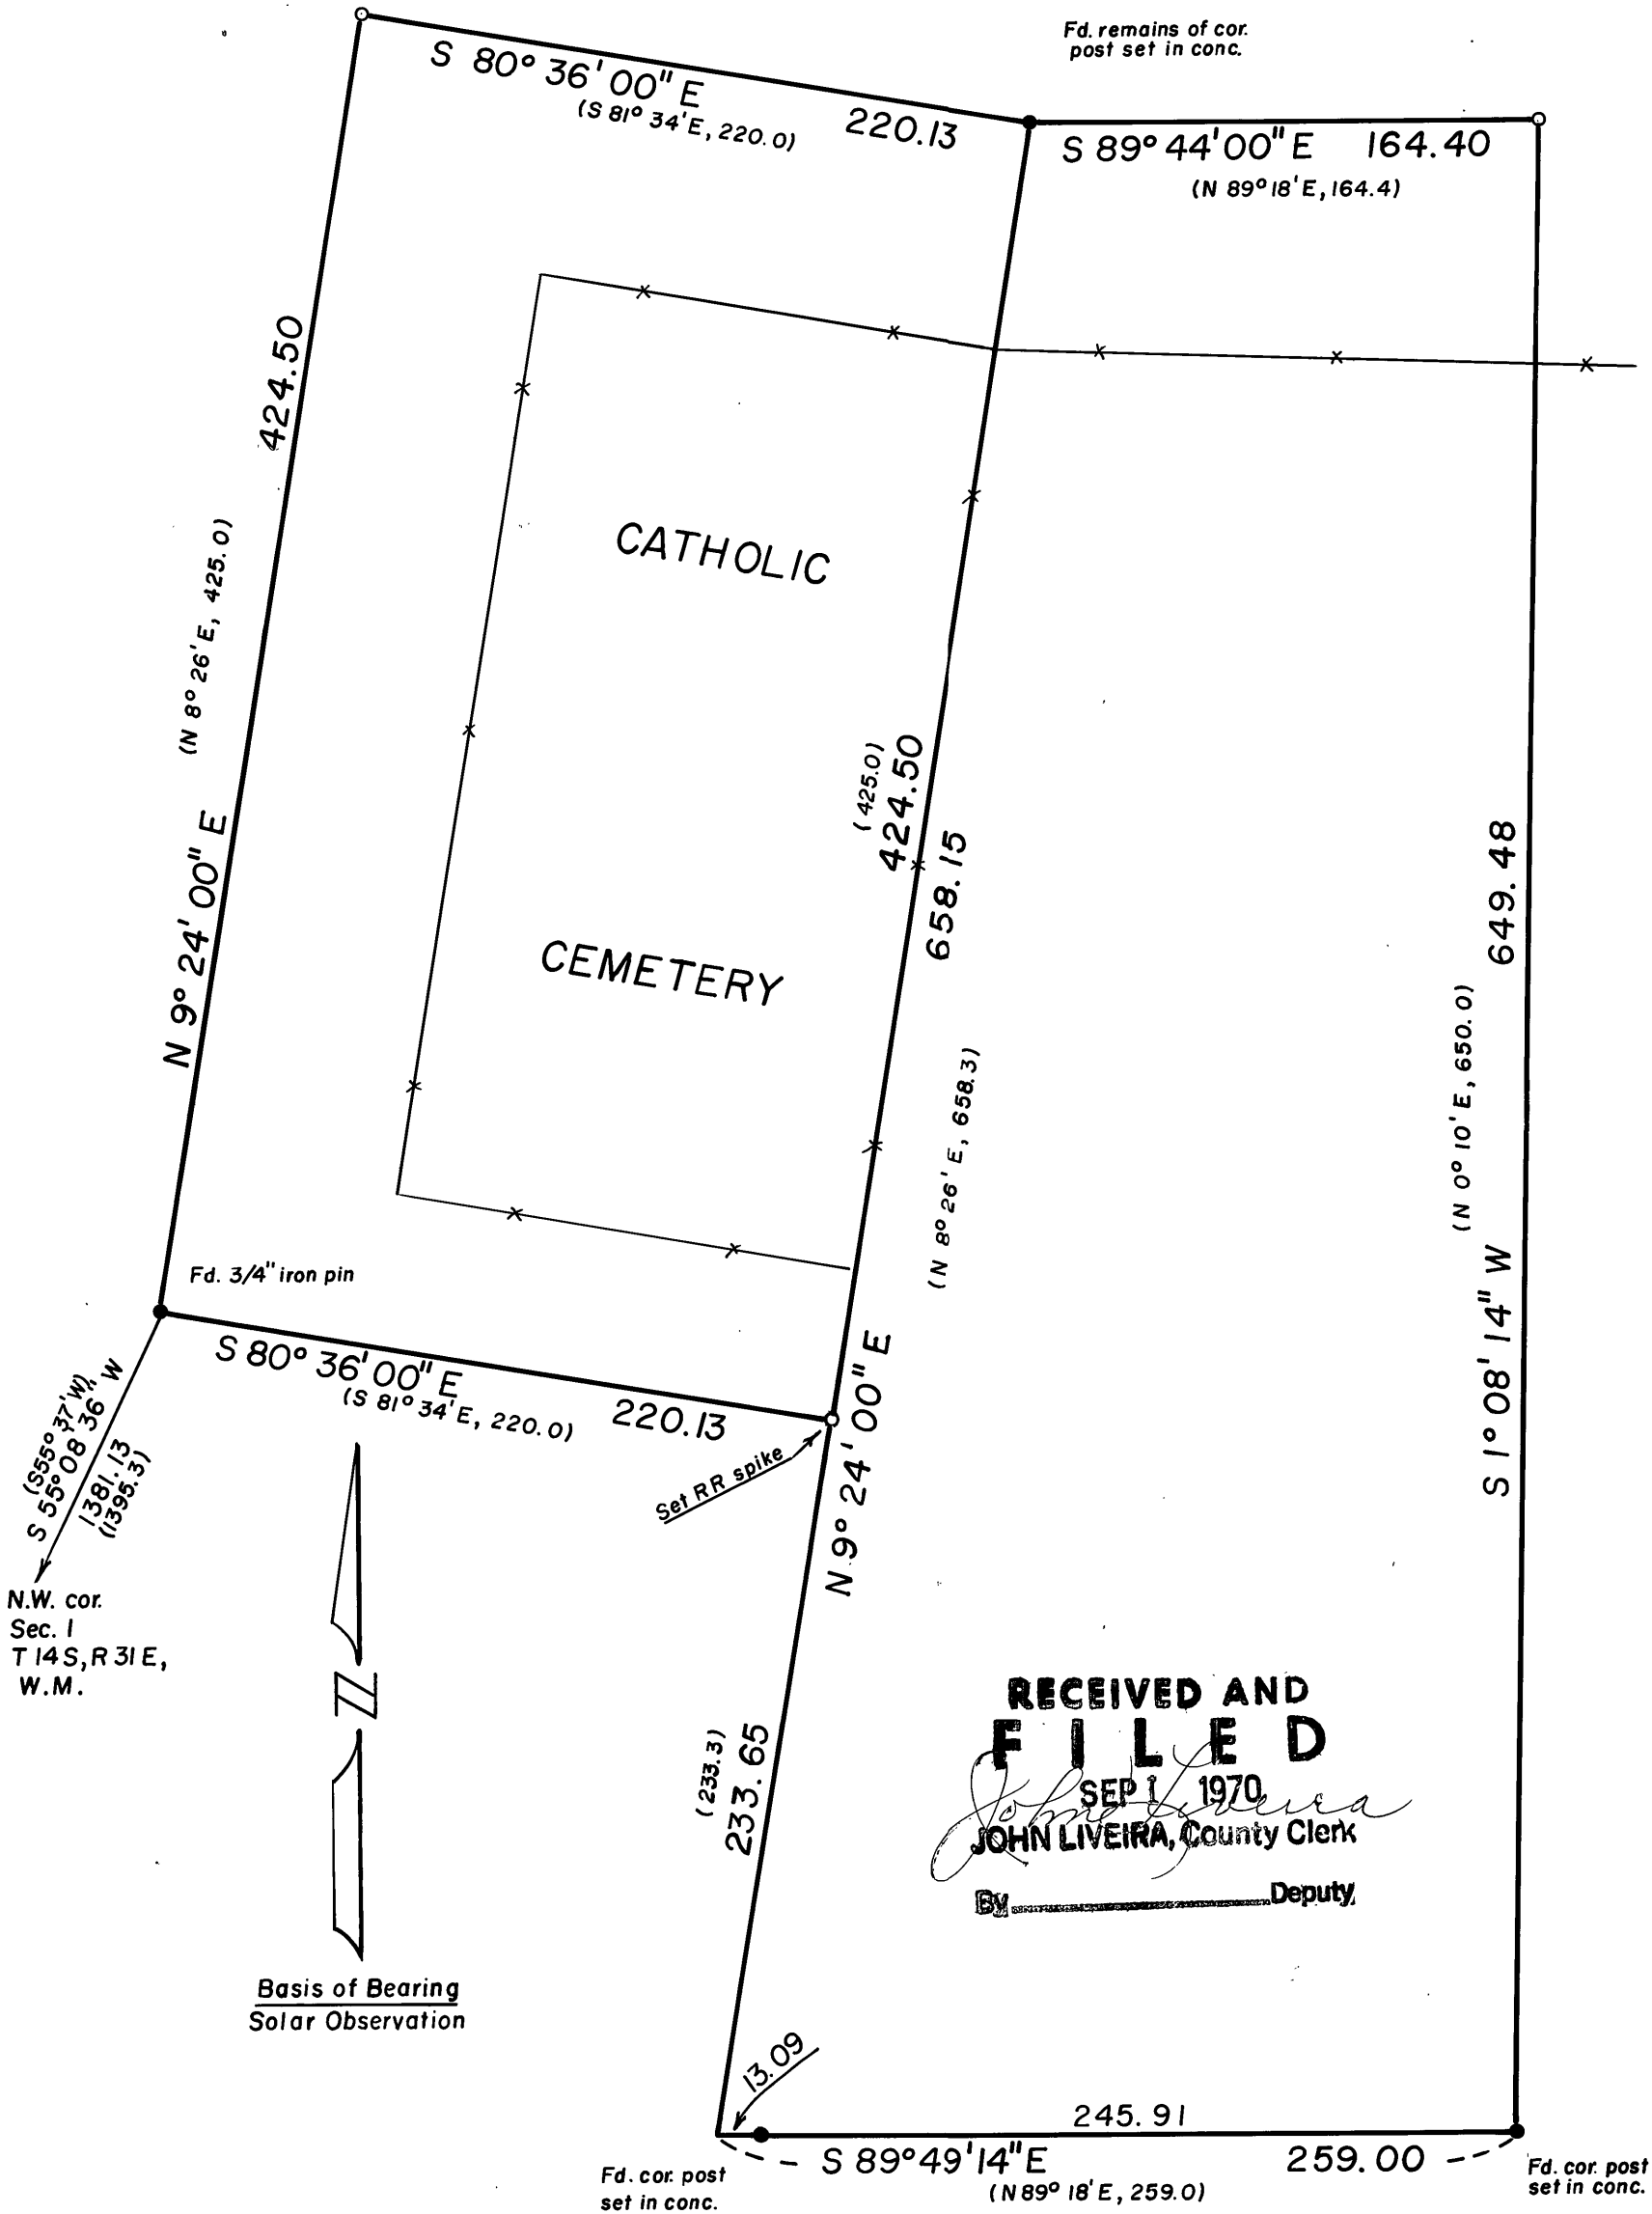

# LEGEND

- Found monument
- Set 5/8" x 30" iron pin
- ( ) Record bearing and distance
- \* Existing fence

REGISTERED  
OREGON  
LAND SURVEYOR

*Duane I. Griffith*

JULY 10, 1964  
DUANE I. GRIFFITH  
644

|                                    |                              |           |
|------------------------------------|------------------------------|-----------|
| <b>BAGETT-GRIFFITH-FERGUSON</b>    |                              |           |
| John Day, Oregon                   |                              |           |
| Map of Survey                      |                              |           |
| Parcel in the SW 1/4 of the SE 1/4 |                              |           |
| Section 35, T 13 S, R 31 E, WM     |                              |           |
| CANYON CITY                        |                              |           |
| Grant County, Oregon               |                              |           |
| SURVEYED FOR                       | Mid-County Cemetery District |           |
| SURVEYED BY                        | D.I.G. - D.M.F.              | Aug. 1970 |
| Scale: 1" = 60'                    | Drawn by: D.I.G.             | Aug. 1970 |

Map of Survey no 201