


SE¹/₄ & SW¹/₄ Section 14 T.17S. R.31E. W.M.
NE¹/₄ & NW¹/₄ Section 23 T.17S. R.31E. W.M.

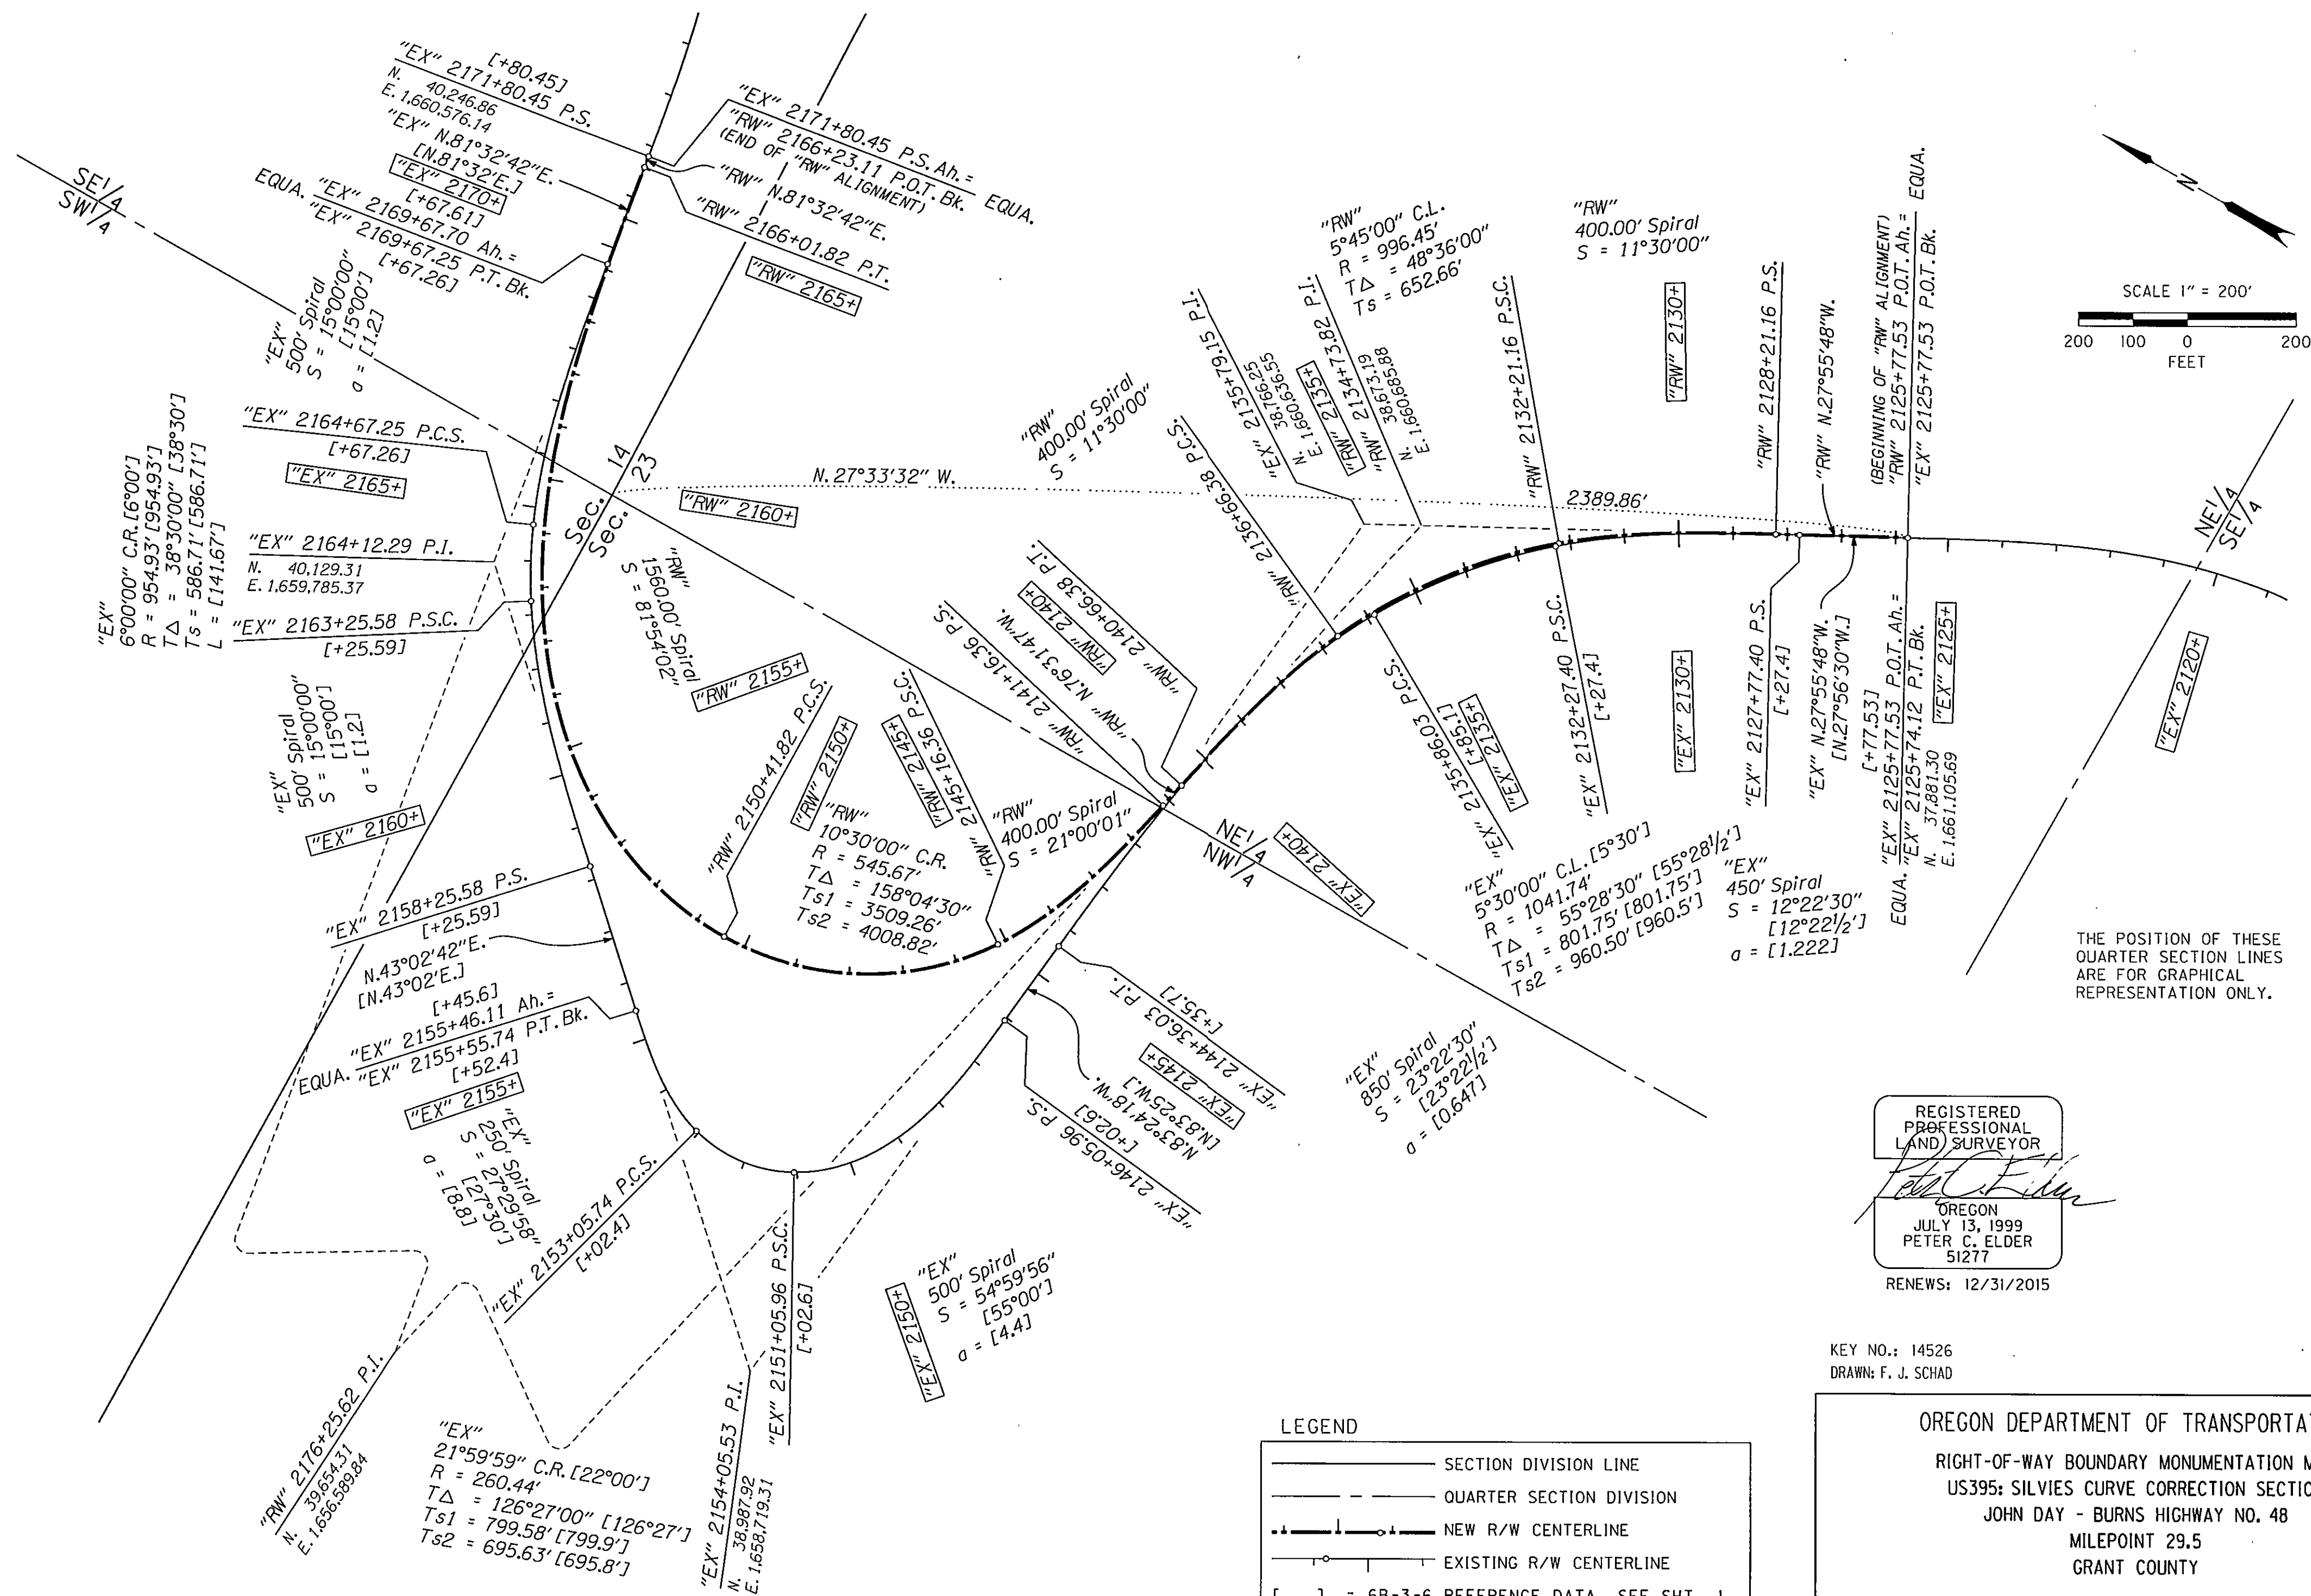

THE POSITION OF THESE
QUARTER SECTION LINES
ARE FOR GRAPHICAL
REPRESENTATION ONLY.

REGISTERED
PROFESSIONAL
LAND SURVEYOR

OREGON
JULY 13, 1999
PETER C. ELDER
51277

RENEWS: 12/31/2015

KEY NO.: 14526
DRAWN: F. J. SCHAD

OREGON DEPARTMENT OF TRANSPORTATION

RIGHT-OF-WAY BOUNDARY MONUMENTATION MAP

US395: SILVIES CURVE CORRECTION SECTION

JOHN DAY - BURNS HIGHWAY NO. 48

MILEPOINT 29.5

GRANT COUNTY

ODOT REGION 5
3012 ISLAND AVE.
LA GRANDE, OR 97850

DECEMBER 16, 2014

SCALE: 1 in. = 200 ft.

Sheet 7 of 7

RECORD MAP OF SURVEY NO. 2018