RECORD OF SURVEY

SECTIONS 19, 25, 26, 28, 29, 33, 34 & 35, TOWNSHIP 8 SOUTH RANGE 26 EAST WILLAMETTE MERIDIAN, GRANT COUNTY, OREGON

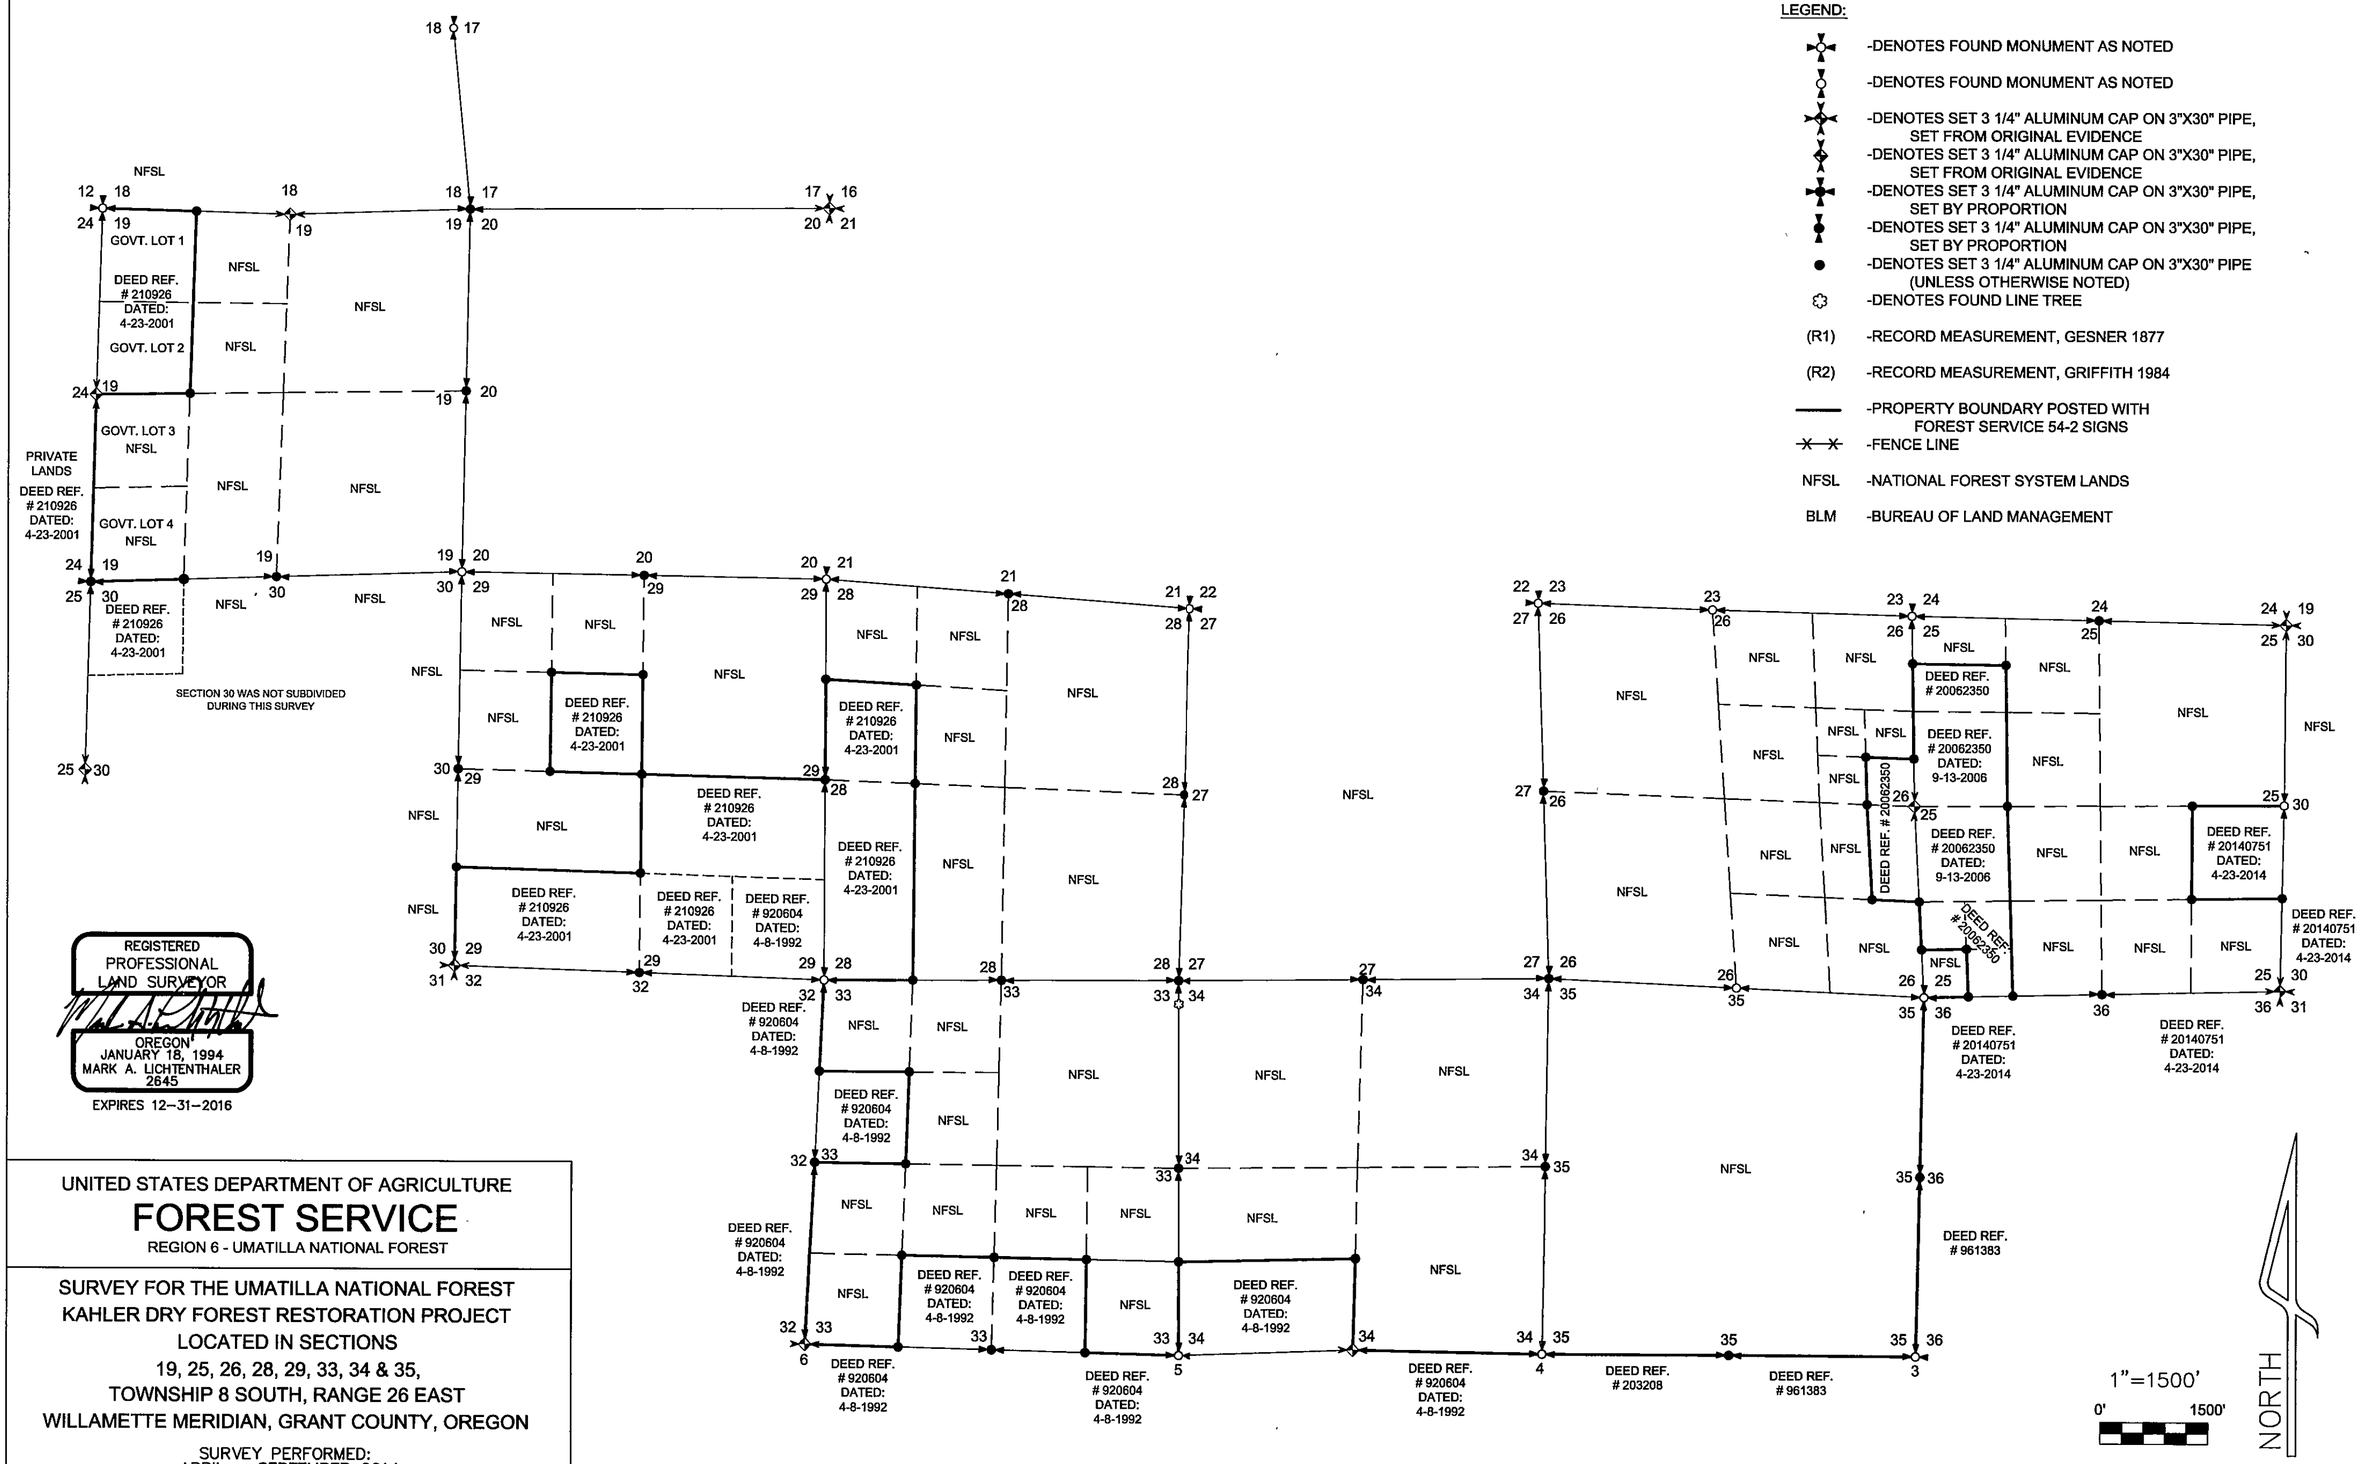

UNITED STATES DEPARTMENT OF AGRICULTURE

FOREST SERVICE

REGION 6 - UMATILLA NATIONAL FOREST

SURVEY FOR THE UMATILLA NATIONAL FOREST
KAHLER DRY FOREST RESTORATION PROJECT
LOCATED IN SECTIONS
19, 25, 26, 28, 29, 33, 34 & 35,
TOWNSHIP 8 SOUTH, RANGE 26 EAST
WILLAMETTE MERIDIAN, GRANT COUNTY, OREGON

SURVEY PERFORMED:
APRIL – SEPTEMBER 2014

DRAWN BY: RWF | SHEET 2 of 10

RECORD MAP OF SURVEY NO. 2026