
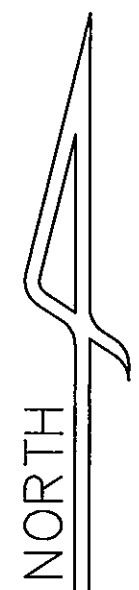


RECORD OF SURVEY

SECTIONS 19, 25, 26, 28, 29, 33, 34 & 35,
TOWNSHIP 8 SOUTH RANGE 26 EAST
WILLAMETTE MERIDIAN, GRANT COUNTY, OREGON

LEGEND:

- DENOTES FOUND MONUMENT AS NOTED
- DENOTES FOUND MONUMENT AS NOTED
- DENOTES SET 3 1/4" ALUMINUM CAP ON 3"x30" PIPE, SET FROM ORIGINAL EVIDENCE
- DENOTES SET 3 1/4" ALUMINUM CAP ON 3"x30" PIPE, SET FROM ORIGINAL EVIDENCE
- DENOTES SET 3 1/4" ALUMINUM CAP ON 3"x30" PIPE, SET BY PROPORTION
- DENOTES SET 3 1/4" ALUMINUM CAP ON 3"x30" PIPE, SET BY PROPORTION
- DENOTES SET 3 1/4" ALUMINUM CAP ON 3"x30" PIPE (UNLESS OTHERWISE NOTED)
- DENOTES FOUND LINE TREE
- (R1) -RECORD MEASUREMENT, GESNER 1877
- (R2) -RECORD MEASUREMENT, GRIFFITH 1984
- PROPERTY BOUNDARY POSTED WITH FOREST SERVICE 54-2 SIGNS
- FENCE LINE
- NFSL -NATIONAL FOREST SYSTEM LANDS
- BLM -BUREAU OF LAND MANAGEMENT

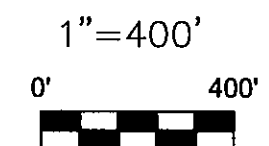

UNITED STATES DEPARTMENT OF AGRICULTURE
FOREST SERVICE
REGION 6 - UMATILLA NATIONAL FOREST

SURVEY FOR THE UMATILLA NATIONAL FOREST
KAHLER DRY FOREST RESTORATION PROJECT
LOCATED IN SECTIONS
19, 25, 26, 28, 29, 33, 34 & 35,
TOWNSHIP 8 SOUTH, RANGE 26 EAST
WILLAMETTE MERIDIAN, GRANT COUNTY, OREGON

SURVEY PERFORMED:
APRIL - SEPTEMBER 2014

DRAWN BY: RWF SHEET 4 of 10

