













RECORD OF SURVEY

SECTIONS 19, 25, 26, 28, 29, 33, 34 & 35,
TOWNSHIP 8 SOUTH RANGE 26 EAST
WILLAMETTE MERIDIAN, GRANT COUNTY, OREGON

LEGEND:

-  -DENOTES FOUND MONUMENT AS NOTED
-  -DENOTES FOUND MONUMENT AS NOTED
-  -DENOTES SET 3 1/4" ALUMINUM CAP ON 3"x30" PIPE, SET FROM ORIGINAL EVIDENCE
-  -DENOTES SET 3 1/4" ALUMINUM CAP ON 3"x30" PIPE, SET FROM ORIGINAL EVIDENCE
-  -DENOTES SET 3 1/4" ALUMINUM CAP ON 3"x30" PIPE, SET BY PROPORTION
-  -DENOTES SET 3 1/4" ALUMINUM CAP ON 3"x30" PIPE, SET BY PROPORTION
-  -DENOTES SET 3 1/4" ALUMINUM CAP ON 3"x30" PIPE (UNLESS OTHERWISE NOTED)
-  -DENOTES FOUND LINE TREE
- (R1) -RECORD MEASUREMENT, GESNER 1877
- (R2) -RECORD MEASUREMENT, GRIFFITH 1984
-  -PROPERTY BOUNDARY POSTED WITH FOREST SERVICE 54-2 SIGNS
-  -FENCE LINE
- NFSL -NATIONAL FOREST SYSTEM LANDS
- BLM -BUREAU OF LAND MANAGEMENT

REGISTERED
PROFESSIONAL
LAND SURVEYOR
Mark A. Lichtenthaler
OREGON
JANUARY 18, 1994
MARK A. LICHTENTHALER
2645
EXPIRES 12-31-2016

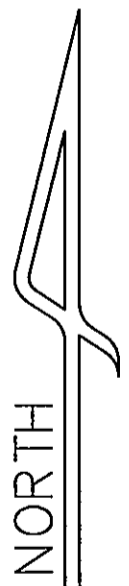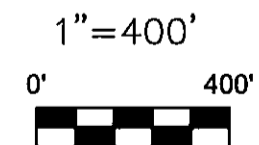


UNITED STATES DEPARTMENT OF AGRICULTURE
FOREST SERVICE
REGION 6 - UMATILLA NATIONAL FOREST

SURVEY FOR THE UMATILLA NATIONAL FOREST
KAHLER DRY FOREST RESTORATION PROJECT
LOCATED IN SECTIONS
19, 25, 26, 28, 29, 33, 34 & 35,
TOWNSHIP 8 SOUTH, RANGE 26 EAST
WILLAMETTE MERIDIAN, GRANT COUNTY, OREGON

SURVEY PERFORMED:
APRIL - SEPTEMBER 2014

DRAWN BY: RWF

SHEET 5 of 10

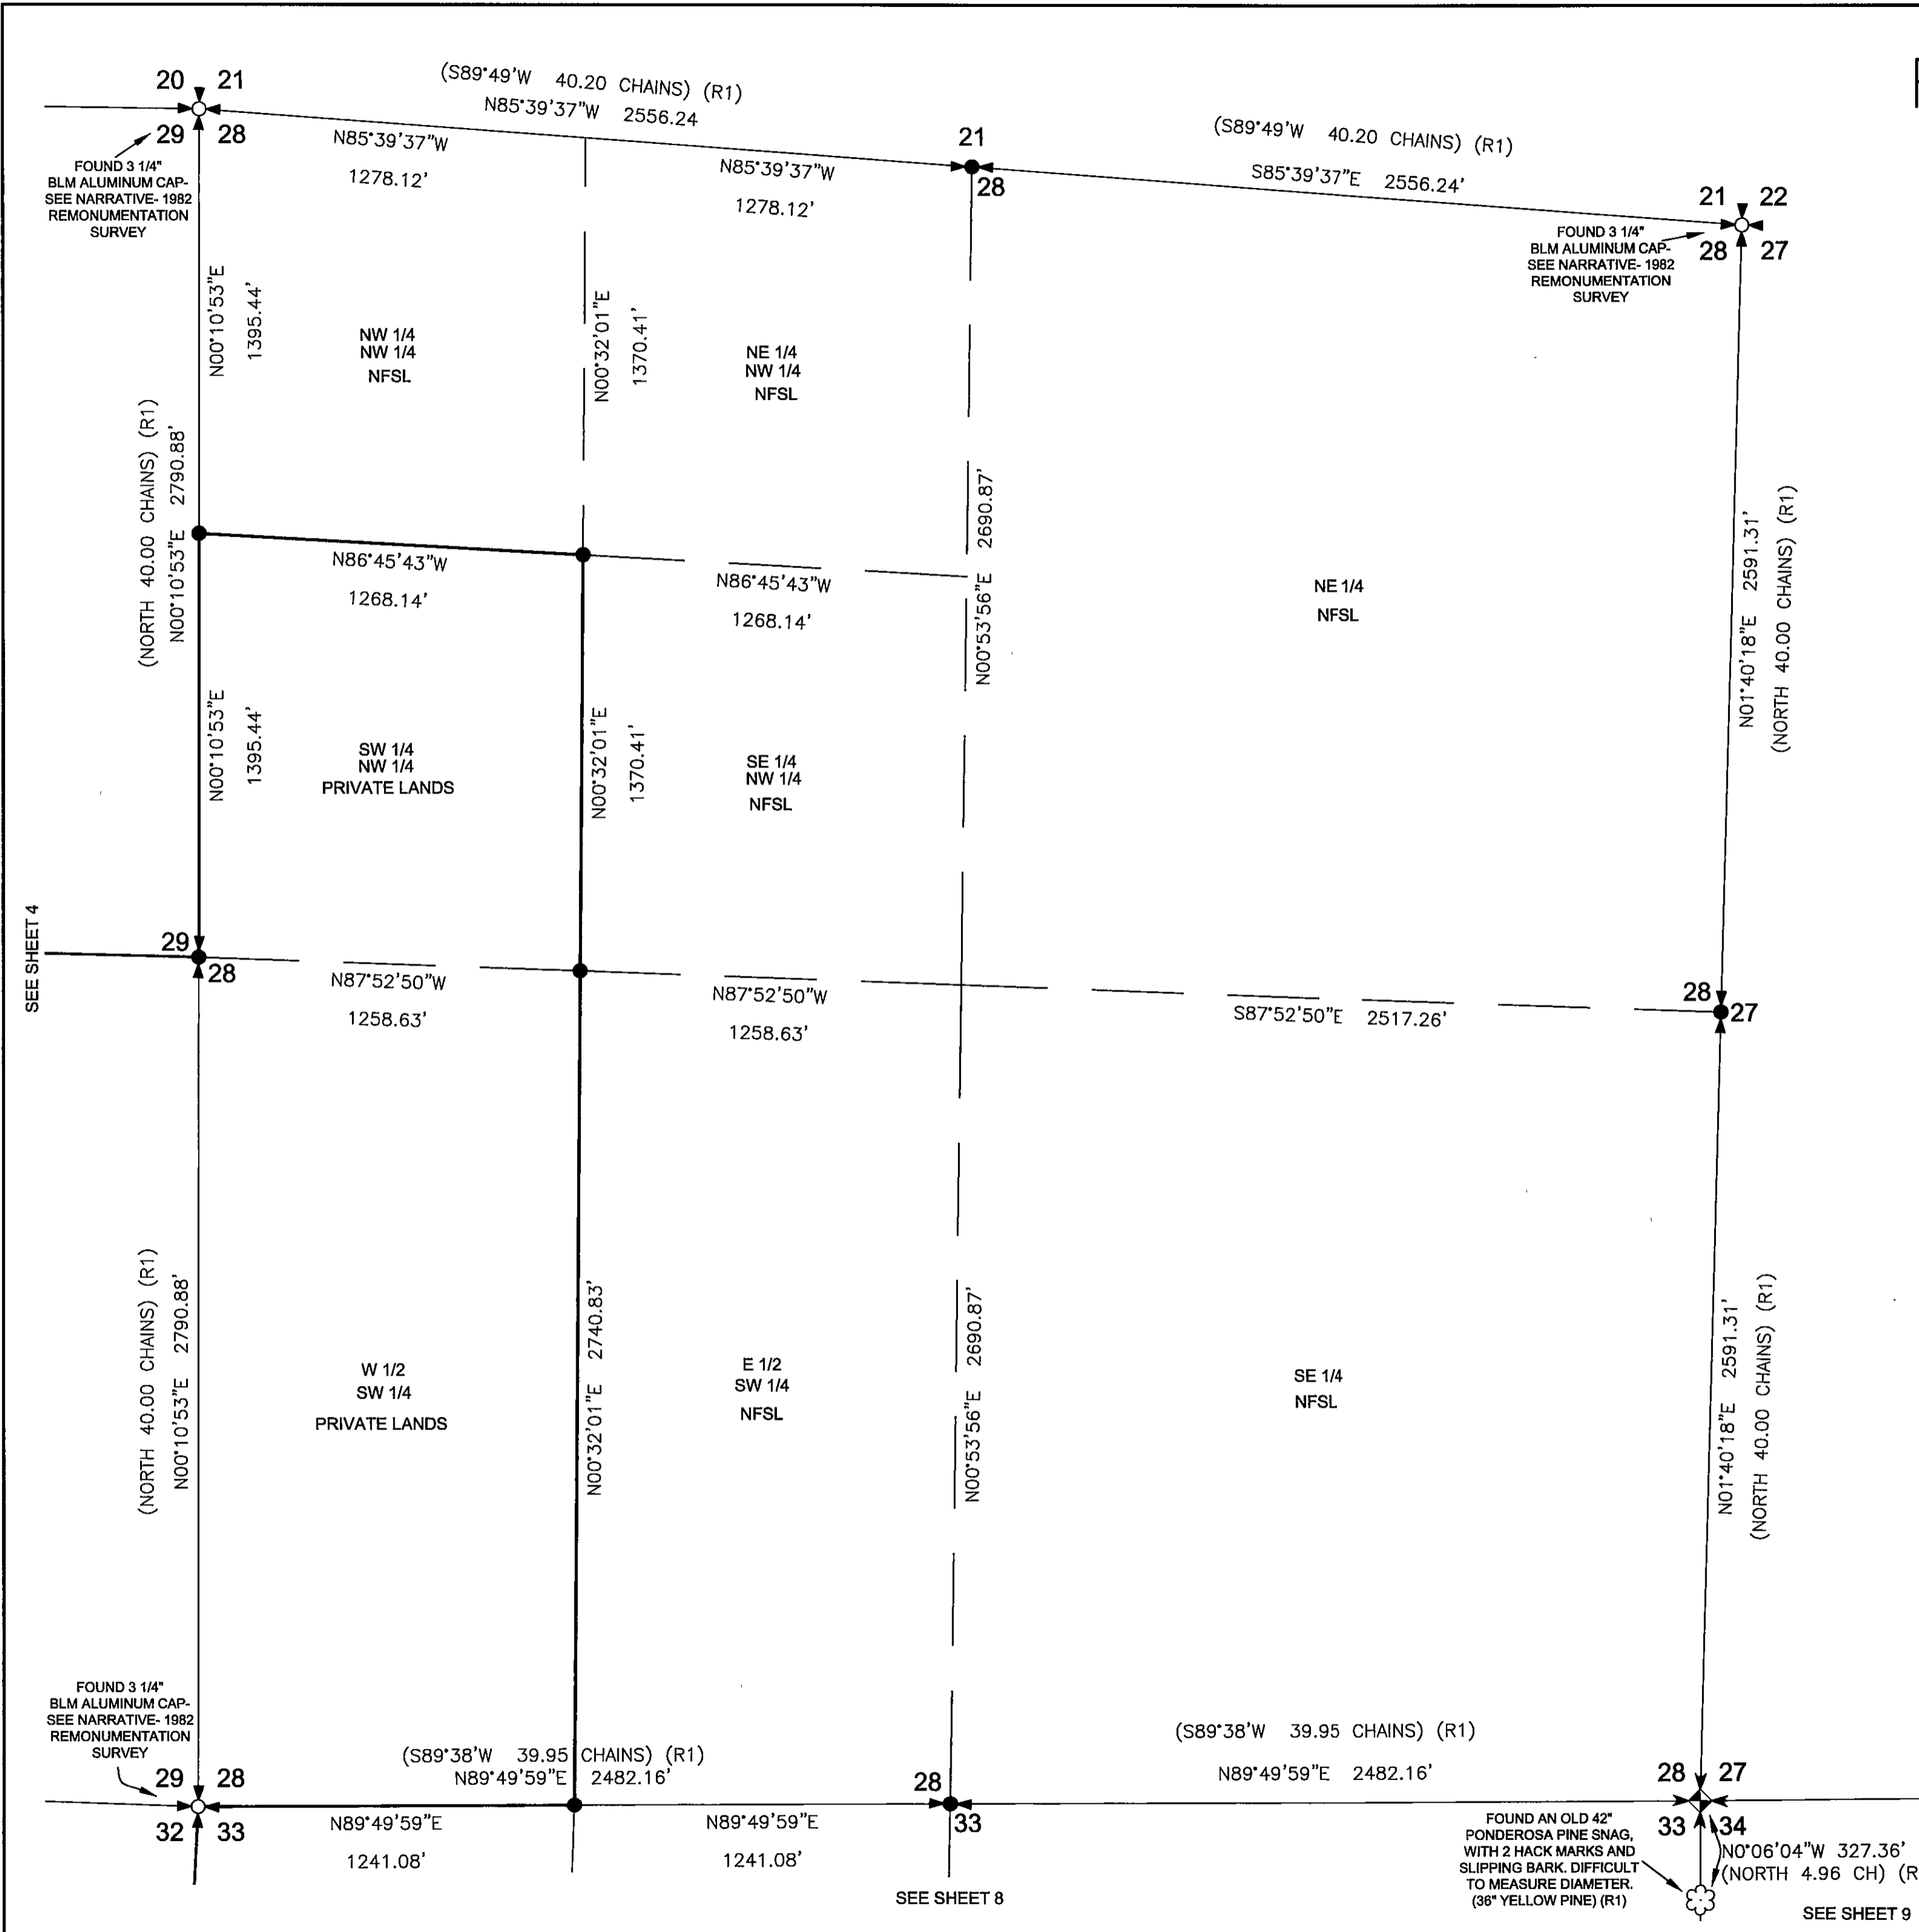

SEE SHEET 4

SEE SHEET 8

SEE SHEET 9

FOUND 3 1/4" BLM ALUMINUM CAP. SEE NARRATIVE- 1982 REMONUMENTATION SURVEY

FOUND 3 1/4" BLM ALUMINUM CAP. SEE NARRATIVE- 1982 REMONUMENTATION SURVEY

FOUND 3 1/4" BLM ALUMINUM CAP. SEE NARRATIVE- 1982 REMONUMENTATION SURVEY

FOUND AN OLD 42" PONDEROSA PINE SNAG, WITH 2 HACK MARKS AND SLIPPING BARK. DIFFICULT TO MEASURE DIAMETER. (36" YELLOW PINE) (R1)