



# RECORD OF SURVEY

SECTIONS 19, 25, 26, 28, 29, 33, 34 & 35,  
TOWNSHIP 8 SOUTH RANGE 26 EAST  
WILLAMETTE MERIDIAN, GRANT COUNTY, OREGON

**LEGEND:**

- DENOTES FOUND MONUMENT AS NOTED
- DENOTES FOUND MONUMENT AS NOTED
- DENOTES SET 3 1/4" ALUMINUM CAP ON 3"x30" PIPE, SET FROM ORIGINAL EVIDENCE
- DENOTES SET 3 1/4" ALUMINUM CAP ON 3"x30" PIPE, SET FROM ORIGINAL EVIDENCE
- DENOTES SET 3 1/4" ALUMINUM CAP ON 3"x30" PIPE, SET BY PROPORTION
- DENOTES SET 3 1/4" ALUMINUM CAP ON 3"x30" PIPE, SET BY PROPORTION
- DENOTES SET 3 1/4" ALUMINUM CAP ON 3"x30" PIPE (UNLESS OTHERWISE NOTED)
- DENOTES FOUND LINE TREE
- (R1) -RECORD MEASUREMENT, GESNER 1877
- (R2) -RECORD MEASUREMENT, GRIFFITH 1984
- PROPERTY BOUNDARY POSTED WITH FOREST SERVICE 54-2 SIGNS
- FENCE LINE
- NFSL -NATIONAL FOREST SYSTEM LANDS
- BLM -BUREAU OF LAND MANAGEMENT

REGISTERED  
PROFESSIONAL  
LAND SURVEYOR  
*Mark A. Lichtenthaler*  
OREGON  
JANUARY 18, 1994  
MARK A. LICHTENTHALER  
2645  
EXPIRES 12-31-2016

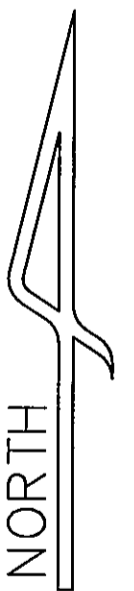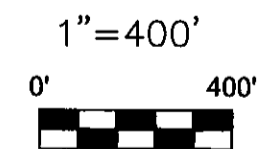

UNITED STATES DEPARTMENT OF AGRICULTURE  
**FOREST SERVICE**  
REGION 6 - UMATILLA NATIONAL FOREST

SURVEY FOR THE UMATILLA NATIONAL FOREST  
KAHLER DRY FOREST RESTORATION PROJECT  
LOCATED IN SECTIONS  
19, 25, 26, 28, 29, 33, 34 & 35,  
TOWNSHIP 8 SOUTH, RANGE 26 EAST  
WILLAMETTE MERIDIAN, GRANT COUNTY, OREGON

SURVEY PERFORMED:  
APRIL - SEPTEMBER 2014

DRAWN BY: RWF

SHEET 9 of 10

SEE SHEET 5

(S89°51'W 40.09 CHAINS) (R1)  
S89°36'08"W 2594.02'

(S89°51'W 40.09 CHAINS) (R1)  
S89°36'08"W 2594.02'

SEE SHEET 6

28 27

27

27 26

33 34

34

34 35

N0°06'04"W 327.36'  
(NORTH 4.96 CH) (R1)

FOUND AN OLD 42"  
PONDEROSA PINE SNAG,  
WITH 2 HACK MARKS AND  
SLIPPING BARK. DIFFICULT  
TO MEASURE DIAMETER.  
(36" YELLOW PINE) (R1)

N00°06'04"W 2282.43'  
(NORTH 35.04 CHAINS) (R1)

NW 1/4  
NFSL

NE 1/4  
NFSL

N01°30'16"E 2611.16'

N00°59'00"E 2612.80'  
(NORTH 40.00 CHAINS) (R1)

SEE SHEET 8

33 34

34 35

N89°37'40"E 2520.80'

N89°37'40"E 2617.77'

N 1/2  
SW 1/4  
NFSL

N00°06'04"W 1302.75'

N01°30'16"E 1271.98'

N00°59'00"E 2612.80'  
(NORTH 40.00 CHAINS) (R1)

S88°54'11"W 2485.51'

SE 1/4  
NFSL

N00°06'04"W 1302.75'

N01°30'16"E 1271.98'

S 1/2  
SW 1/4  
PRIVATE LANDS

N88°09'47"E 2450.37'  
(EAST 40.00 CHAINS) (R1)

S88°51'51"E 2640.19'  
(EAST 40.00 CHAINS) (R1)

PRIVATE LANDS

FOUND 2 1/2"  
ALUMINUM CAP- SEE  
NARRATIVE- SURVEY #827

33 34

34 35

FOUND 3 1/4"  
BLM ALUMINUM CAP-  
SEE NARRATIVE- 1982  
REMONUMENTATION SURVEY