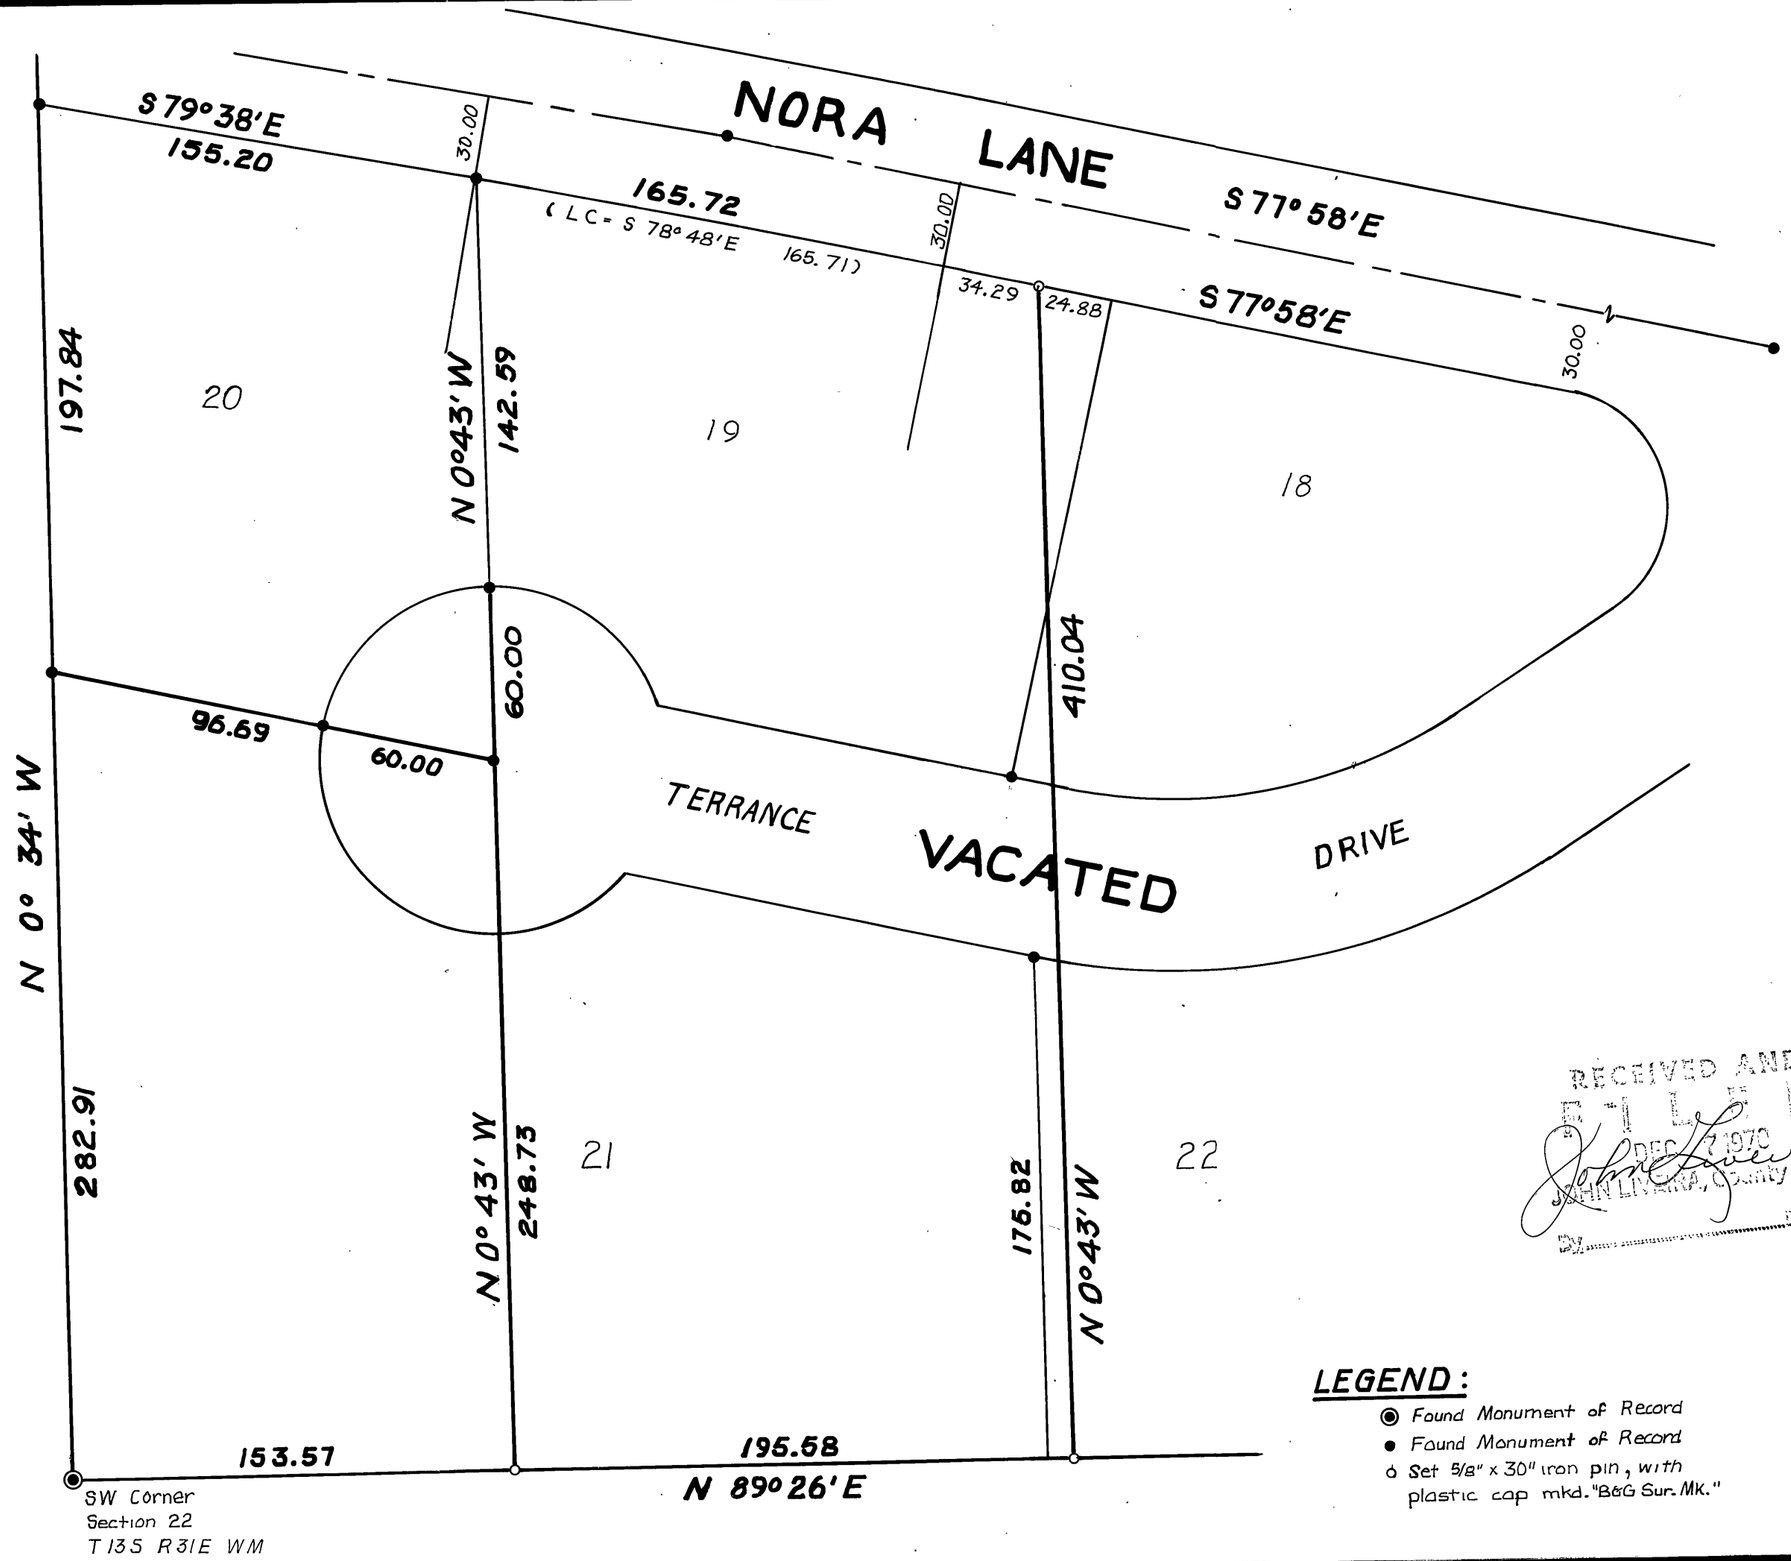

N

BASIS OF BEARING

℄ Nora Lane
P.I. R-16 to P.I. R-13

REGISTERED
OREGON
LAND SURVEYOR
Duane I. Griffith
JULY 10, 1964
DUANE I. GRIFFITH
644

RECEIVED AND
FILED
DEC 7 1970
John Lovera
JOHN LOVERA, County Clerk
By ..... Deputy

LEGEND:

- ◉ Found Monument of Record
- ● Found Monument of Record
- ó Set 5/8" x 30" iron pin, with plastic cap mkd. "B&G Sur. Mk."

BAGETT-GRIFFITH-FERGUSON
John Day, Oregon

Map of Survey
PORTIONS OF
LOTS 18-19-21 & 22
HALL ACRES SUBDIVISION
GRANT COUNTY, OREGON

SURVEYED FOR	BILL ZICKLER	
SURVEYED BY	D.I.G.	Nov. 1970
Scale: 1" = 50'	Drawn by: T.D.G.	Nov. 1970

Map of Survey # 203