


NW 1/4 SEC. 26, T. 13 S., R. 31 E., W.M.

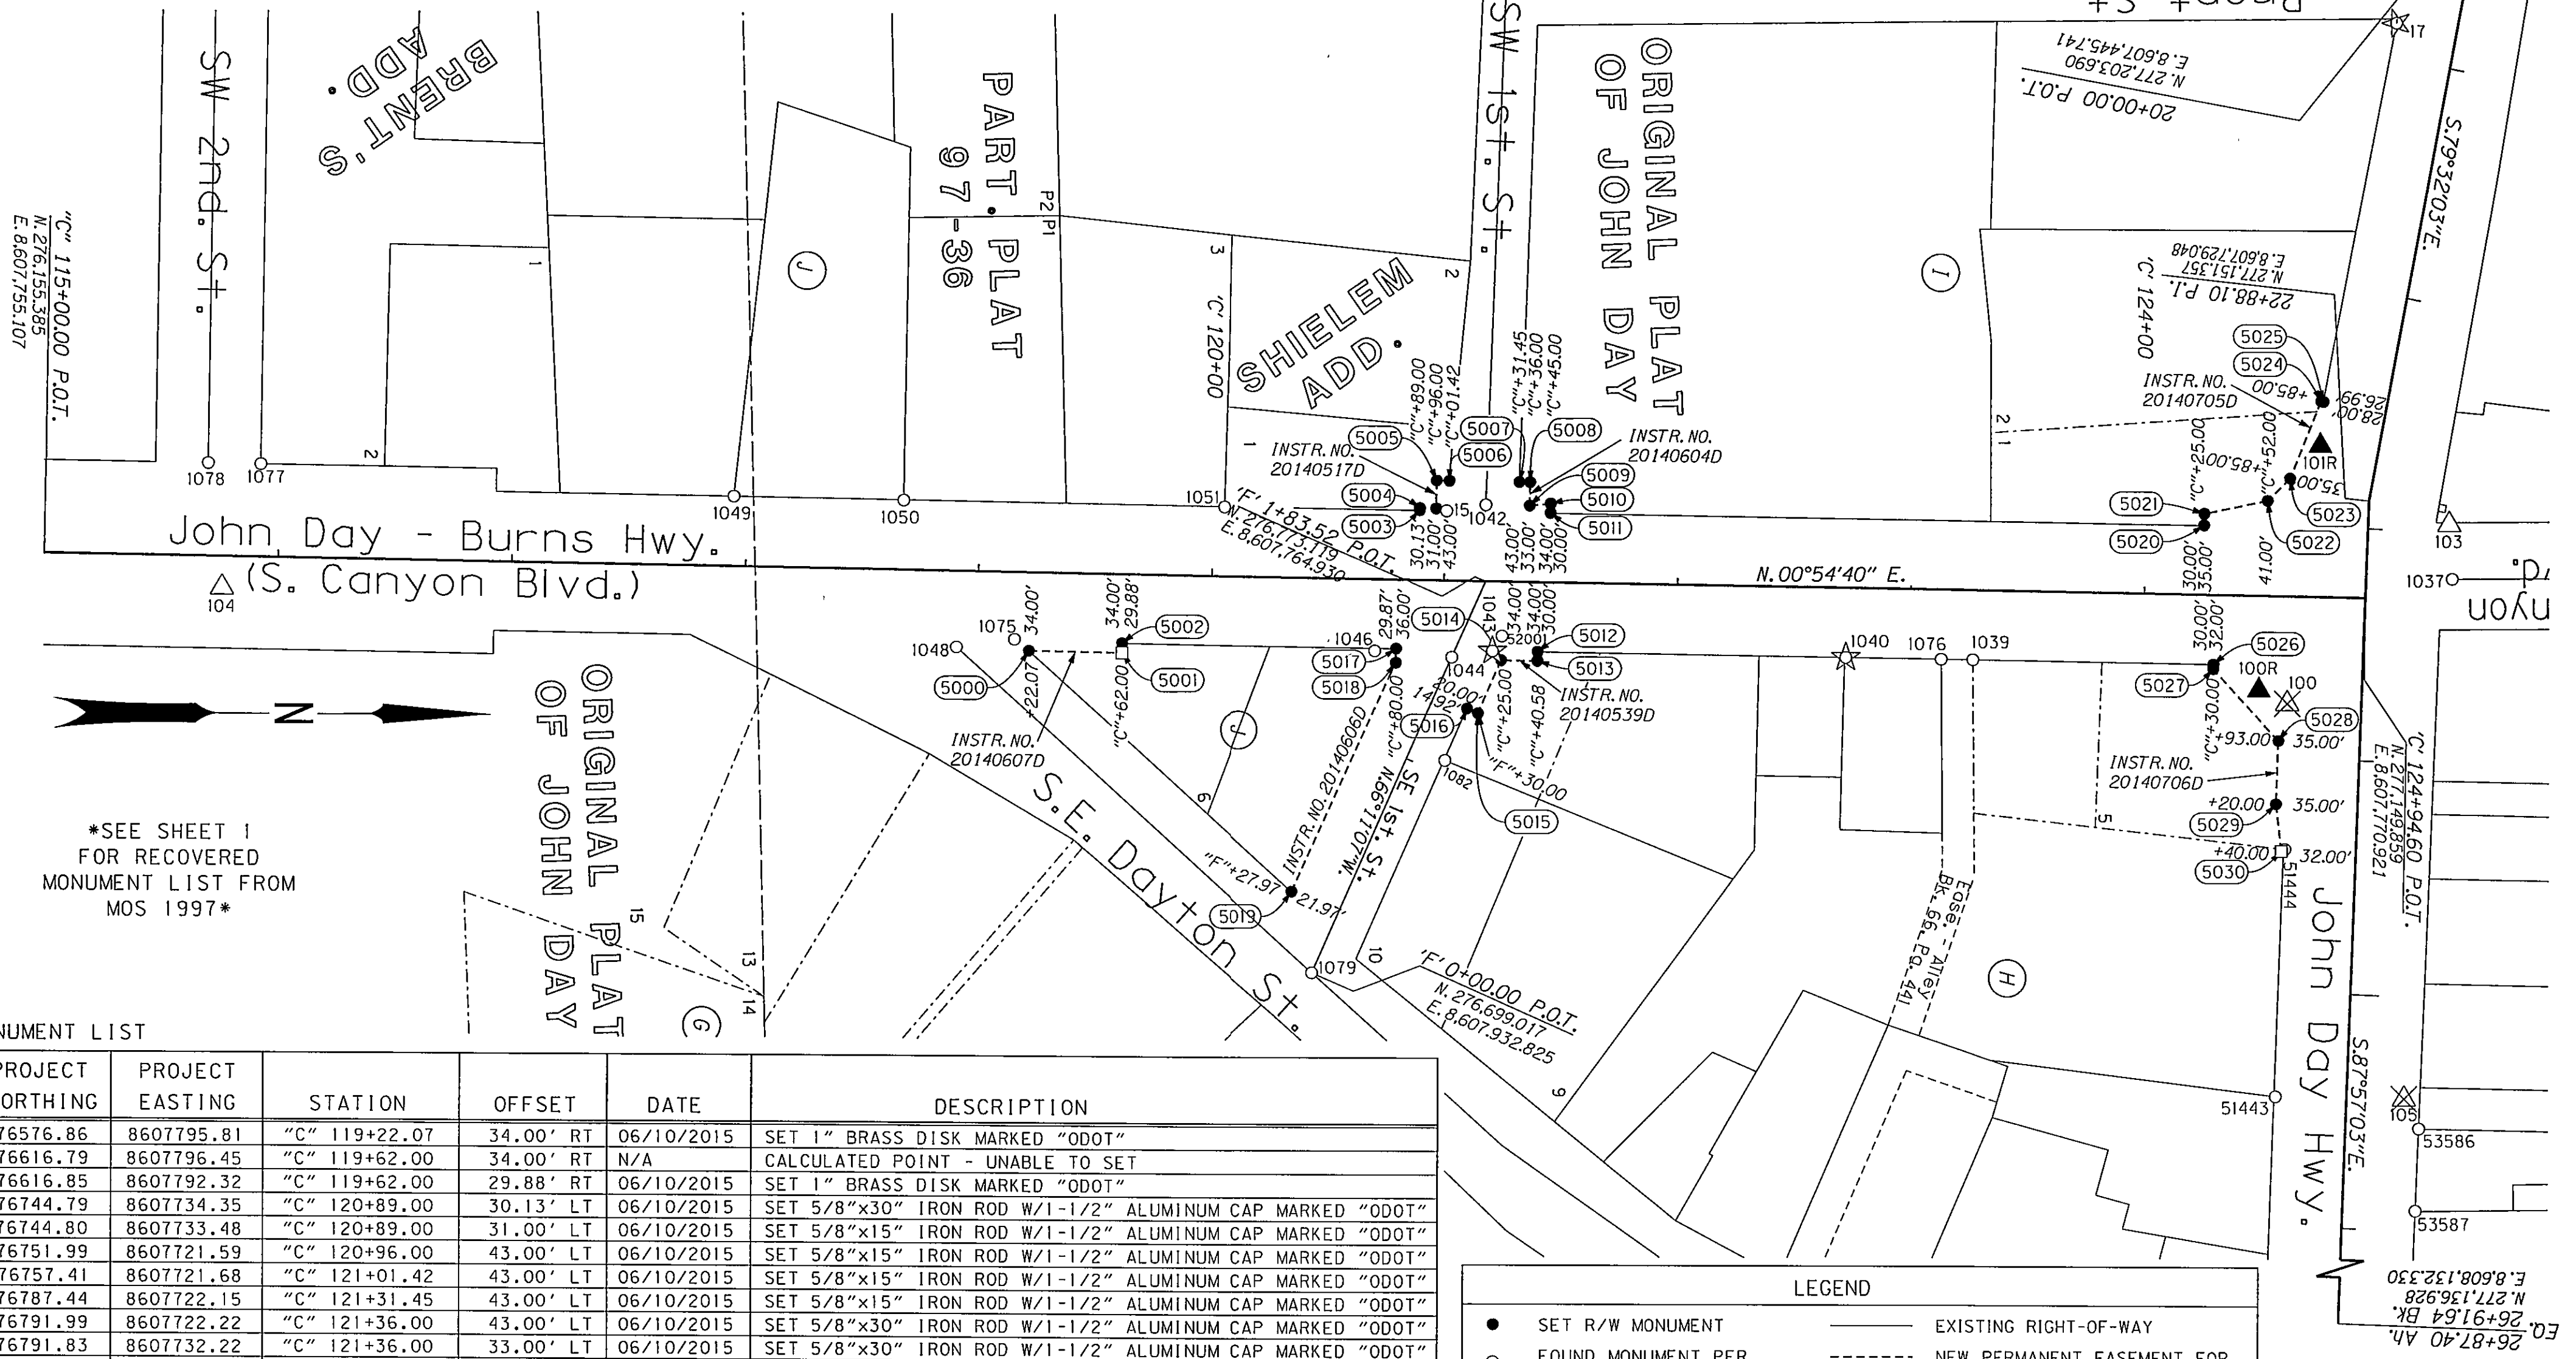

*SEE SHEET 1
FOR RECOVERED
MONUMENT LIST FROM
MOS 1997*

SET MONUMENT LIST

PT ID	PROJECT NORTHING	PROJECT EASTING	STATION	OFFSET	DATE	DESCRIPTION
5000	276576.86	8607795.81	"C" 119+22.07	34.00' RT	06/10/2015	SET 1" BRASS DISK MARKED "ODOT"
5001	276616.79	8607796.45	"C" 119+62.00	34.00' RT	N/A	CALCULATED POINT - UNABLE TO SET
5002	276616.85	8607792.32	"C" 119+62.00	29.88' RT	06/10/2015	SET 1" BRASS DISK MARKED "ODOT"
5003	276744.79	8607734.35	"C" 120+89.00	30.13' LT	06/10/2015	SET 5/8"x30" IRON ROD W/1-1/2" ALUMINUM CAP MARKED "ODOT"
5004	276744.80	8607733.48	"C" 120+89.00	31.00' LT	06/10/2015	SET 5/8"x15" IRON ROD W/1-1/2" ALUMINUM CAP MARKED "ODOT"
5005	276751.99	8607721.59	"C" 120+96.00	43.00' LT	06/10/2015	SET 5/8"x15" IRON ROD W/1-1/2" ALUMINUM CAP MARKED "ODOT"
5006	276757.41	8607721.68	"C" 121+01.42	43.00' LT	06/10/2015	SET 5/8"x15" IRON ROD W/1-1/2" ALUMINUM CAP MARKED "ODOT"
5007	276787.44	8607722.15	"C" 121+31.45	43.00' LT	06/10/2015	SET 5/8"x15" IRON ROD W/1-1/2" ALUMINUM CAP MARKED "ODOT"
5008	276791.99	8607722.22	"C" 121+36.00	43.00' LT	06/10/2015	SET 5/8"x30" IRON ROD W/1-1/2" ALUMINUM CAP MARKED "ODOT"
5009	276791.83	8607732.22	"C" 121+36.00	33.00' LT	06/10/2015	SET 5/8"x30" IRON ROD W/1-1/2" ALUMINUM CAP MARKED "ODOT"
5010	276800.84	8607731.37	"C" 121+45.00	34.00' LT	06/10/2015	SET 5/8"x30" IRON ROD W/1-1/2" ALUMINUM CAP MARKED "ODOT"
5011	276800.78	8607735.37	"C" 121+45.00	30.00' LT	06/10/2015	SET 5/8"x30" IRON ROD W/1-1/2" ALUMINUM CAP MARKED "ODOT"
5012	276795.41	8607795.29	"C" 121+40.58	30.00' RT	06/10/2015	SET 1" BRASS DISK MARKED "ODOT"
5013	276795.35	8607799.29	"C" 121+40.58	34.00' RT	06/10/2015	SET 5/8"x30" IRON ROD W/1-1/2" ALUMINUM CAP MARKED "ODOT"
5014	276779.77	8607799.04	"C" 121+25.00	34.00' RT	06/10/2015	SET 5/8"x30" IRON ROD W/1-1/2" ALUMINUM CAP MARKED "ODOT"
5015	276769.81	8607821.97	"F" 1+30.00	20.00' RT	06/10/2015	SET 5/8"x30" IRON ROD W/1-1/2" ALUMINUM CAP MARKED "ODOT"
5016	276765.16	8607819.92	"F" 1+30.00	14.92' RT	06/10/2015	SET 5/8"x30" IRON ROD W/1-1/2" ALUMINUM CAP MARKED "ODOT"
5017	276734.84	8607794.20	"C" 120+80.00	29.87' RT	06/10/2015	SET 1" BRASS DISK MARKED "ODOT"
5018	276734.74	8607800.32	"C" 120+80.00	36.00' RT	06/10/2015	SET 5/8"x18" IRON ROD W/1-1/2" ALUMINUM CAP MARKED "ODOT"
5019	276690.21	8607898.36	"F" 0+27.97	21.97' RT	06/10/2015	SET 5/8"x30" IRON ROD W/1-1/2" ALUMINUM CAP MARKED "ODOT"
5020	277080.74	8607739.82	"C" 124+25.00	30.00' LT	06/10/2015	SET 5/8"x30" IRON ROD W/1-1/2" ALUMINUM CAP MARKED "ODOT"
5021	277080.82	8607734.82	"C" 124+25.00	35.00' LT	06/10/2015	SET 5/8"x30" IRON ROD W/1-1/2" ALUMINUM CAP MARKED "ODOT"
5022	277107.92	8607729.25	"C" 124+52.00	41.00' LT	06/10/2015	SET 5/8"x30" IRON ROD W/1-1/2" ALUMINUM CAP MARKED "ODOT"
5023	277117.50	8607719.64	22+85.00	35.00' RT	06/10/2015	SET 5/8"x30" IRON ROD W/1-1/2" ALUMINUM CAP MARKED "ODOT"
5024	277130.74	8607686.50	22+50.00	28.00' RT	06/10/2015	SET 5/8"x30" IRON ROD W/1-1/2" ALUMINUM CAP MARKED "ODOT"
5025	277131.74	8607686.68	22+50.00	26.99' RT	06/10/2015	SET 5/8"x30" IRON ROD W/1-1/2" ALUMINUM CAP MARKED "ODOT"
5026	277084.79	8607799.89	"C" 124+30.00	30.00' RT	06/10/2015	SET 1" BRASS DISK MARKED "ODOT"
5027	277084.76	8607801.89	"C" 124+30.00	32.00' RT	06/10/2015	SET 5/8"x30" IRON ROD W/1-1/2" ALUMINUM CAP MARKED "ODOT"
5028	277112.63	8607832.63	23+93.00	35.00' RT	06/10/2015	SET 5/8"x30" IRON ROD W/1-1/2" ALUMINUM CAP MARKED "ODOT"
5029	277111.66	8607859.61	24+20.00	35.00' RT	06/10/2015	SET 5/8"x30" IRON ROD W/1-1/2" ALUMINUM CAP MARKED "ODOT"
5030	277113.95	8607879.71	24+40.00	32.00' RT	N/A	CALCULATED POINT

LEGEND	
●	SET R/W MONUMENT
○	FOUND MONUMENT PER MOS 1997, SEE TABLE ON SHEET 1
☆	FOUND MONUMENT USED AS GPS POINT
△	FOUND NETWORK POINT PER MOS 1997
×	DESTROYED
□	CALCULATED POINT - NOTHING FOUND OR SET
—	EXISTING RIGHT-OF-WAY
- - -	NEW PERMANENT EASEMENT FOR HIGHWAY RIGHT OF WAY PURPOSES
MOS	MAP OF SURVEY
()	RIGHT-OF-WAY POINT NO.
()	RECORD DATA PER MOS 1997

REGISTERED
PROFESSIONAL
LAND SURVEYOR

BQc
OREGON
JAN. 14, 2003
BRET N. ELITHORP
63148
RENEWAL: DEC. 31, 2015
SIGNED: 7/8/15

OREGON DEPARTMENT OF TRANSPORTATION
RIGHT OF WAY MONUMENTATION SURVEY
US26: MAIN ST. & CANYON BLVD. SIDEWALK BEAUTIFICATION
US26: JOHN DAY HIGHWAY NO. 005
US395: JOHN DAY - BURNS HIGHWAY NO. 48
CITY OF JOHN DAY
GRANT COUNTY
FOR ODOT REGION 5
3012 ISLAND AVE.
LA GRANDE, OR 97850
JULY 8, 2015
SCALE: 1" = 50'
SHEET 2 OF 2