


NE 1/4 SECTION 16 T18S R32E WM
SE 1/4 SECTION 16 T18S R32E WM
NW 1/4 SECTION 16 T18S R32E WM
SW 1/4 SECTION 16 T18S R32E WM

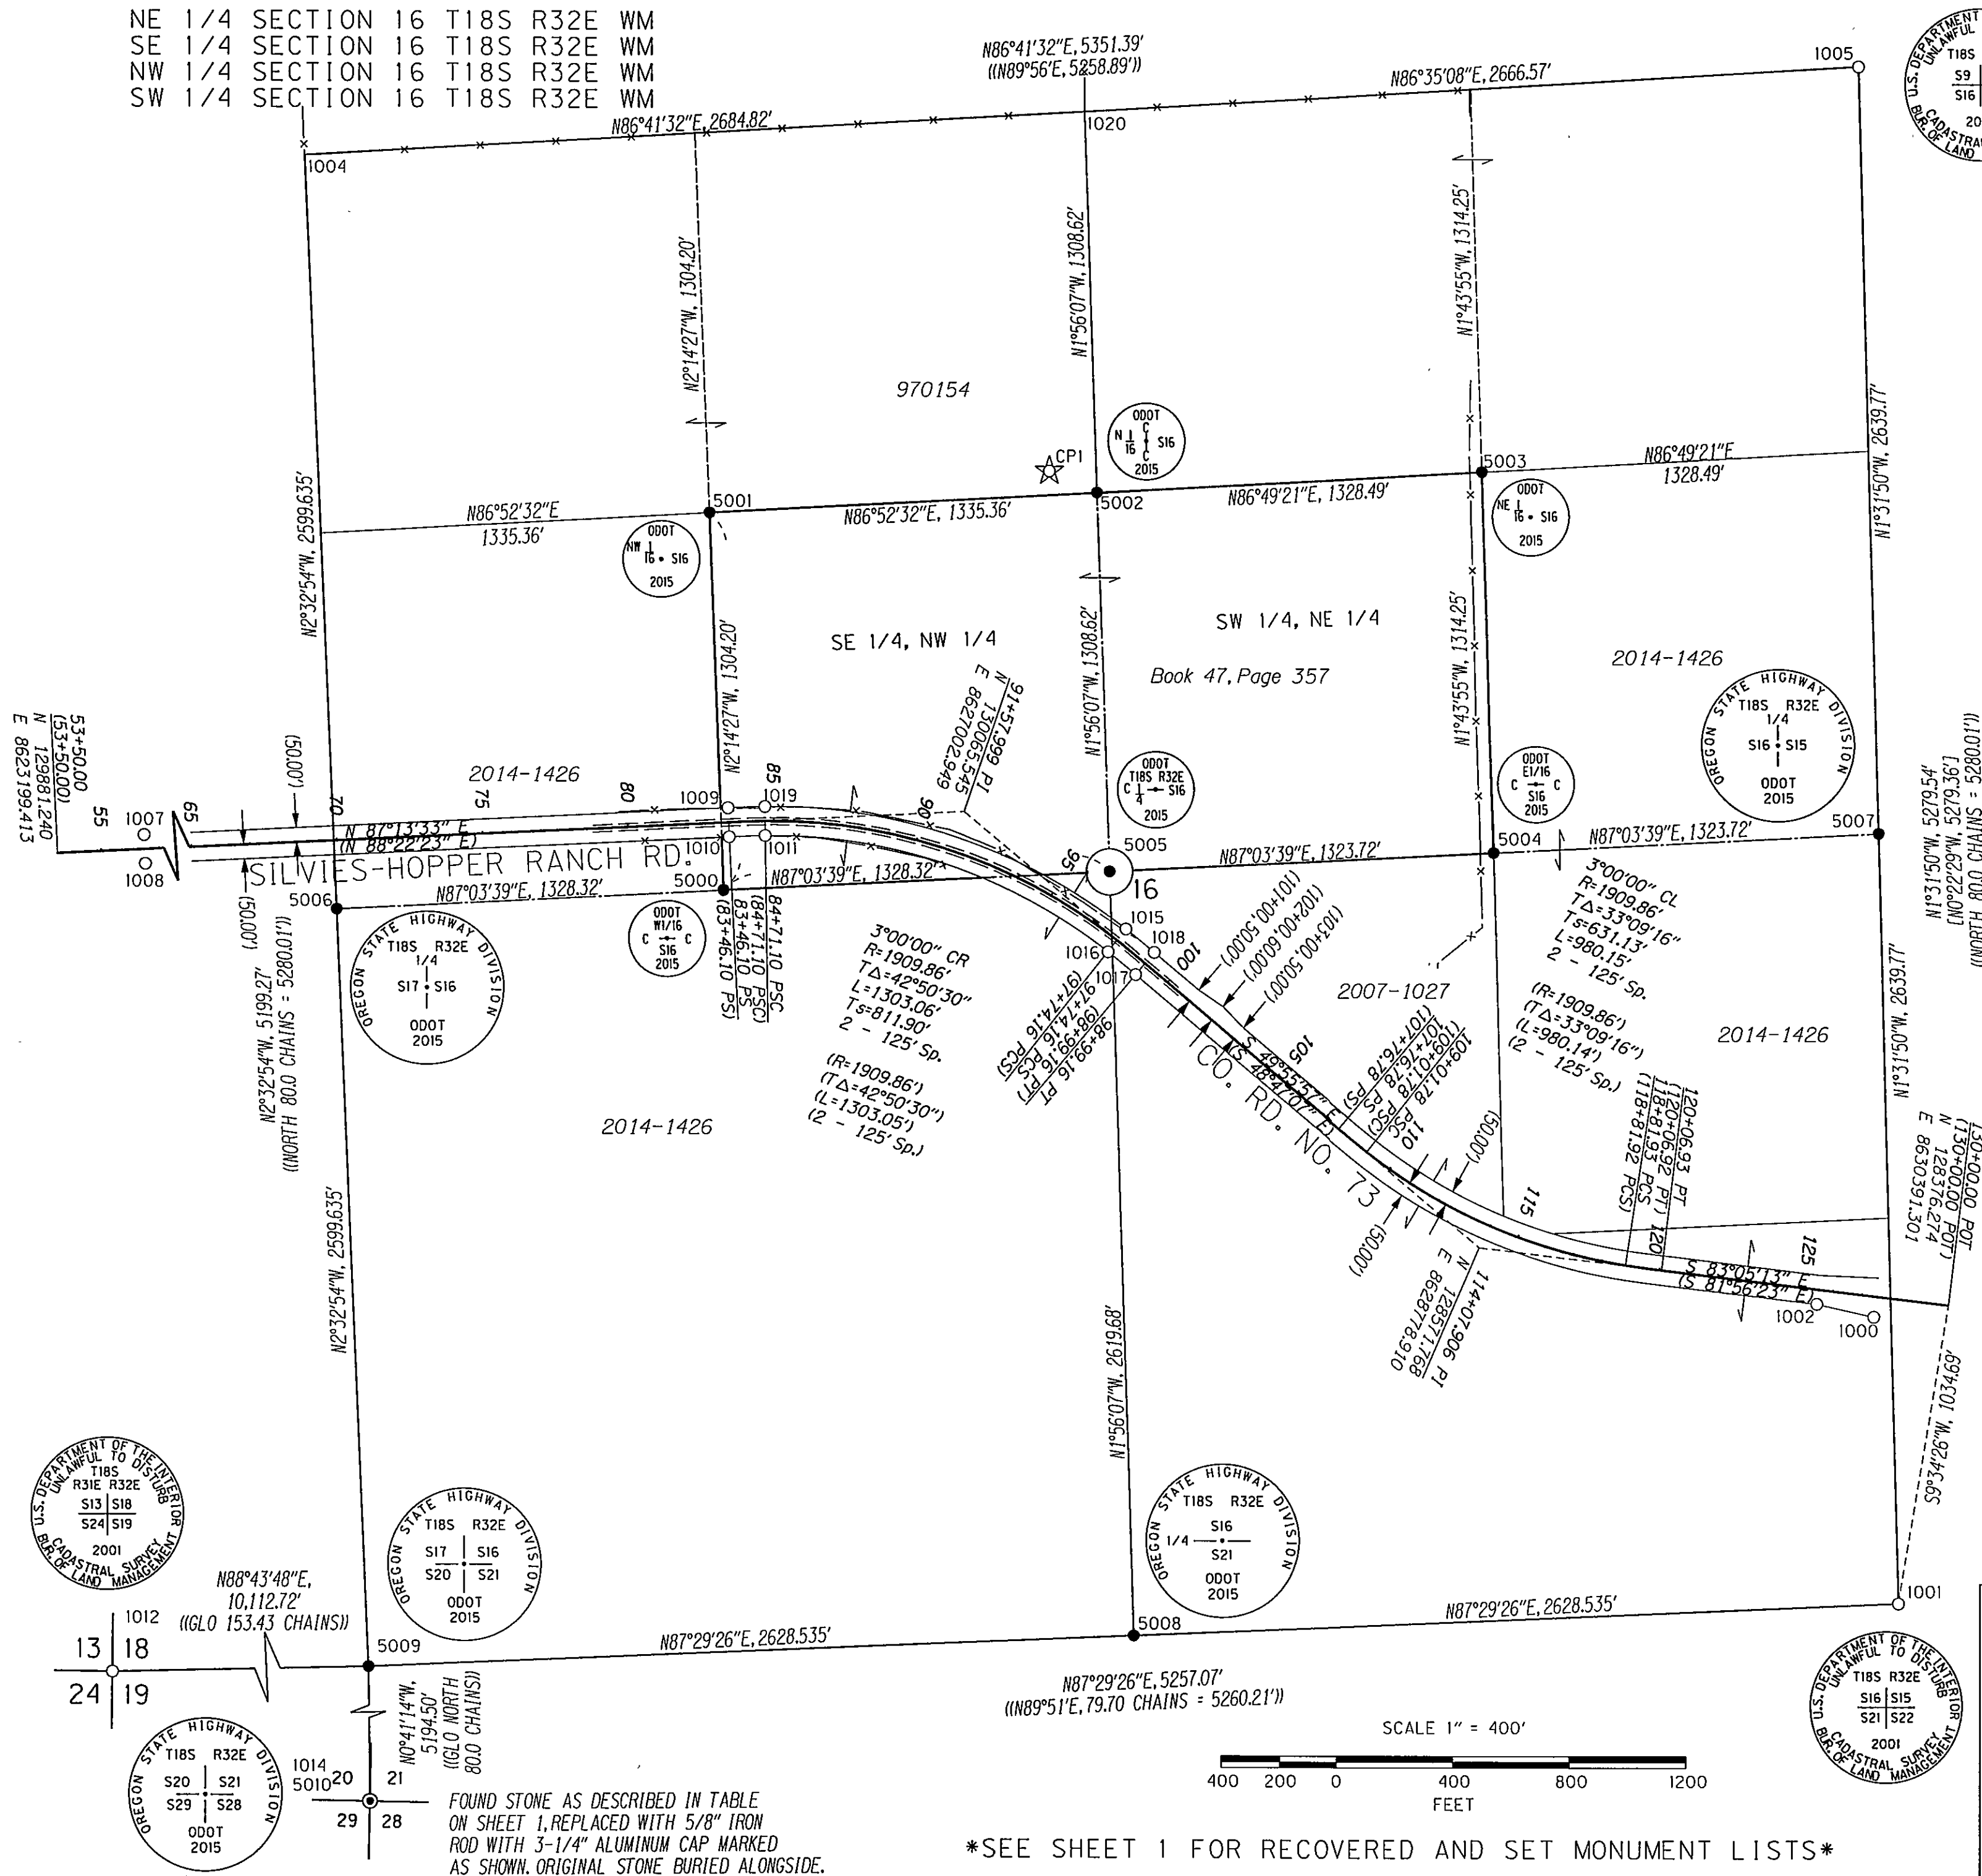

LEGEND	
()	RECORD DATA PER COUNTY SURVEY 1138
[]	RECORD DATA PER COUNTY SURVEY 1718
(())	RECORD DATA PER GLO CONTRACT NO. 489
○	FOUND MONUMENT NOTED IN TABLE ON SHEET 1
●	FOUND MONUMENT REPLACED AS DESCRIBED IN TABLE ON SHEET 1
●	SET MONUMENT NOTED IN TABLE ON SHEET 1
☆	FOUND GPS STATION
—	RESOLVED BOUNDARY
—	EXISTING RIGHT OF WAY OR PROPERTY LINE
—	EDGE OF PAVEMENT
—x—	EXISTING FENCE

REGISTERED PROFESSIONAL LAND SURVEYOR

BRET N. ELITHORP
OREGON
JANUARY 14, 2003
BRET N. ELITHORP
63148

EXPIRES: DEC. 31, 2015

OREGON DEPARTMENT OF TRANSPORTATION
BOUNDARY SURVEY
SILVIE-HOPPER RANCH ROAD
SILVIE-HOPPER RANCH ROAD (COUNTY ROAD NO. 73)
GRANT COUNTY

FOR ODOT REGION 5
3012 ISLAND AVENUE
LA GRANDE, OR 97850



JULY 29, 2015
1"=400'
SHEET 2 OF 2

SEE SHEET 1 FOR RECOVERED AND SET MONUMENT LISTS