
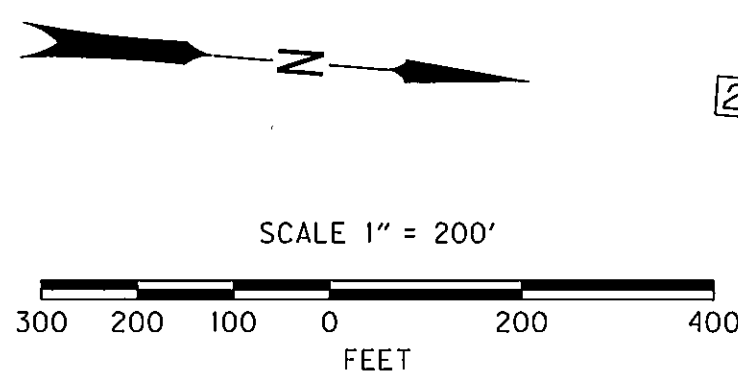


NW 1/4 SEC. 26 & SW 1/4 SEC. 23 T.17S. R.31E. W.M.

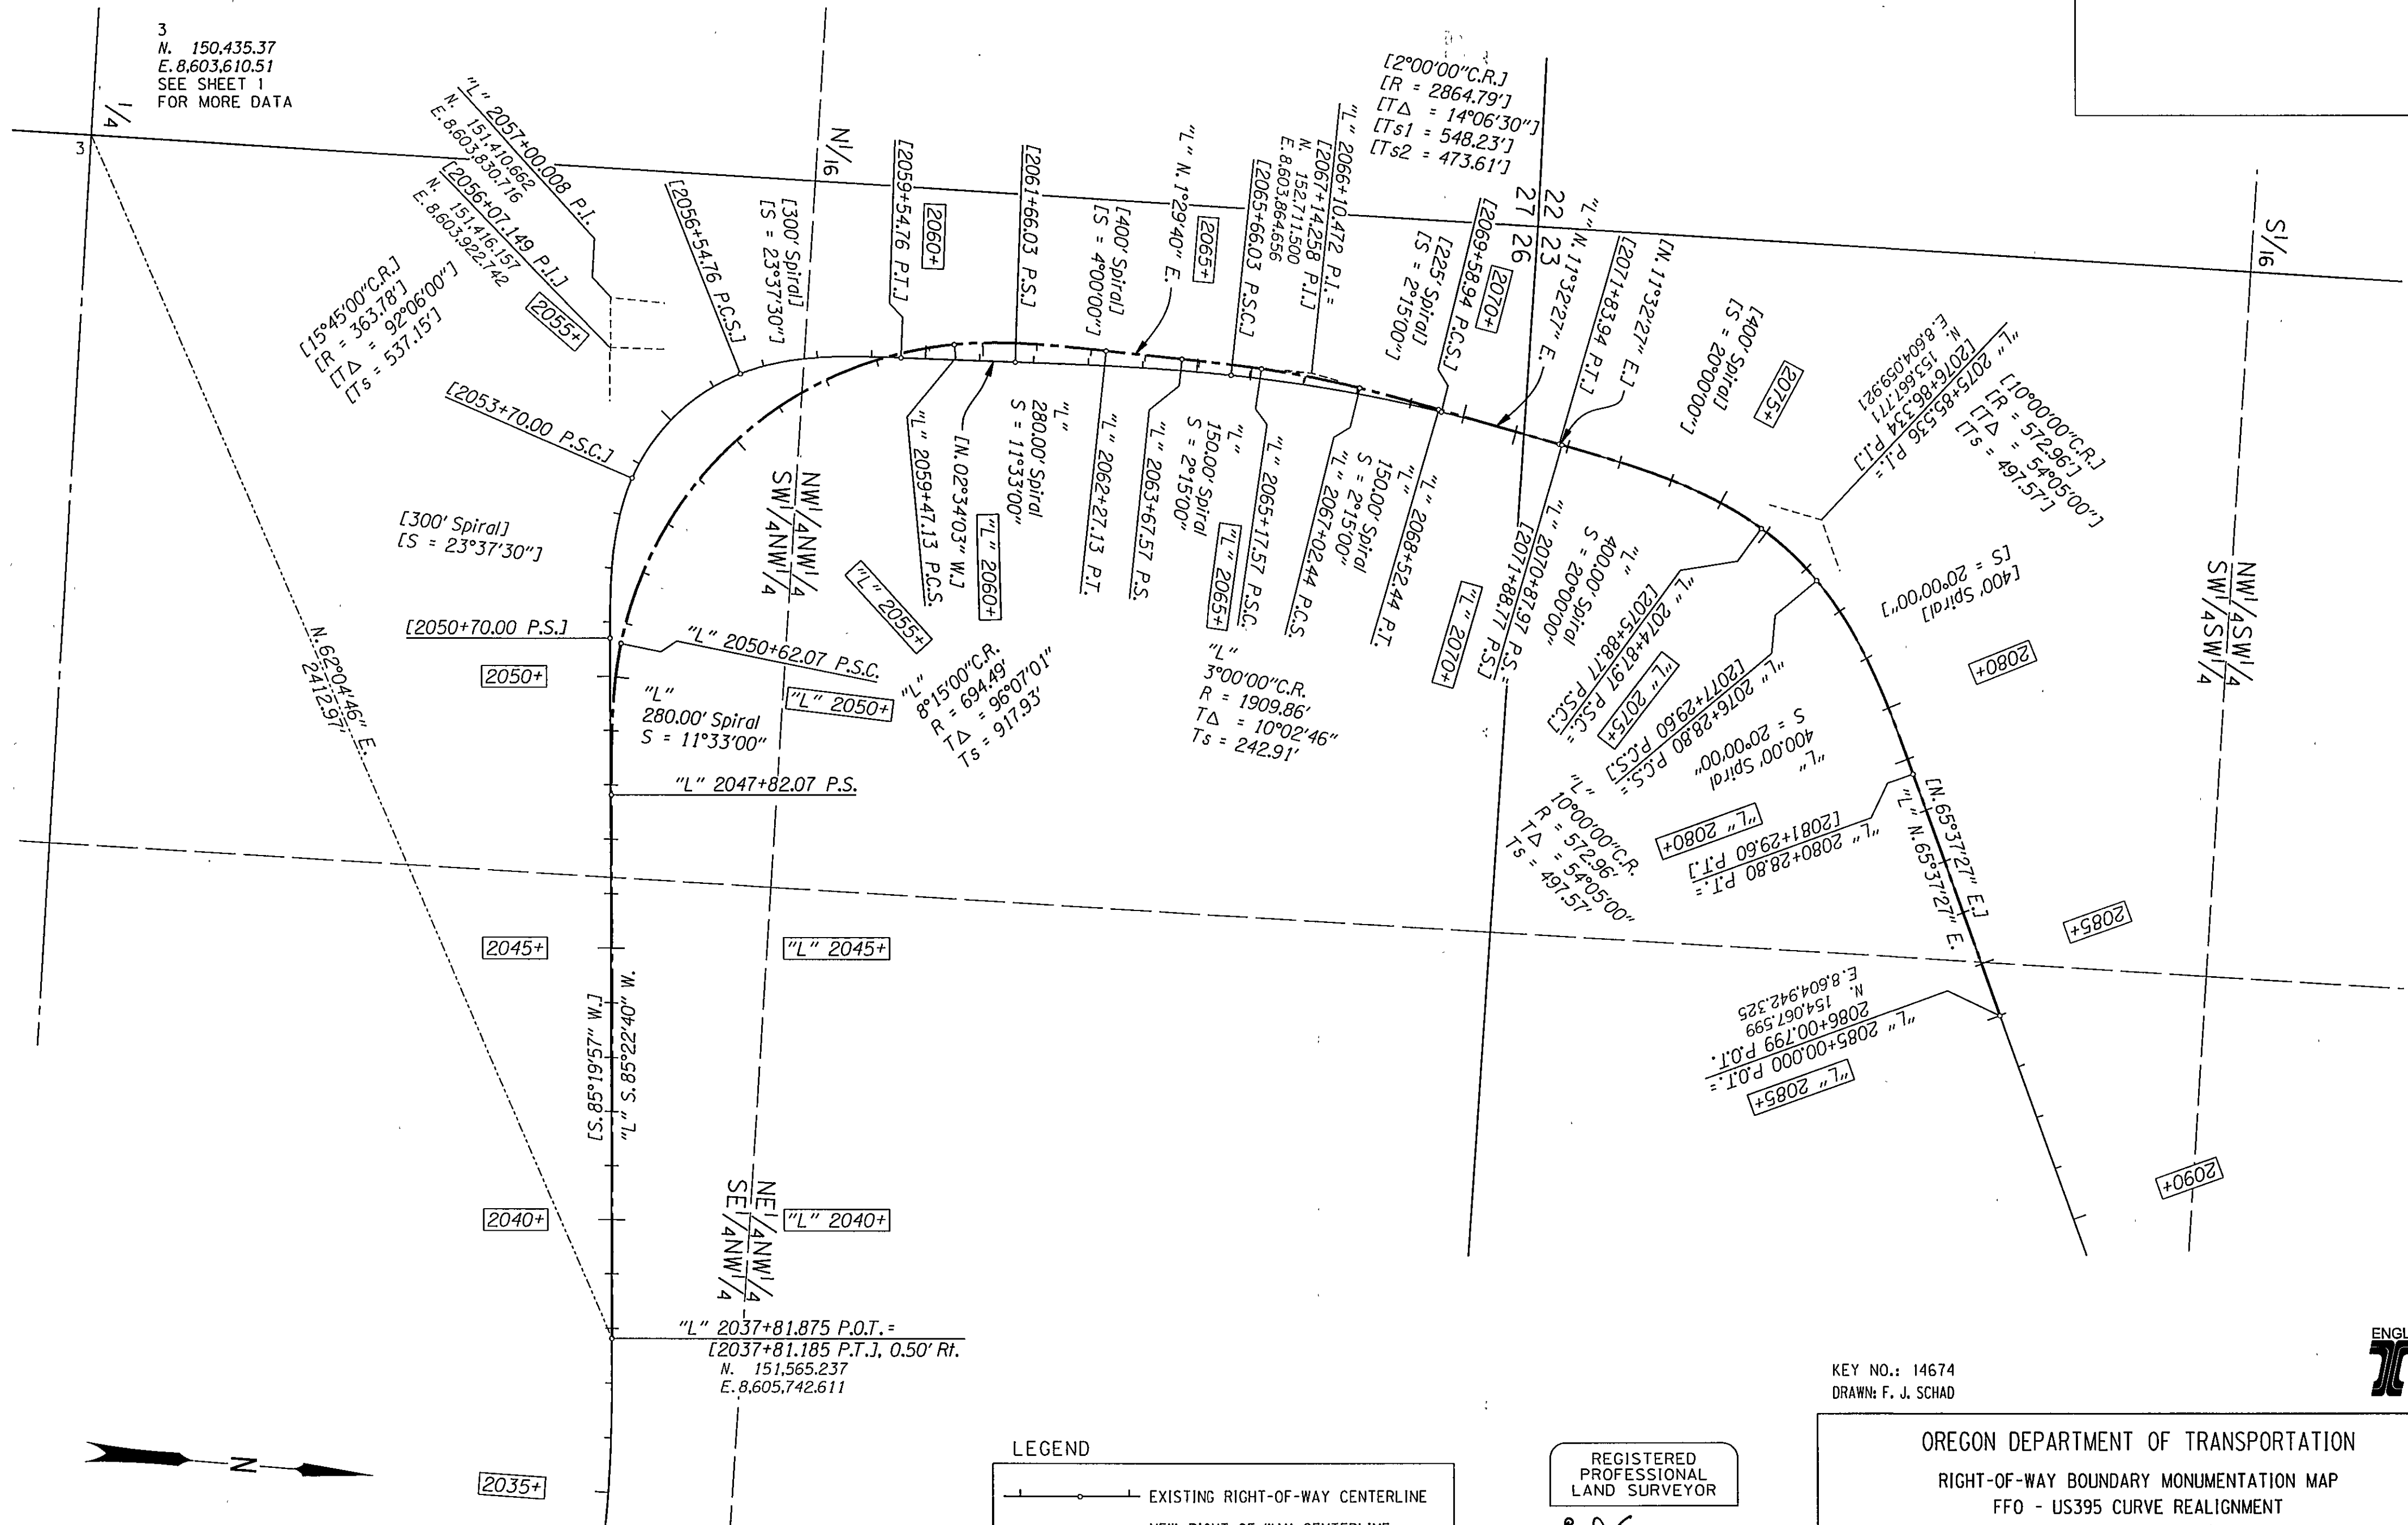

LEGEND

	EXISTING RIGHT-OF-WAY CENTERLINE
	NEW RIGHT-OF-WAY CENTERLINE
	BEARING & DISTANCE TIE
[]	RECORD DATA AS PER S1, SEE SHEET 1 REFERENCE TABLE

REGISTERED
PROFESSIONAL
LAND SURVEYOR

B J C

OREGON
JANUARY 14, 2003
BRET N. ELITHORP
63148

RENEWS DEC. 31, 2015

KEY NO.: 14674
DRAWN: F. J. SCHAD

OREGON DEPARTMENT OF TRANSPORTATION

RIGHT-OF-WAY BOUNDARY MONUMENTATION MAP

FFO - US395 CURVE REALIGNMENT

JOHN DAY - BURNS HIGHWAY NO. 48 (U.S. HWY. 395)

MILEPOINT 31

GRANT COUNTY

ODOT REGION 5
3012 ISLAND AVE.
LA GRANDE, OR 97850

SEPTEMBER 8, 2015
SCALE: 1 in. = 200 ft.
Sheet 2 of 5