
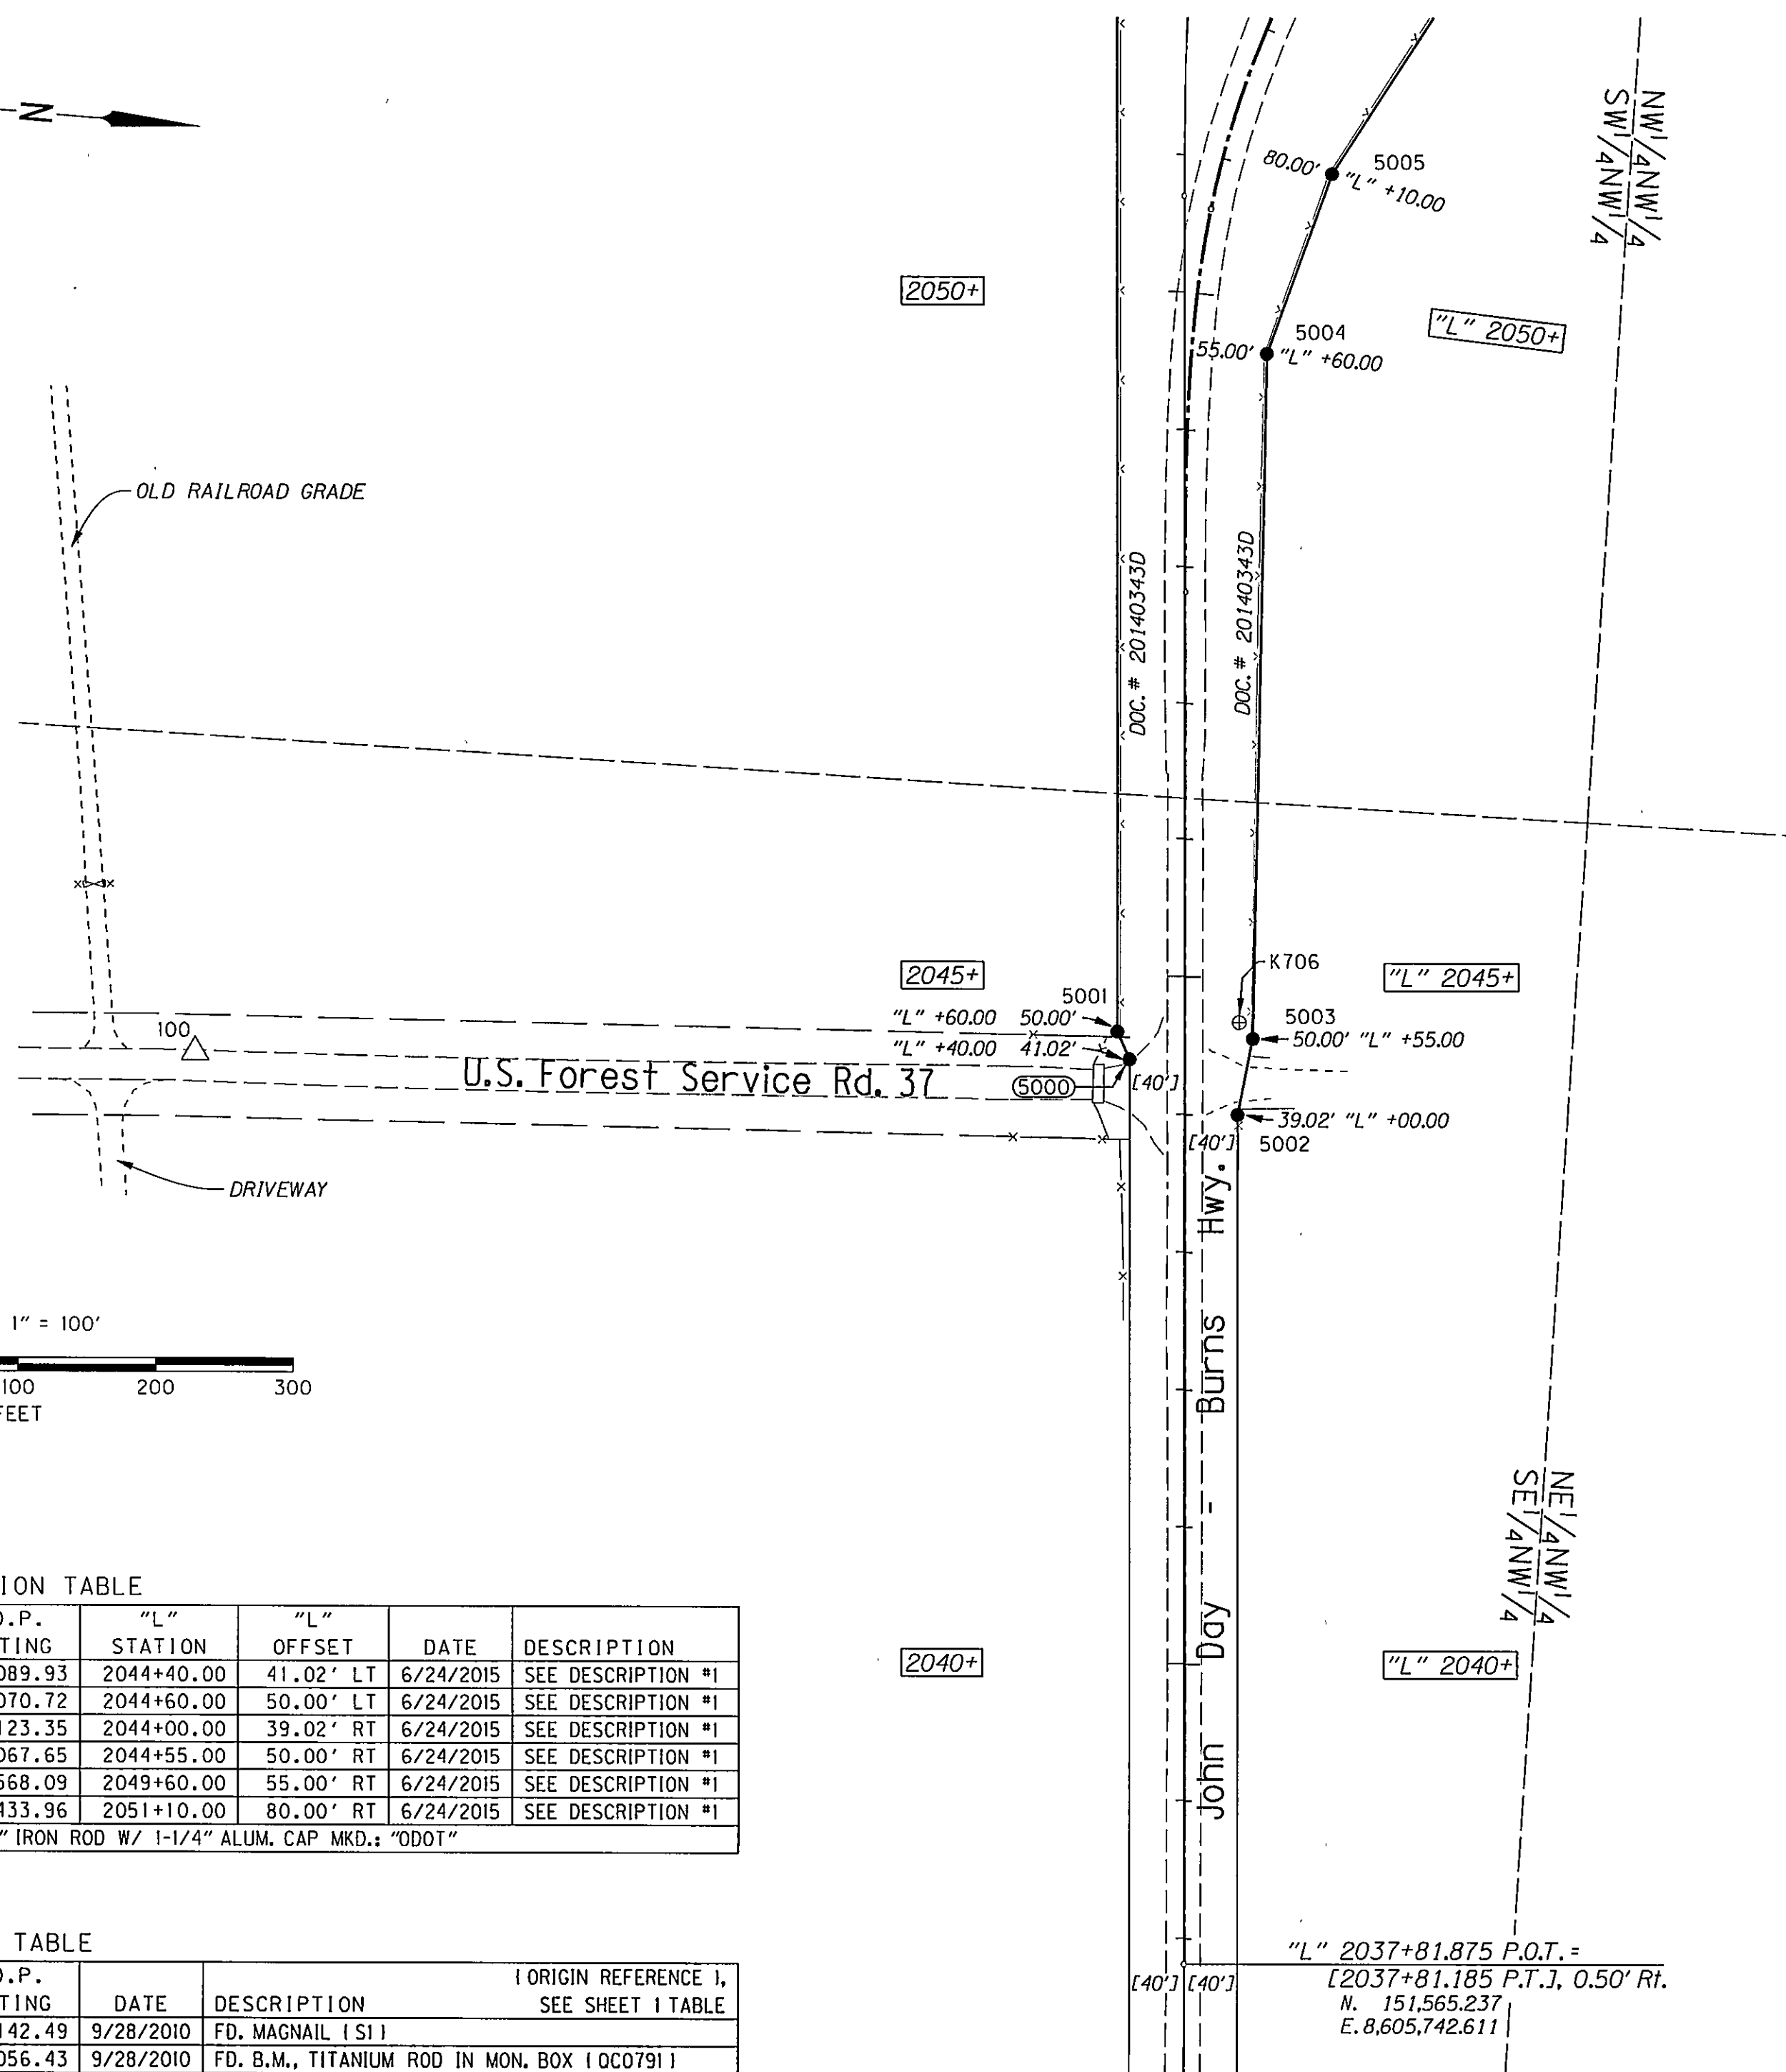


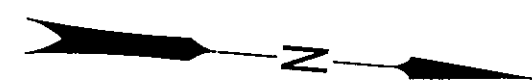

LEGEND

- ⊕ FOUND BENCHMARK
- △ FOUND NETWORK POINT
- SET MONUMENT AS SHOWN IN TABLE
- RIGHT-OF-WAY POINT NO.
- NEW RIGHT-OF-WAY BOUNDARY
- EXISTING RIGHT-OF-WAY BOUNDARY
- NEW RIGHT-OF-WAY CENTERLINE
- EXISTING RIGHT-OF-WAY CENTERLINE
- EASEMENT (FOREST SERVICE)
- PAVEMENT EDGE
- EDGE OF GRAVEL/BALLAST
- FENCE LINE
- [J] = RECORD DATA AS PER SI, SEE SHEET 1 REFERENCE TABLE

NOTE:
FOR RECORD ALIGNMENT & NEW
ALIGNMENT DATA SEE SHEET 2

REGISTERED
PROFESSIONAL
LAND SURVEYOR

OREGON
JANUARY 14, 2003
BRET N. ELITHORP
63148

RENEWS DEC. 31, 2015

KEY NO.: 14674
DRAWN: F. J. SCHAD



OREGON DEPARTMENT OF TRANSPORTATION
RIGHT-OF-WAY BOUNDARY MONUMENTATION MAP
FFO - US395 CURVE REALIGNMENT
JOHN DAY - BURNS HIGHWAY NO. 48 (U.S. HWY. 395)
MILEPOINT 31
GRANT COUNTY

ODOT REGION 5
3012 ISLAND AVE.
LA GRANDE, OR 97850

SEPTEMBER 8, 2015
SCALE: 1 in. = 100 ft.
Sheet 3 of 5

RIGHT-OF-WAY LOCATION TABLE

PNT. NO.	L.D.P. NORTHING	L.D.P. EASTING	"L" STATION	"L" OFFSET	DATE	DESCRIPTION
5000	151471.32	8605089.93	2044+40.00	41.02' LT	6/24/2015	SEE DESCRIPTION #1
5001	151460.75	8605070.72	2044+60.00	50.00' LT	6/24/2015	SEE DESCRIPTION #1
5002	151554.31	8605123.35	2044+00.00	39.02' RT	6/24/2015	SEE DESCRIPTION #1
5003	151560.83	8605067.65	2044+55.00	50.00' RT	6/24/2015	SEE DESCRIPTION #1
5004	151530.12	8604568.09	2049+60.00	55.00' RT	6/24/2015	SEE DESCRIPTION #1
5005	151566.84	8604433.96	2051+10.00	80.00' RT	6/24/2015	SEE DESCRIPTION #1

DESCRIPTION #1: SET 5/8" X 30" IRON ROD W/ 1-1/4" ALUM. CAP MKD.: "ODOT"

RECOVERED MONUMENT TABLE

PNT. NO.	L.D.P. NORTHING	L.D.P. EASTING	DATE	DESCRIPTION	ORIGIN REFERENCE 1, SEE SHEET 1 TABLE
100	150792.07	8605142.49	9/28/2010	FD. MAGNAIL (S1)	
K706	151549.84	8605056.43	9/28/2010	FD. B.M., TITANIUM ROD IN MON. BOX (OC0791)	