


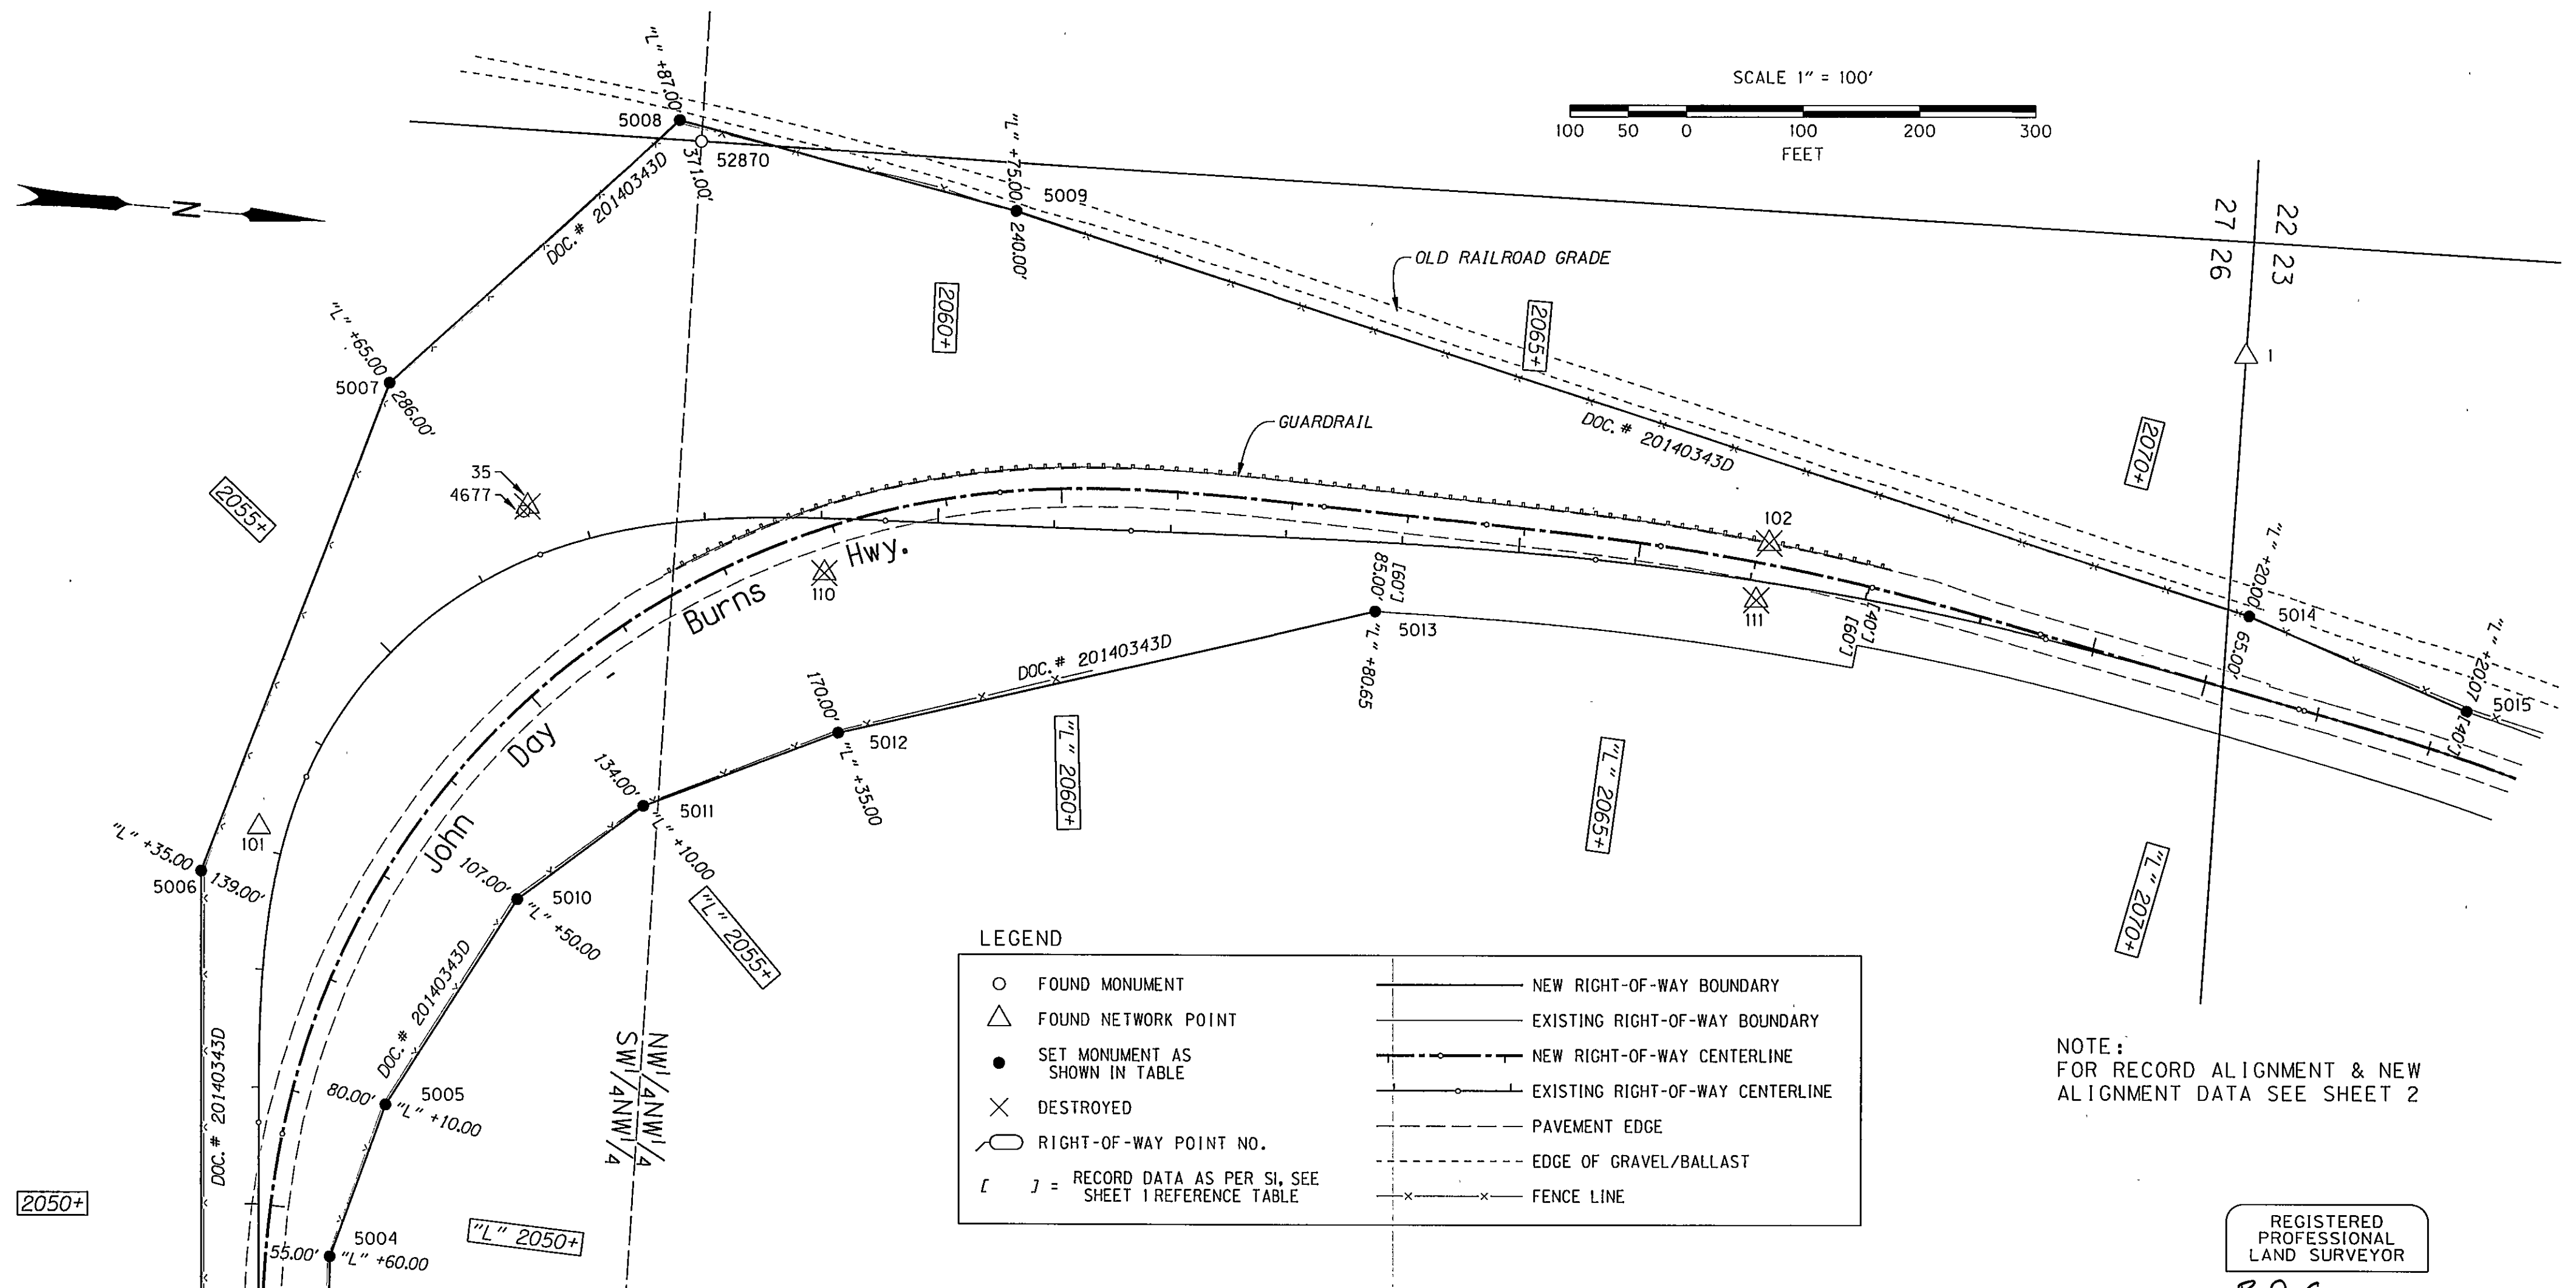

RIGHT-OF-WAY LOCATION TABLE

PNT. NO.	L.D.P. NORTHING	L.D.P. EASTING	"L" STATION	"L" OFFSET	DATE	DESCRIPTION
5004	151530.12	8604568.09	2049+60.00	55.00' RT	6/24/2015	SEE DESCRIPTION #1
5005	151566.84	8604433.96	2051+10.00	80.00' RT	6/24/2015	SEE DESCRIPTION #1
5006	151393.17	8604248.63	2052+35.00	139.00' LT	6/24/2015	SEE DESCRIPTION #1
5007	151519.56	8603816.54	2055+65.00	286.00' LT	6/24/2015	SEE DESCRIPTION #1
5008	151749.42	8603571.11	2057+87.00	371.00' LT	6/25/2015	SEE DESCRIPTION #1
5009	152043.70	8603624.07	2059+75.00	240.00' LT	6/25/2015	SEE DESCRIPTION #1
5010	151665.03	8604250.19	2053+50.00	107.00' RT	6/24/2015	SEE DESCRIPTION #1
5011	151766.30	8604161.45	2055+10.00	134.00' RT	6/24/2015	SEE DESCRIPTION #1
5012	151927.65	8604084.97	2057+35.00	170.00' RT	6/24/2015	SEE DESCRIPTION #1
5013	152379.57	8603941.03	2062+80.65	85.00' RT	6/24/2015	SEE DESCRIPTION #1
5014	153126.67	8603883.09	2070+20.00	65.00' LT	6/25/2015	SEE DESCRIPTION #2
5015	153318.83	8603949.59	2072+20.07	40.00' LT	6/25/2015	SEE DESCRIPTION #1

DESCRIPTION #1: SET 5/8" X 30" IRON ROD W/ 1-1/4" ALUM. CAP MKD.: "ODOT"

DESCRIPTION #2: SET 5/8" X 30" IRON ROD W/ 1" BR. DISK MKD.: "ODOT"

RECOVERED MONUMENT TABLE

PNT. NO.	L.D.P. NORTHING	L.D.P. EASTING	DATE	DESCRIPTION (ORIGIN REFERENCE), SEE SHEET 1 TABLE
1	153105.64	8603660.44	9/28/2010	FD. 3-1/2" B.L.M. BR. CAP W.C., ON PIPE EXTENDING 10" ABOVE GRD., MKD.: "WC, T17S, R31E, S22/S23/S27/S26, 1979", LIES N. 89°19'13" E. 98.34' OF TRUE SECTION CORNER (S2)
52870	151769.24	8603587.23	9/28/2010	FD. 3-1/2" B.L.M. BR. CAP ON PIPE EXTENDING 10" ABOVE GRD. MKD.: "T17S, R31E, N1/16, S27/S26, 1979" (S2)
35	151645.91	8603912.44	N/A	DESTROYED BR. DISK MKD.: "35+169" (UNKNOWN)
101	151439.57	8604207.01	9/28/2010	FD. 1/2" SQ. IRON ROD W/ 1-1/2" ALUM. CAP, FLUSH W/ GRAVEL (S1)
102	152711.21	8603854.38	N/A	DESTROYED 1/2" SQ. IRON ROD W/ 1-1/2" ALUM. CAP, (S1)
110	151904.14	8603948.00	N/A	DESTROYED HUB & TACK. (S1)
111	152703.87	8603904.30	N/A	DESTROYED 1/2" SQ. IRON ROD W/ 1-1/2" ALUM. CAP MKD.: "ODOT, III, 2010" (S1)
4677	151643.01	8603916.77	N/A	DESTROYED 2-1/2" BR. DISK IN 6"X6" CONCRETE POST, (UNKNOWN)

REGISTERED
PROFESSIONAL
LAND SURVEYOR

OREGON
JANUARY 14, 2003
BRET N. ELITHORP
63148

RENEWES DEC. 31, 2015

KEY NO.: 14674
DRAWN: F. J. SCHAD

OREGON DEPARTMENT OF TRANSPORTATION
RIGHT-OF-WAY BOUNDARY MONUMENTATION MAP
FFO - US395 CURVE REALIGNMENT
JOHN DAY - BURNS HIGHWAY NO. 48 (U.S. HWY. 395)
MILEPOINT 31
GRANT COUNTY

ODOT REGION 5
3012 ISLAND AVE.
LA GRANDE, OR 97850

SEPTEMBER 8, 2015
SCALE: 1 in. = 100 ft.
Sheet 4 of 5