



SE 1/4 SECTION 1 T9S R27E WM  
SW 1/4 SECTION 1 T9S R27E WM

SCALE 1" = 50'

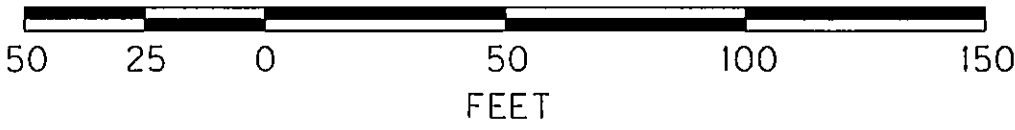

| LEGEND |                                           |
|--------|-------------------------------------------|
| ●      | SET R/W MONUMENT PER TABLE ON THIS SHEET  |
| ○      | FOUND MONUMENT PER TABLE ON SHEET 1       |
| □      | CALCULATED POINT - NOTHING FOUND OR SET   |
| —      | EXISTING RIGHT OF WAY OR PROPERTY LINE    |
| —      | NEW RIGHT OF WAY                          |
| .....  | FALSE CALL                                |
| ( )    | RECORD DATA PER REFERENCE LIST ON SHEET 1 |
| ○      | RIGHT-OF-WAY POINT NO.                    |

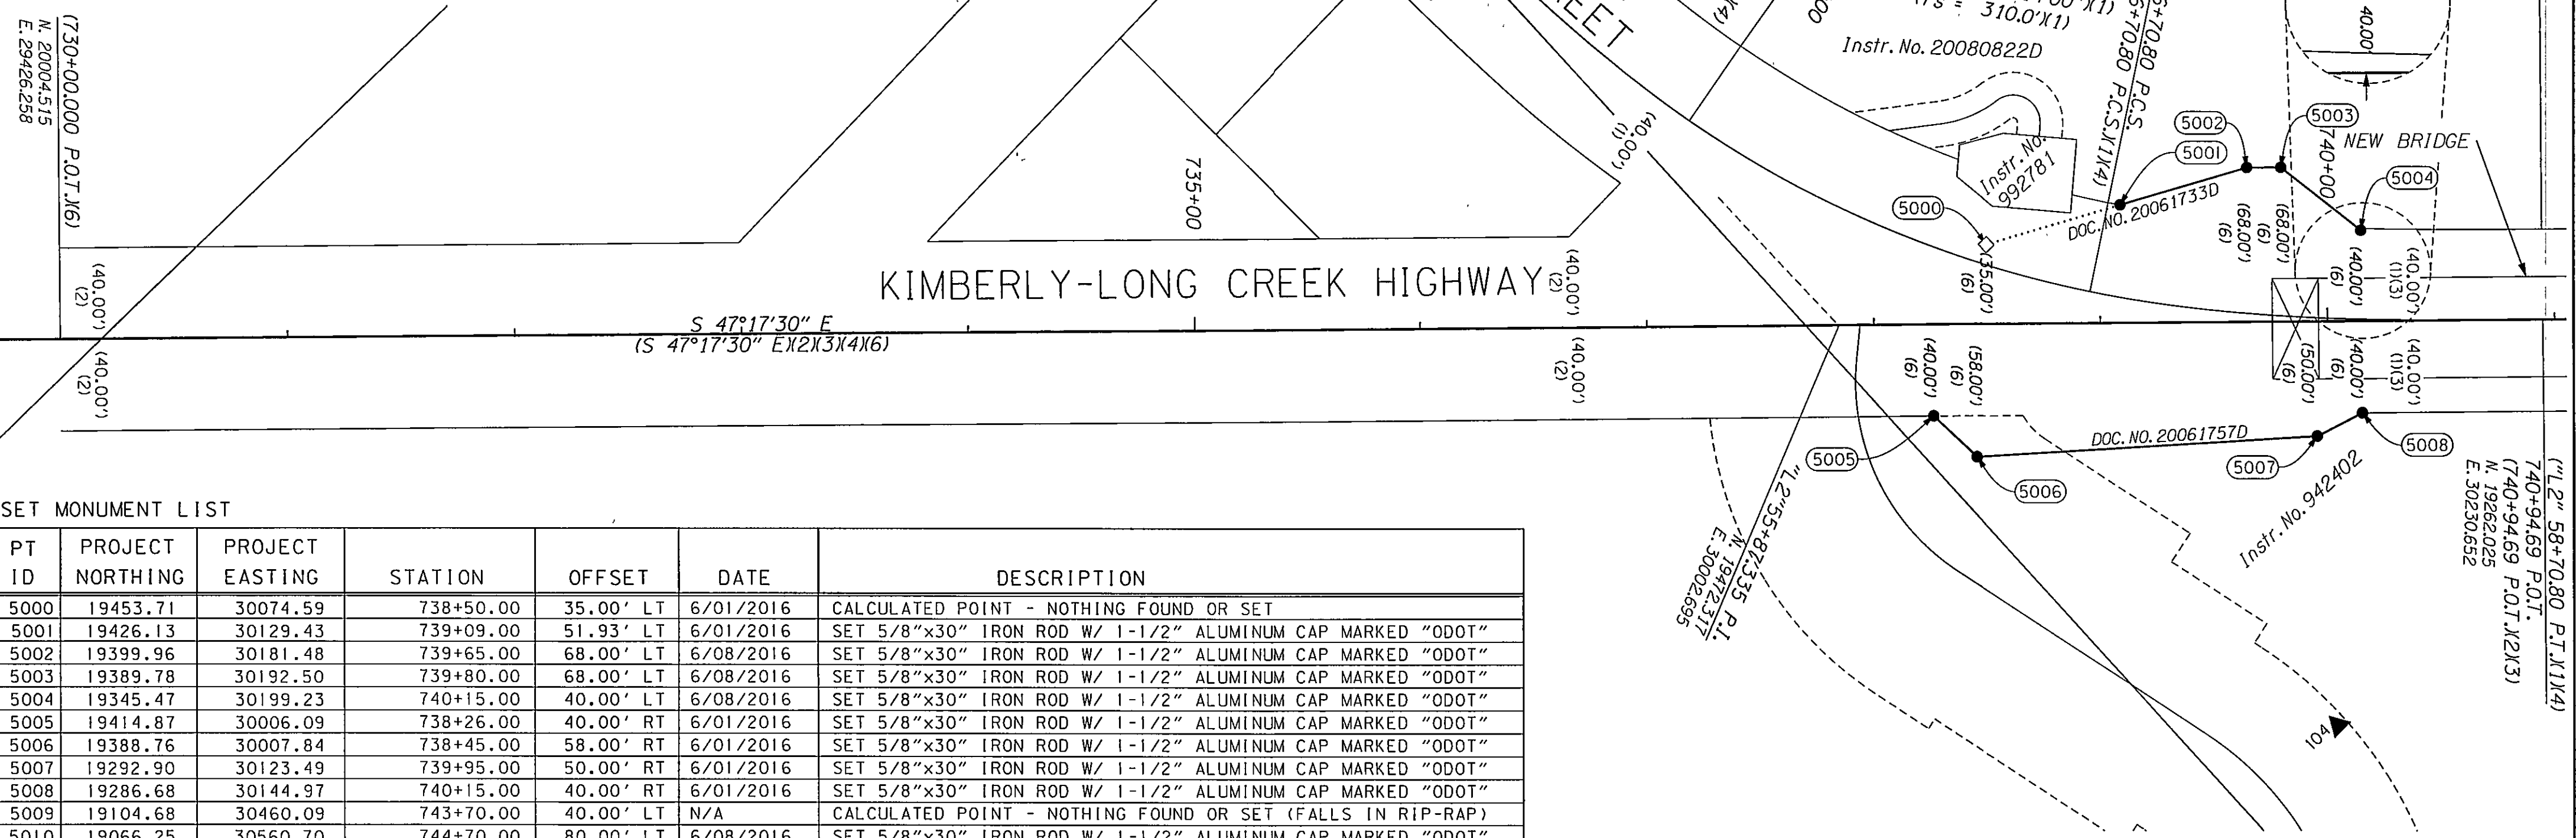

SET MONUMENT LIST

| PT ID | PROJECT NORTHING | PROJECT EASTING | STATION    | OFFSET     | DATE      | DESCRIPTION                                                |
|-------|------------------|-----------------|------------|------------|-----------|------------------------------------------------------------|
| 5000  | 19453.71         | 30074.59        | 738+50.00  | 35.00' LT  | 6/01/2016 | CALCULATED POINT - NOTHING FOUND OR SET                    |
| 5001  | 19426.13         | 30129.43        | 739+09.00  | 51.93' LT  | 6/01/2016 | SET 5/8"x30" IRON ROD W/ 1-1/2" ALUMINUM CAP MARKED "ODOT" |
| 5002  | 19399.96         | 30181.48        | 739+65.00  | 68.00' LT  | 6/08/2016 | SET 5/8"x30" IRON ROD W/ 1-1/2" ALUMINUM CAP MARKED "ODOT" |
| 5003  | 19389.78         | 30192.50        | 739+80.00  | 68.00' LT  | 6/08/2016 | SET 5/8"x30" IRON ROD W/ 1-1/2" ALUMINUM CAP MARKED "ODOT" |
| 5004  | 19345.47         | 30199.23        | 740+15.00  | 40.00' LT  | 6/08/2016 | SET 5/8"x30" IRON ROD W/ 1-1/2" ALUMINUM CAP MARKED "ODOT" |
| 5005  | 19414.87         | 30006.09        | 738+26.00  | 40.00' RT  | 6/01/2016 | SET 5/8"x30" IRON ROD W/ 1-1/2" ALUMINUM CAP MARKED "ODOT" |
| 5006  | 19388.76         | 30007.84        | 738+45.00  | 58.00' RT  | 6/01/2016 | SET 5/8"x30" IRON ROD W/ 1-1/2" ALUMINUM CAP MARKED "ODOT" |
| 5007  | 19292.90         | 30123.49        | 739+95.00  | 50.00' RT  | 6/01/2016 | SET 5/8"x30" IRON ROD W/ 1-1/2" ALUMINUM CAP MARKED "ODOT" |
| 5008  | 19286.68         | 30144.97        | 740+15.00  | 40.00' RT  | 6/01/2016 | SET 5/8"x30" IRON ROD W/ 1-1/2" ALUMINUM CAP MARKED "ODOT" |
| 5009  | 19104.68         | 30460.09        | 743+70.00  | 40.00' LT  | N/A       | CALCULATED POINT - NOTHING FOUND OR SET (FALLS IN RIP-RAP) |
| 5010  | 19066.25         | 30560.70        | 744+70.00  | 80.00' LT  | 6/08/2016 | SET 5/8"x30" IRON ROD W/ 1-1/2" ALUMINUM CAP MARKED "ODOT" |
| 5011  | 19039.12         | 30590.09        | 745+10.00  | 80.00' LT  | 6/08/2016 | SET 5/8"x30" IRON ROD W/ 1-1/2" ALUMINUM CAP MARKED "ODOT" |
| 5012  | 18948.68         | 30629.09        | 746+00.00  | 40.00' LT  | 6/01/2016 | SET 5/8"x30" IRON ROD W/ 1-1/2" ALUMINUM CAP MARKED "ODOT" |
| 5013  | 19032.33         | 30420.52        | 743+90.00  | 40.00' RT  | 6/01/2016 | SET 5/8"x30" IRON ROD W/ 1-1/2" ALUMINUM CAP MARKED "ODOT" |
| 5014  | 19018.20         | 30421.09        | 744+00.00  | 50.00' RT  | 6/01/2016 | SET 5/8"x30" IRON ROD W/ 1-1/2" ALUMINUM CAP MARKED "ODOT" |
| 5015  | 19008.03         | 30432.11        | 744+15.00  | 50.00' RT  | 6/01/2016 | SET 5/8"x30" IRON ROD W/ 1-1/2" ALUMINUM CAP MARKED "ODOT" |
| 5016  | 19008.59         | 30446.24        | 744+25.00  | 40.00' RT  | 6/01/2016 | SET 5/8"x30" IRON ROD W/ 1-1/2" ALUMINUM CAP MARKED "ODOT" |
| 5017  | 18932.64         | 30351.60        | "E"2+60.00 | 80.00' RT  | 6/01/2016 | SET 5/8"x30" IRON ROD W/ 1-1/2" ALUMINUM CAP MARKED "ODOT" |
| 5018  | 18645.35         | 30234.24        | "E"5+50.00 | 25.69' RT  | 6/01/2016 | SET 5/8"x30" IRON ROD W/ 1-1/2" ALUMINUM CAP MARKED "ODOT" |
| 5019  | 18623.38         | 30279.27        | "E"5+50.00 | 24.41' LT  | 6/08/2016 | SET 5/8"x30" IRON ROD W/ 1-1/2" ALUMINUM CAP MARKED "ODOT" |
| 5020  | 18777.77         | 30372.46        | "E"3+65.00 | 35.00' LT  | 6/08/2016 | SET 5/8"x30" IRON ROD W/ 1-1/2" ALUMINUM CAP MARKED "ODOT" |
| 5021  | 18895.34         | 30568.93        | "E"1+40.00 | 105.00' LT | 6/08/2016 | SET 5/8"x30" IRON ROD W/ 1-1/2" ALUMINUM CAP MARKED "ODOT" |
| 5022  | 18989.60         | 30466.82        | "E"1+40.00 | 33.97' RT  | 6/01/2016 | SET 5/8"x30" IRON ROD W/ 1-1/2" ALUMINUM CAP MARKED "ODOT" |

REGISTERED PROFESSIONAL LAND SURVEYOR  
Bret N. Elithorp  
OREGON  
JANUARY 14, 2003  
BRET N. ELITHORP  
63148  
EXPIRES: DEC. 31, 2017

OREGON DEPARTMENT OF TRANSPORTATION  
RIGHT OF WAY BOUNDARY MONUMENTATION SURVEY  
OR402: NORTH FORK JOHN DAY (MONUMENT) BRIDGE  
KIMBERLY-LONG CREEK HIGHWAY  
GRANT COUNTY, OREGON

FOR ODOT REGION 5  
3012 ISLAND AVENUE  
LA GRANDE, OR 97850

JUNE 23, 2016  
SCALE: 1" = 50'  
SHEET 2 OF 3