


NE 1/4 SEC. 14, T. 14 S., R. 31 E., W.M.
SE 1/4 SEC. 14, T. 14 S., R. 31 E., W.M.

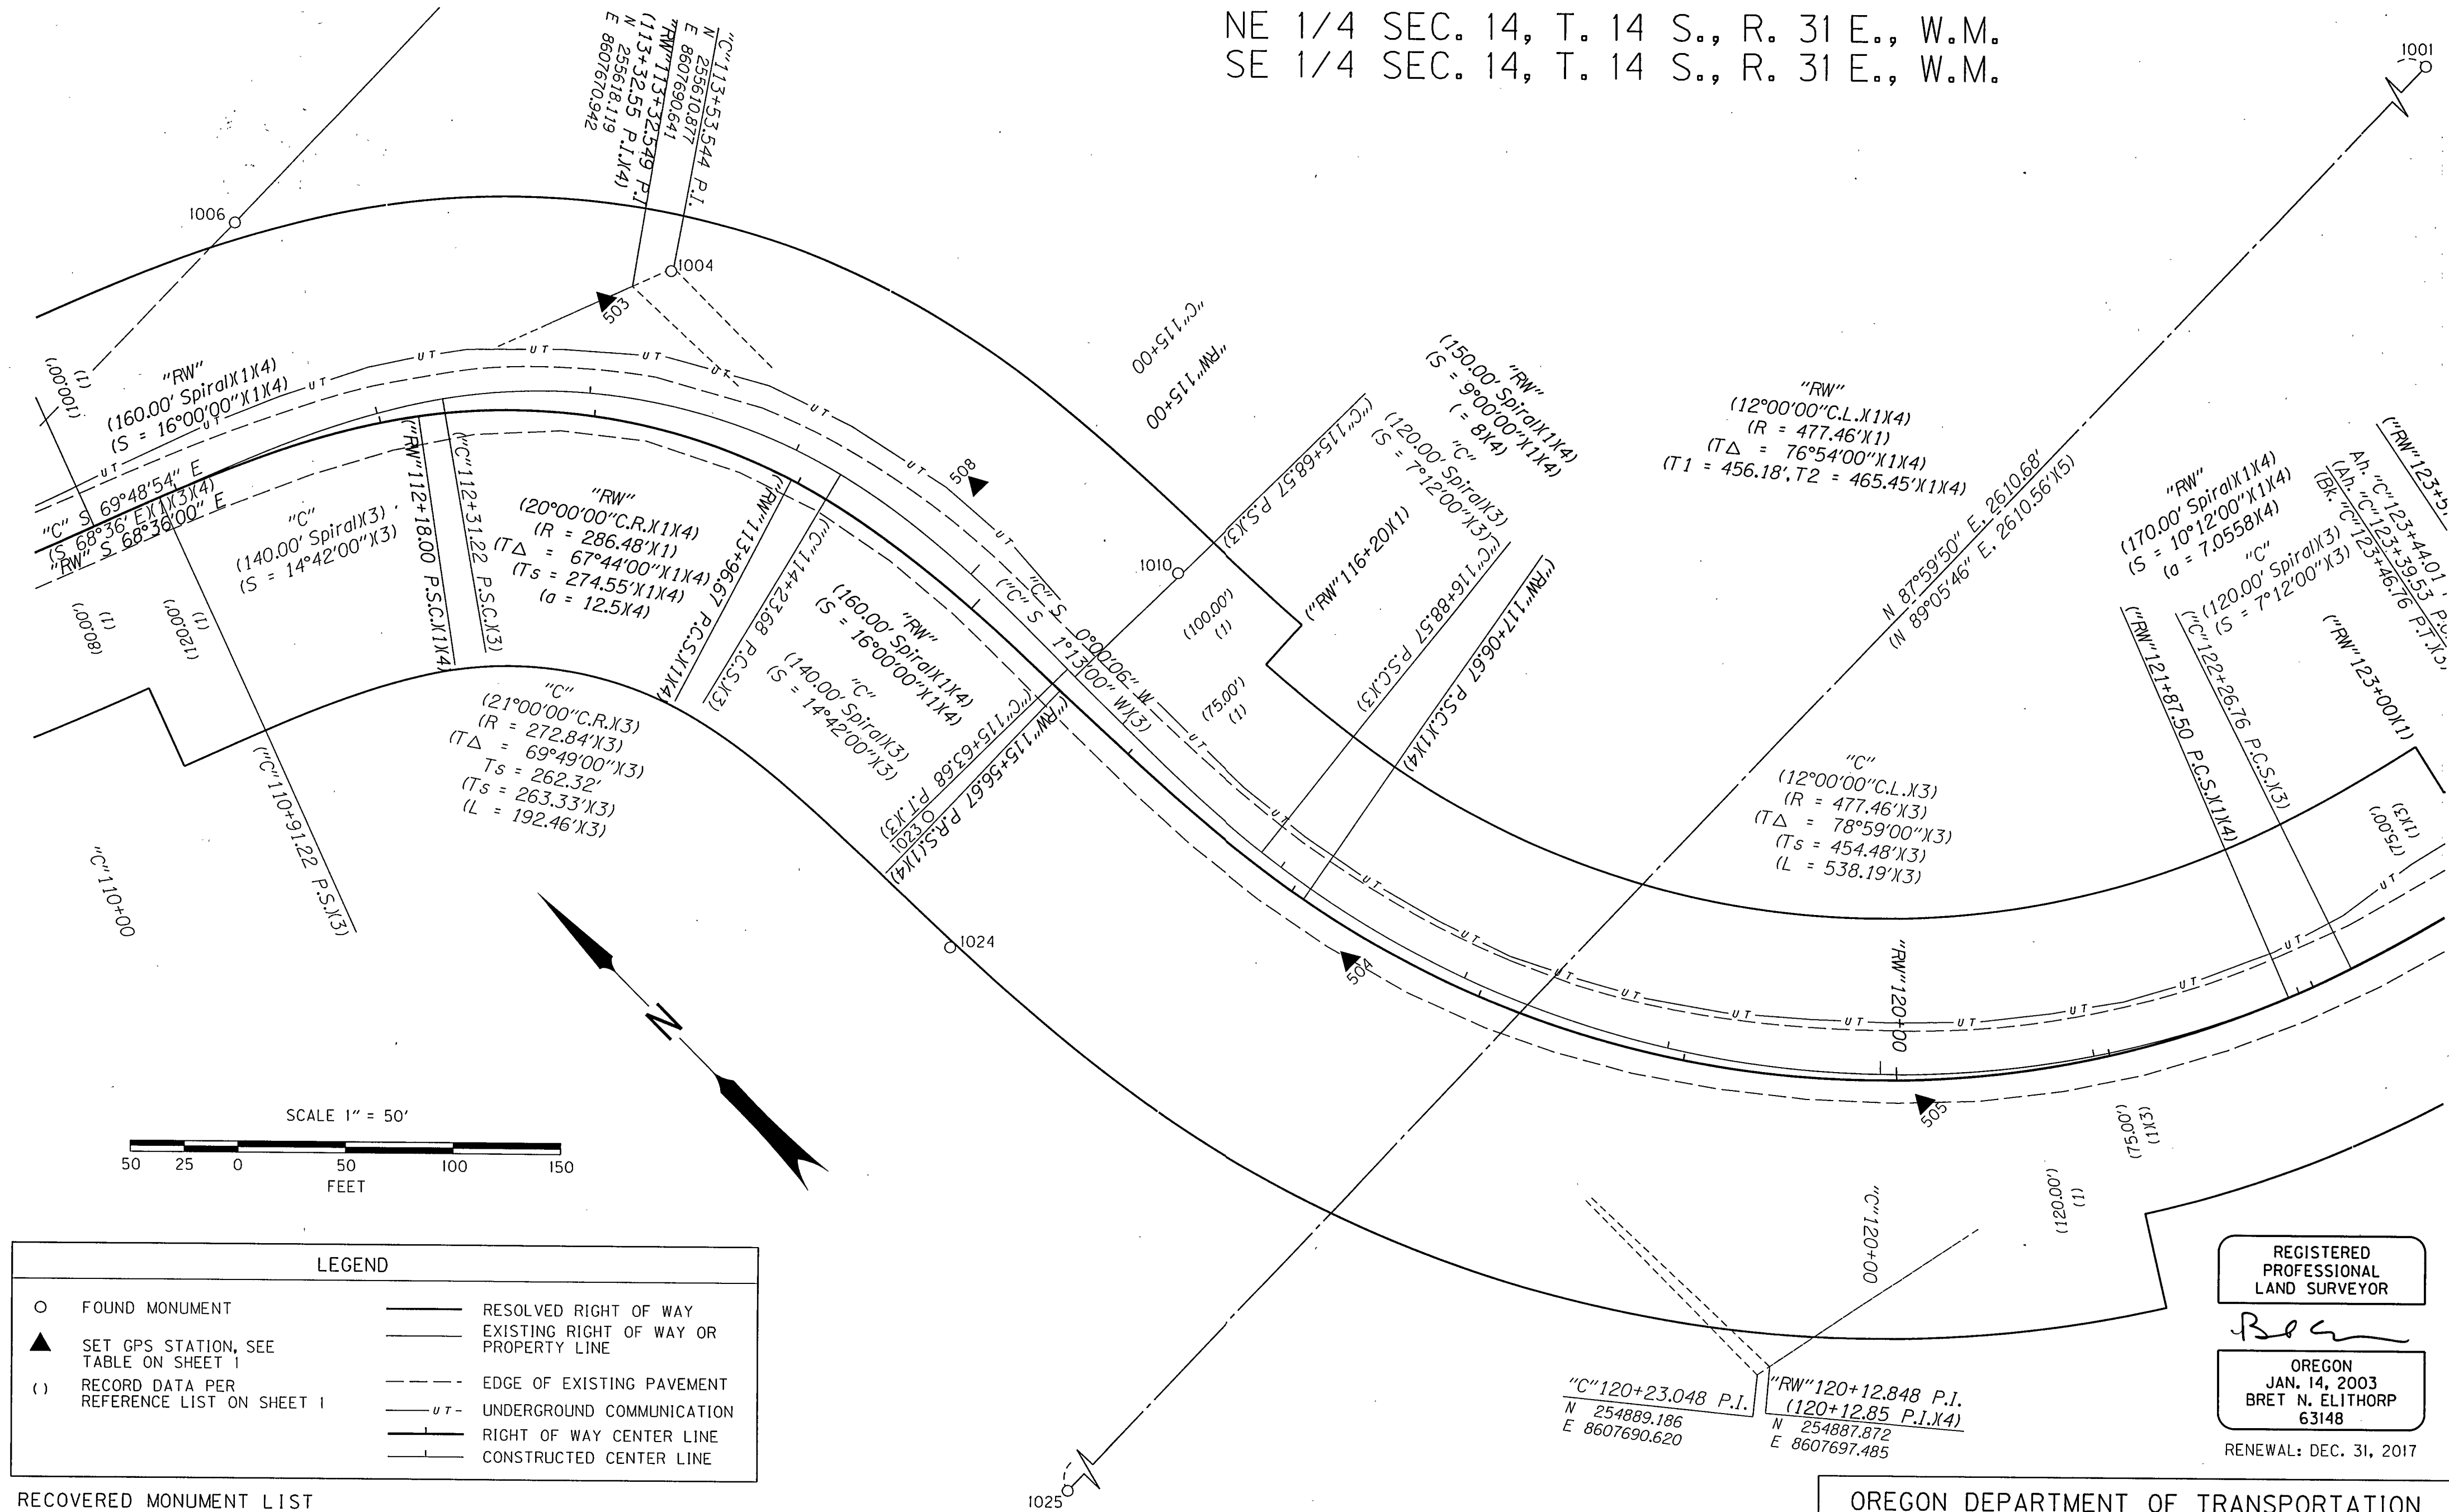

LEGEND

○ FOUND MONUMENT	— RESOLVED RIGHT OF WAY
▲ SET GPS STATION, SEE TABLE ON SHEET 1	— EXISTING RIGHT OF WAY OR PROPERTY LINE
() RECORD DATA PER REFERENCE LIST ON SHEET 1	--- EDGE OF EXISTING PAVEMENT
	— UT — UNDERGROUND COMMUNICATION
	— RIGHT OF WAY CENTER LINE
	— CONSTRUCTED CENTER LINE

RECOVERED MONUMENT LIST						DESCRIPTION & REFERENCE DOCUMENTS
PT ID	LDP NORTHING	LDP EASTING	STATION	OFFSET	DATE	
1001	255112.49	8608481.54	N/A	N/A	1/19/2016	FD 2-1/2" BRASS DISK MARKED "US GENERAL LAND OFFICE SURVEY T14S R31E 1/4 S14 1958", MOS 248
1004	255610.55	8607688.83	"C"113+26.82	61.83' LT	1/19/2016	FD 3/4" INSIDE DIAMETER IRON PIPE WITH BRASS PLUG MARKED "R/W", DOWN 1.0', ODOT DRG. 10B-5-8
1006	255768.64	8607559.66	"C"111+68.09	105.18' LT	1/19/2016	FD 5/8" IRON ROD WITH YELLOW PLASTIC CAP MARKED "BENCHMARK SURVEYING", FLUSH, MOS 1890
1010	255344.95	8607759.17	"C"115+67.28	68.54' LT	2/8/2016	FD 3/4" INSIDE DIAMETER IRON PIPE WITH BRASS PLUG MARKED "PS", FLUSH, ODOT DRG. 10B-5-8
1023	255344.57	8607595.44	"C"115+67.67	95.19' RT	8/1/2016	FD 3/4" INSIDE DIAMETER IRON PIPE WITH BRASS PLUG MARKED "PS", UP 0.65', ODOT DRG. 10B-5-8
1024	255293.78	8607560.24	"C"116+15.90	130.73' RT	8/1/2016	FD 3/4" INSIDE DIAMETER IRON PIPE WITH BRASS PLUG MARKED "RW", UP 0.60', ODOT DRG. 10B-5-8
1025	255021.25	8605872.46	N/A	N/A	8/1/2016	FD 2" DIA. BRASS CAP MARKED "BENCHMARK LAND SURVEYING T14S R31E C1/4 S14 2010 RLS6945", UP 0.1', MOS 1890

OREGON DEPARTMENT OF TRANSPORTATION
HORIZONTAL CONTROL, RECOVERY, AND RETRACEMENT SURVEY
US395 CANYON CREEK FLOOD MITIGATION
JOHN DAY-BURNS HIGHWAY
GRANT COUNTY, OR

REGISTERED PROFESSIONAL LAND SURVEYOR
Bret N. Elithorp
OREGON
JAN. 14, 2003
BRET N. ELITHORP
63148
RENEWAL: DEC. 31, 2017

FOR ODOT REGION 5
3012 ISLAND AVE
LA GRANDE, OR 97850

SEPTEMBER 20, 2016
SCALE 1"=50'
SHEET 3 OF 4