


S W BRENT STREET

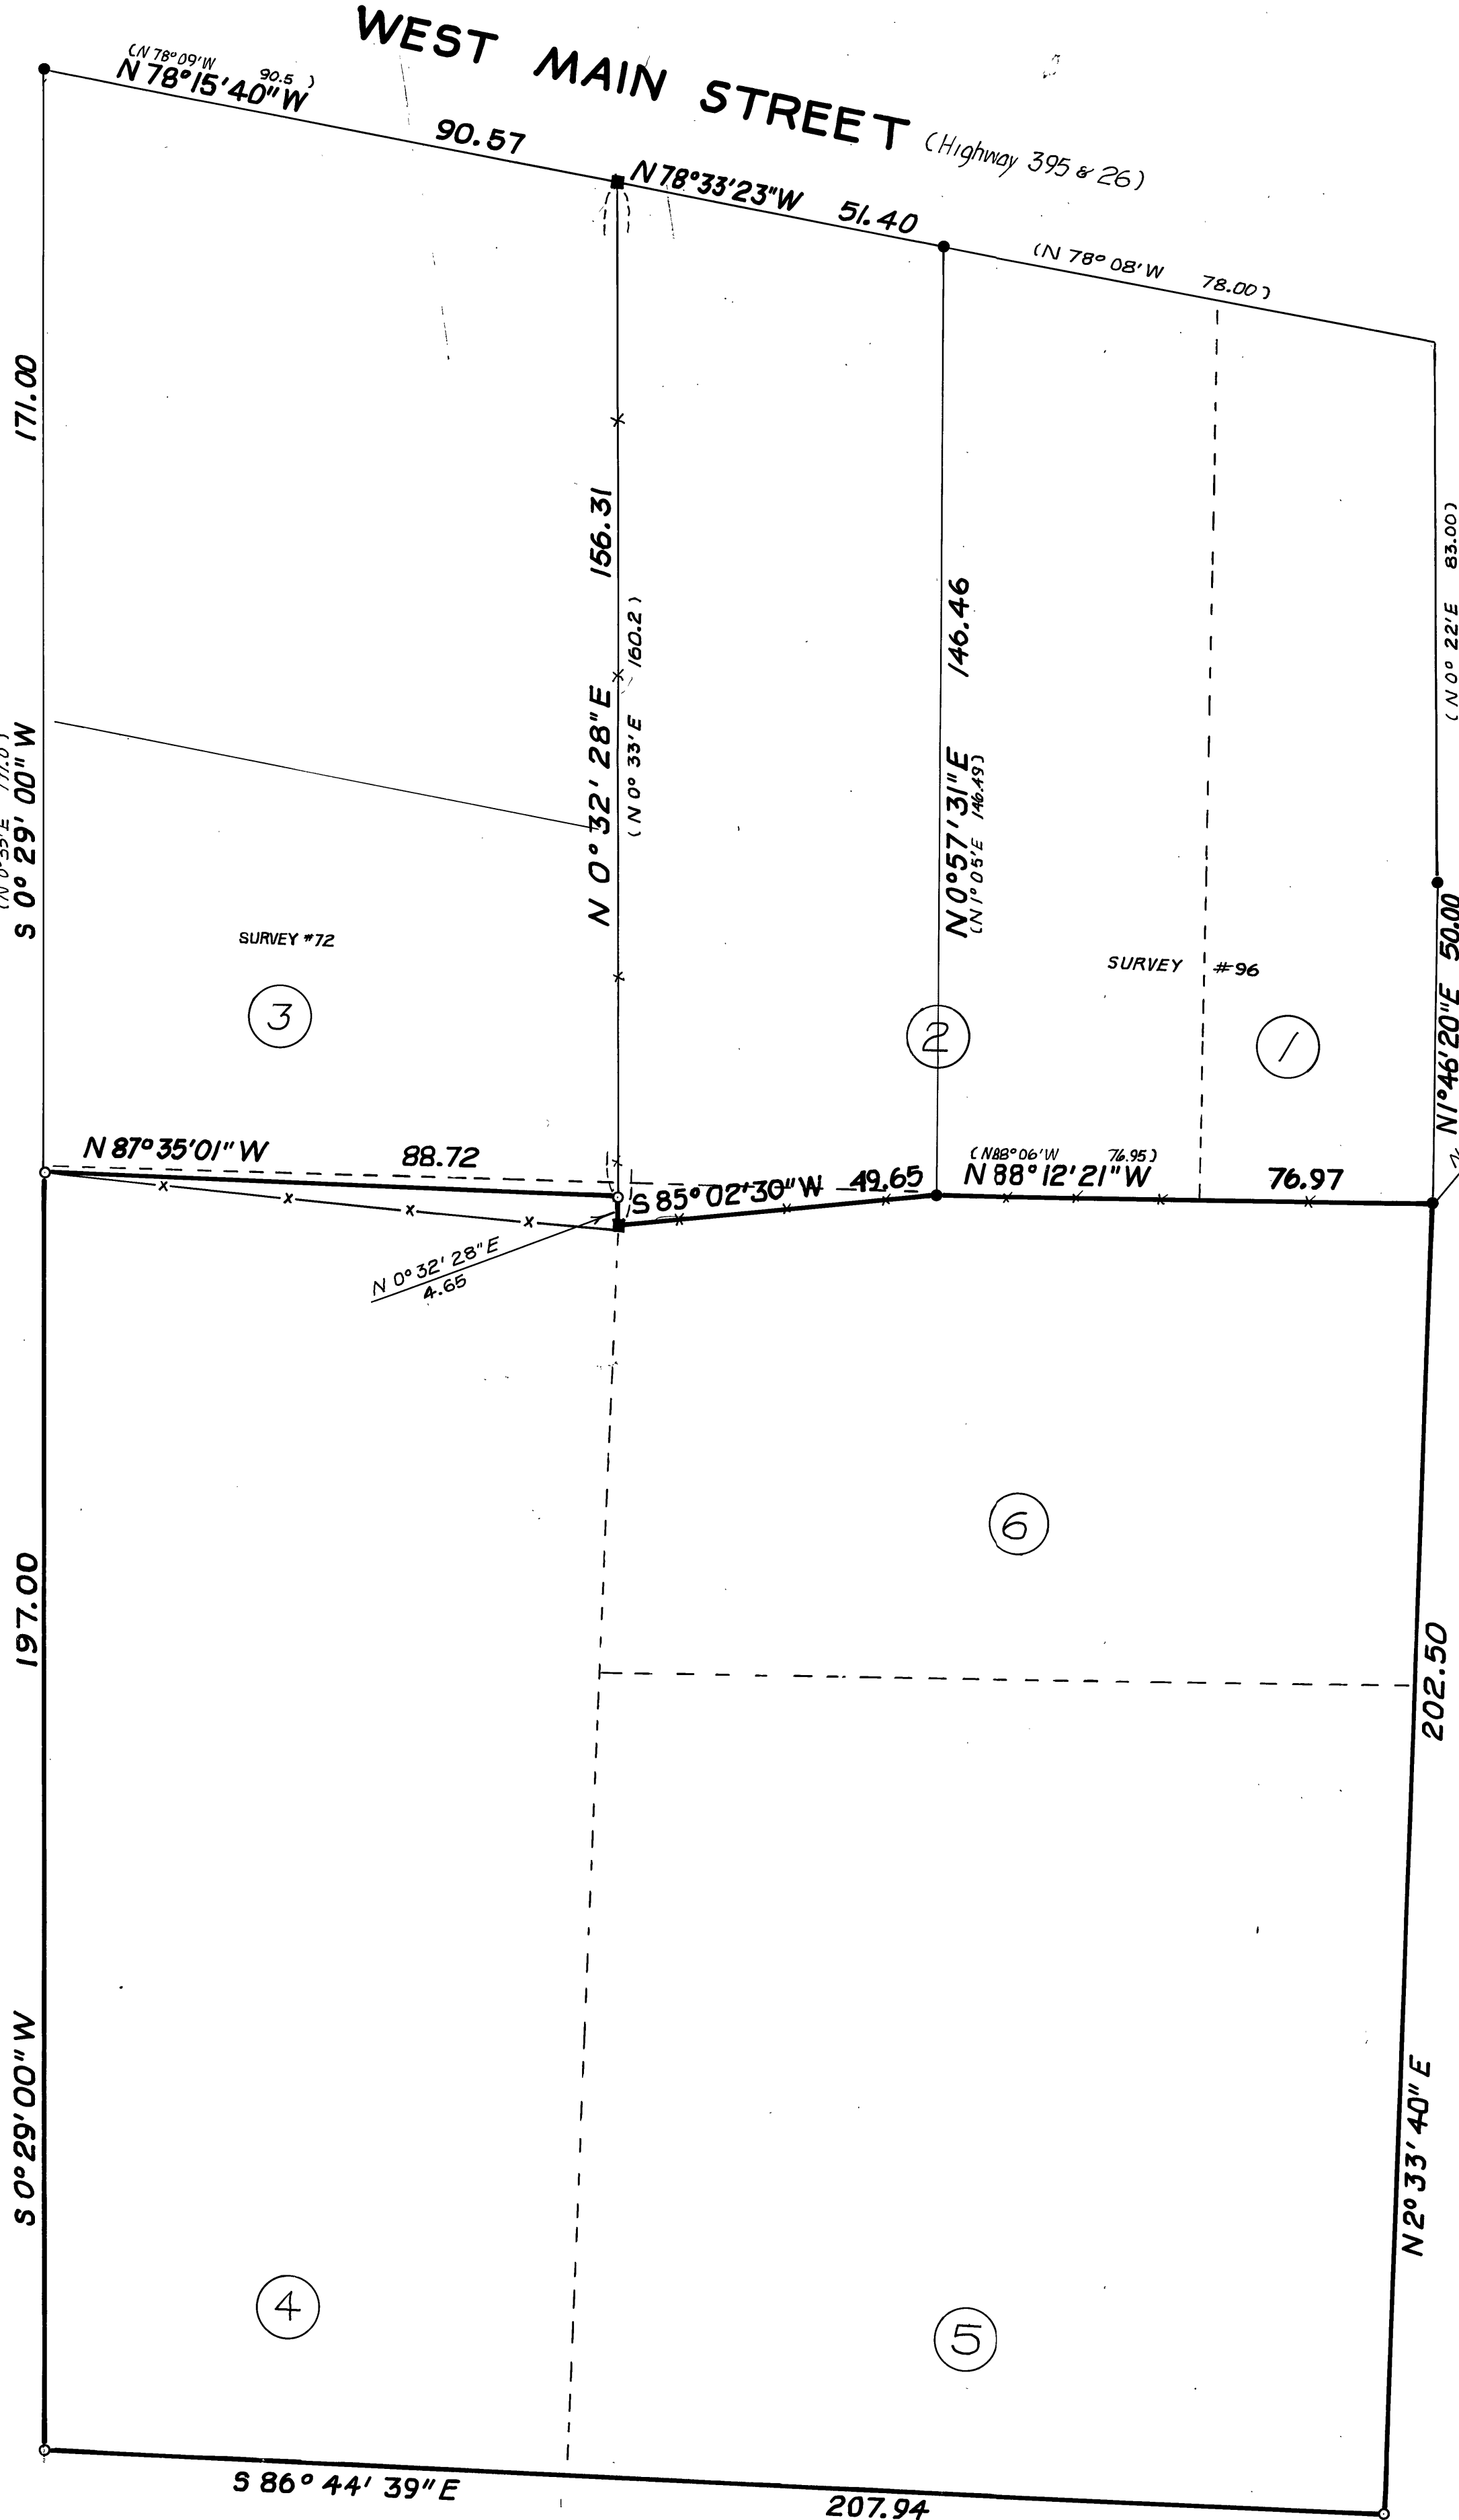

BASIS of BEARINGS  
MAP OF SURVEY #116A

N 1/4 CORNER SECTION 26  
T13S R31E W.M.  
N 790.08; E 511.95

RECEIVED AND  
FILED  
John Day, Oregon  
JULY 10, 1964  
DUANE I. GRIFFITH  
644

REGISTERED  
OREGON  
LAND SURVEYOR  
Duane I. Griffith  
JULY 10, 1964  
DUANE I. GRIFFITH  
644

LEGEND:

- Found Monument, No Record
- Found Monument of Record
- Set 5/8" x 30" iron pin, with Plastic Cap Marked "BG Sur MK"
- Record Bearing and Distance
- Existing Fence
- Original Lot Lines, Approximate Location
- Original Lot #

REFERENCE MATERIAL:

John Day Plat (1915)  
Map of Survey #72  
Map of Survey #96  
Map of Survey #116A

BAGETT-GRIFFITH-FERGUSON

|                           |                   |           |
|---------------------------|-------------------|-----------|
| John Day, Oregon          |                   |           |
| MAP OF SURVEY             |                   |           |
| PORTIONS OF LOTS 4, 5 & 6 |                   |           |
| BLOCK I                   |                   |           |
| CITY OF JOHN DAY          |                   |           |
| GRANT COUNTY, OREGON      |                   |           |
| SURVEYED FOR              | S-M MOTOR COMPANY |           |
| SURVEYED BY               | D.I.G.            | NOV. 1970 |
| Scale: 1"=20'             | Drawn by: T.G.    | Nov. 1970 |

MAP OF SURVEY #206