
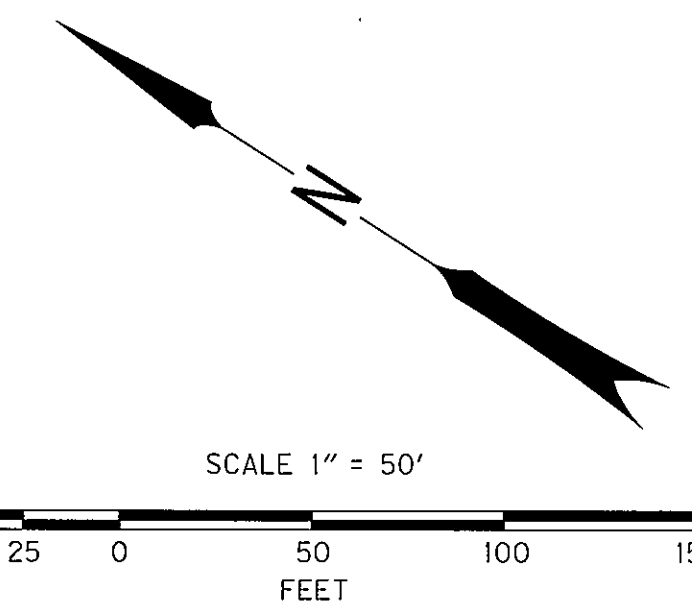


SW 1/4 SEC. 26, T. 13 S., R. 31 E., W.M.
NW 1/4 SEC. 26, T. 13 S., R. 31 E., W.M.

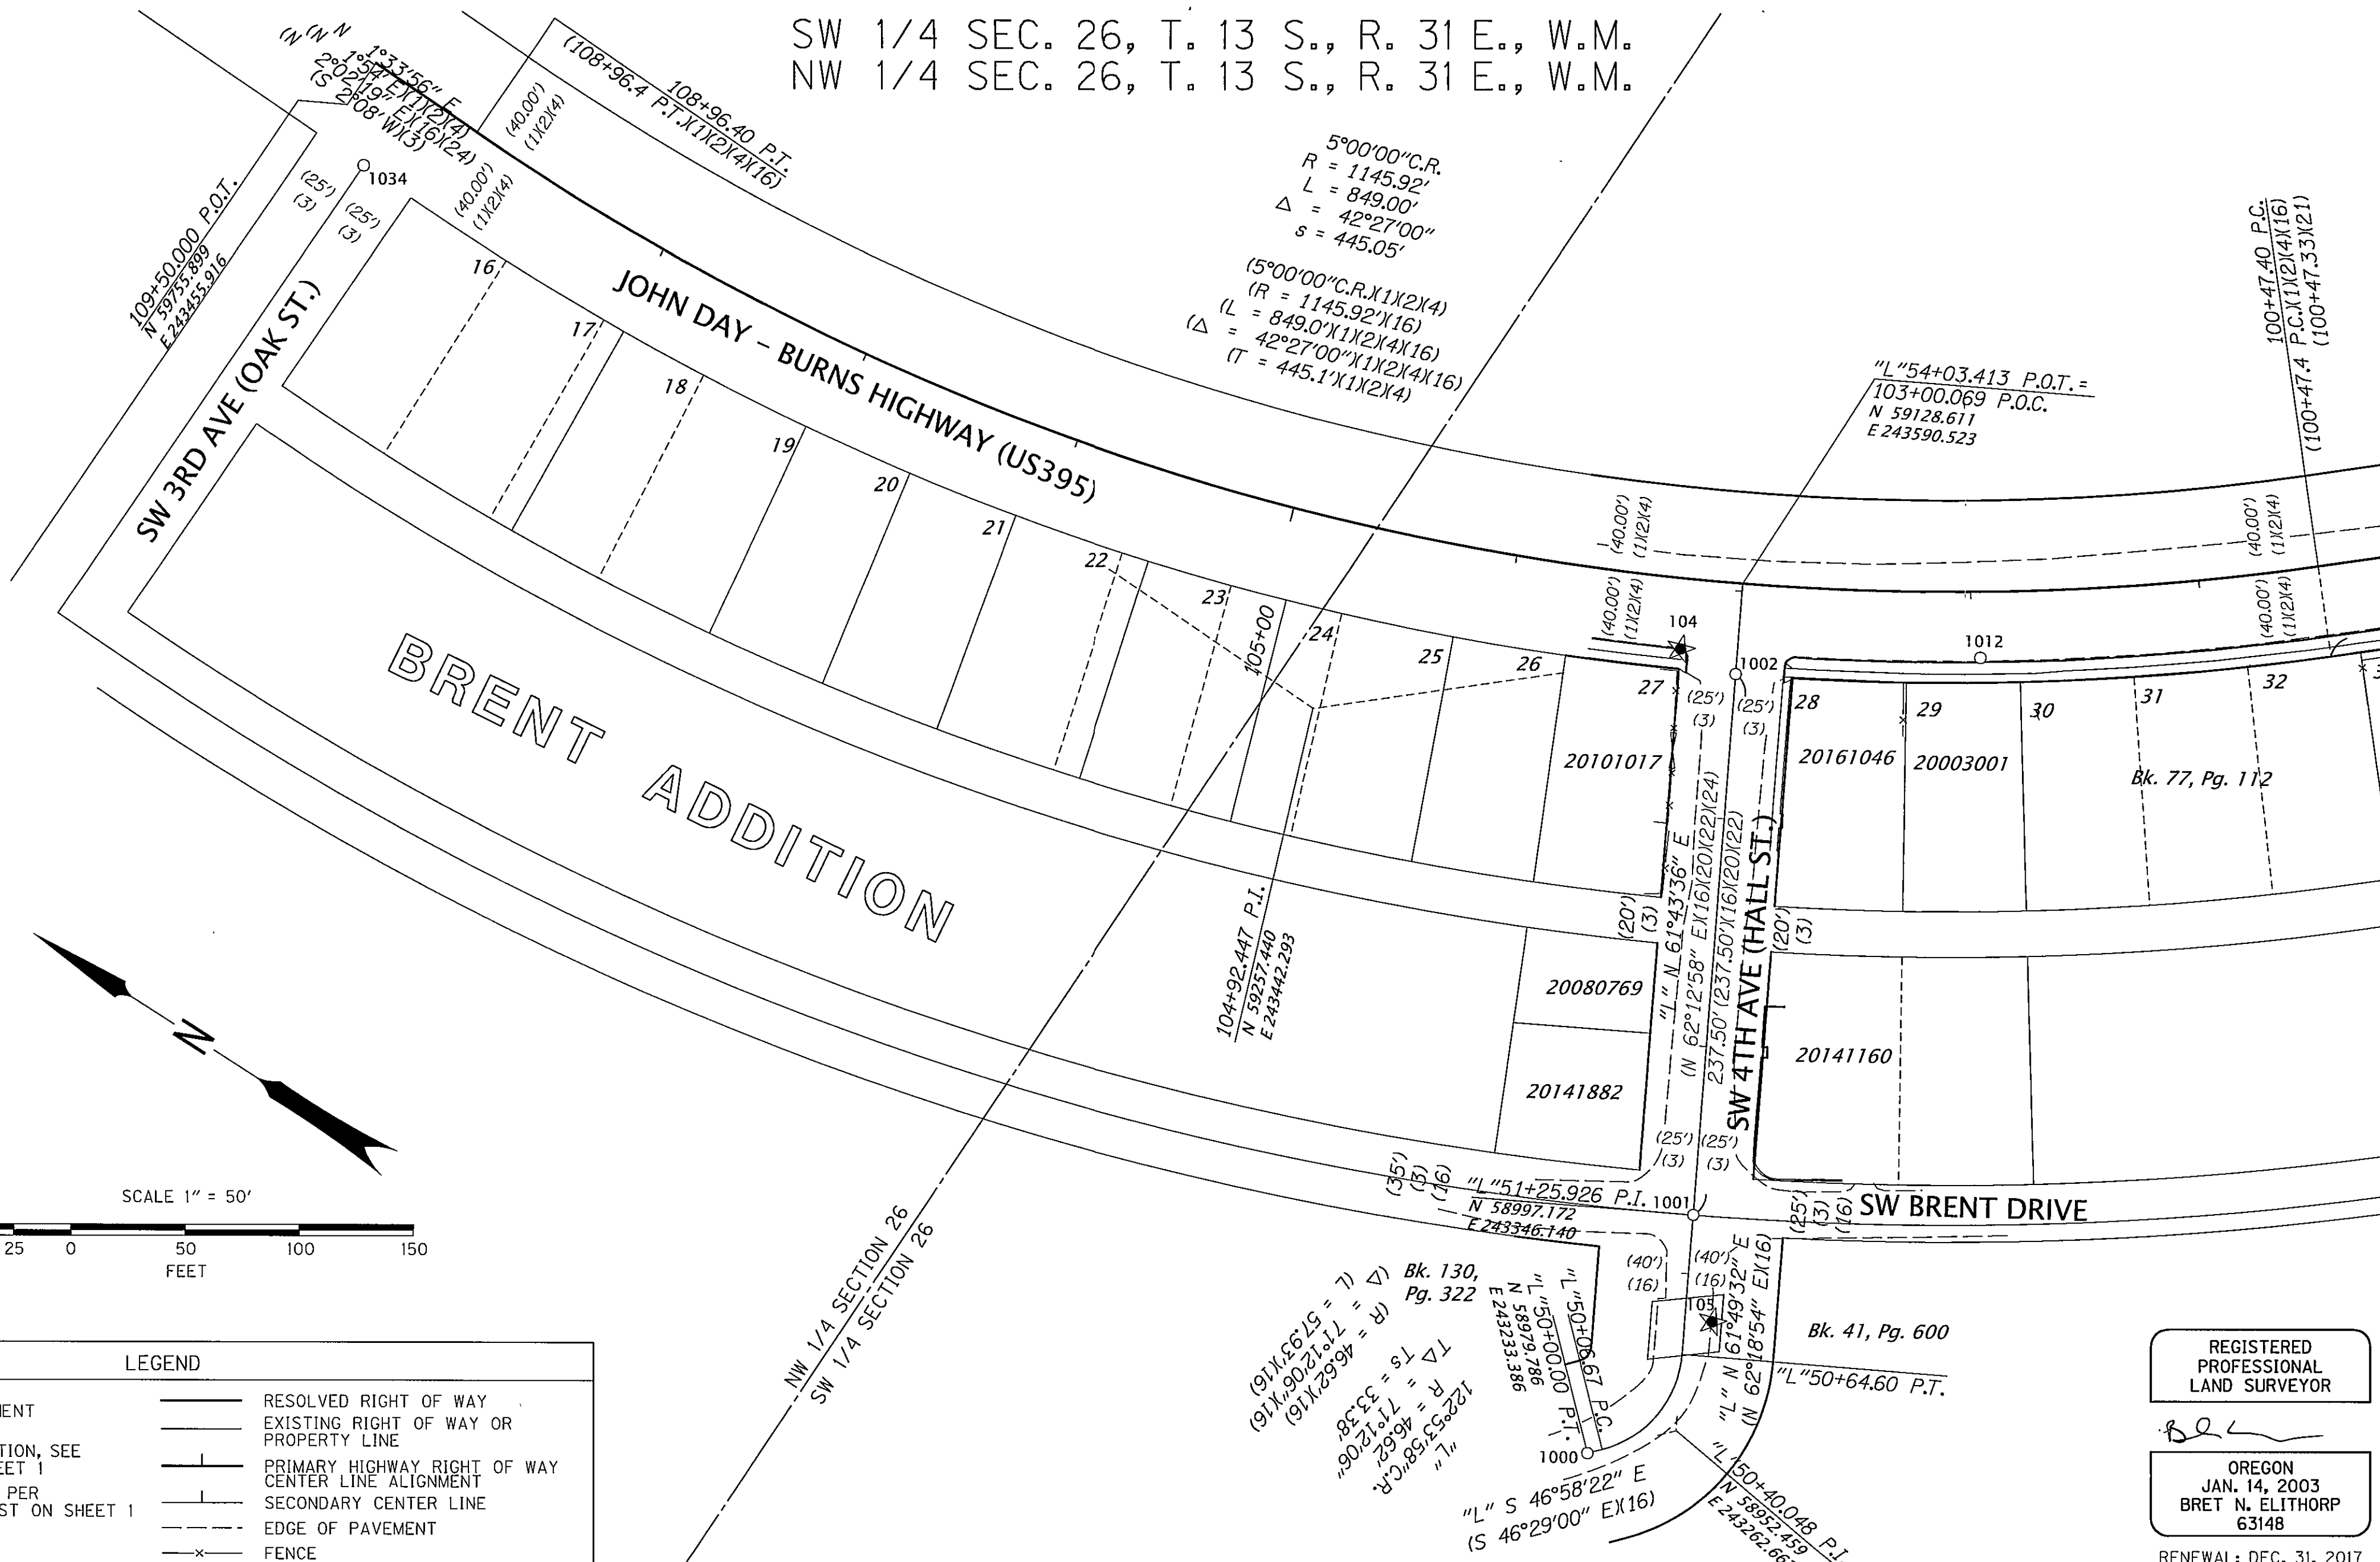

LEGEND	
○	FOUND MONUMENT
★	SET GPS STATION, SEE TABLE ON SHEET 1
()	RECORD DATA PER REFERENCE LIST ON SHEET 1
FD = FOUND	
MON = MONUMENT	
MOS = MAP OF SURVEY	
---	RESOLVED RIGHT OF WAY
---	EXISTING RIGHT OF WAY OR PROPERTY LINE
---	PRIMARY HIGHWAY RIGHT OF WAY CENTER LINE ALIGNMENT
---	SECONDARY CENTER LINE
---	EDGE OF PAVEMENT
-x-	FENCE
---	CURB

RECOVERED MONUMENT LIST

PT ID	PROJECT NORTHING	PROJECT EASTING	STATION	OFFSET	DATE	DESCRIPTION & REFERENCE DOCUMENTS
1000	58979.74	243233.35	"L" 50+00.00	0.06' RT	11/8/16	FD 2-1/2" BRASS DISK MARKED "BAGETT GRIFFITH & ASSOC. NO. 79", IN MON BOX, DOWN 12", MOS 1129
1001	58997.17	243346.14	"L" 51+25.92	0.00'	11/8/16	FD 2-1/2" BRASS DISK MARKED "BAGETT GRIFFITH & ASSOC. NO. 77, 1989, OPLS 598", IN MON BOX, DOWN 11" MOS 1129
1002	59109.67	243555.31	"L" 53+63.43 103+00.05	0.00' 39.99' LT	11/8/16	FD 2-1/2" BRASS DISK MARKED "BAGETT GRIFFITH & ASSOC. NO. 70, 1989, OPLS 598", IN MON BOX, DOWN 13", MOS 1129
1012	59023.36	243619.54	101+96.11	29.09' LT	11/16/16	FD RAILROAD SPIKE, UNKNOWN ORIGIN
1034	59736.20	243415.35	109+29.20	40.02' LT	12/21/16	FD 2-1/2" BRASS DISK MARKED "BAGETT GRIFFITH & ASSOC. NO. 64", IN MON BOX, DOWN 12", MOS 1129

REGISTERED
PROFESSIONAL
LAND SURVEYOR

BEL
OREGON
JAN. 14, 2003
BRET N. ELITHORP
63148

RENEWAL: DEC. 31, 2017

OREGON DEPARTMENT OF TRANSPORTATION
HORIZONTAL CONTROL, RECOVERY AND RETRACEMENT MAP
US395: SIDEWALK IMPROVEMENTS (JOHN DAY)
JOHN DAY - BURNS HIGHWAY (US395)
GRANT COUNTY, OREGON



FOR ODOT REGION 5
3012 ISLAND AVENUE
LA GRANDE, OR 97850

MARCH 2, 2017
SCALE: 1" = 50'
SHEET 2 OF 6