


SW 1/4 SEC. 26, T. 13 S., R. 31 E., W.M.
SE 1/4 SEC. 26, T. 13 S., R. 31 E., W.M.

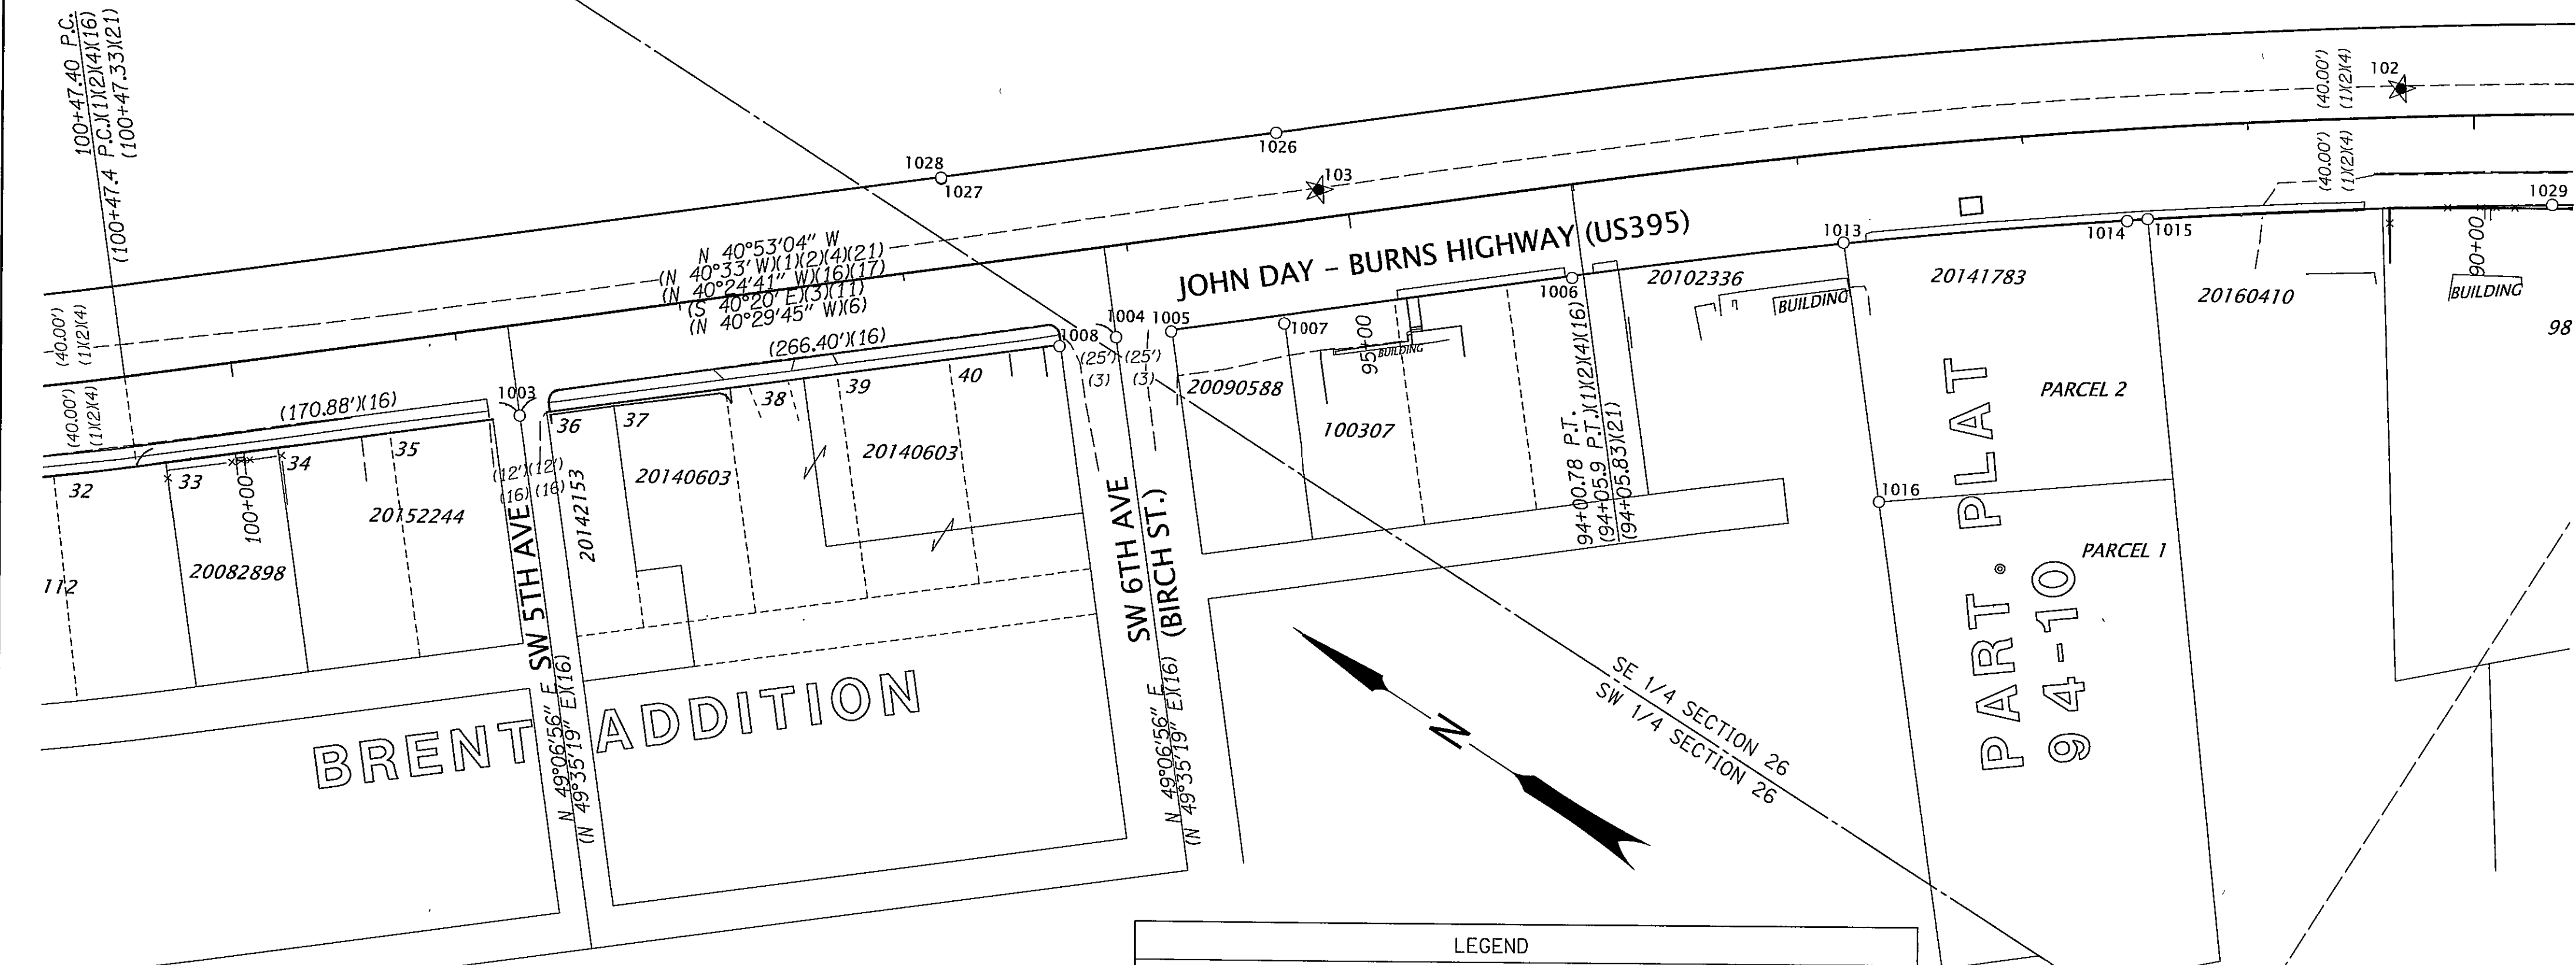

RECOVERED MONUMENT LIST

PT ID	PROJECT NORTHING	PROJECT EASTING	STATION	OFFSET	DATE	DESCRIPTION & REFERENCE DOCUMENTS
1003	58765.60	243815.20	98+76.52	40.00' LT	11/8/16	FD 2-1/2" BRASS DISK MARKED "BAGETT GRIFFITH & ASSOC. NO. 71, 1989, OPLS 598", IN MON BOX, DOWN 13", MOS 1129
1004	58564.19	243989.57	96+10.12	40.00' LT	11/8/16	FD 2-1/2" BRASS DISK MARKED "BAGETT GRIFFITH & ASSOC. NO. 72, 1989, OPLS 598", IN MON BOX, DOWN 12" MOS 1129
1005	58545.16	244005.15	95+85.53	40.67' LT	11/15/16	FD 5/8" IRON ROD, DOWN 1", MOS 133
1006	58409.22	244122.52	94+05.93	40.92' LT	11/15/16	FD 1" AXLE, DOWN 2", UNKNOWN ORIGIN, FOUND ON MOS 209
1007	58505.30	244035.60	95+35.46	43.74' LT	11/15/16	FD 5/8" IRON ROD, DOWN 2", MOS 133
1008	58583.00	243972.41	96+35.56	40.66' LT	11/15/16	FD CONC. NAIL & WASHER, FLUSH, MOS 573
1013	58317.13	244201.35	92+83.37	39.65' LT	11/16/16	FD 3/4" INSIDE DIAMETER IRON PIPE, BENT, SPUN FOR POSITION, DOWN 2", UNRECORDED MOS, ELTON SAUNDERS, PLS 405
1014	58217.29	244278.24	91+55.89	40.37' LT	11/16/16	FD 3/4" INSIDE DIAMETER IRON PIPE, FLUSH, UNRECORDED MOS, ELTON SAUNDERS, PLS 405
1015	58210.25	244283.93	91+46.74	40.03' LT	11/16/16	FD 5/8" IRON ROD, FLUSH, MOS 1347
1016	58241.44	244114.24	N/A	N/A	11/16/16	FD 5/8" IRON ROD W/YPC MARKED "BGA SURVEY MARKER", DOWN 1", MOS 1347
1022	56689.07	243990.80	N/A	N/A	11/16/16	FD 2-1/2" BRASS DISK MARKED AS SHOWN THIS SHEET, GRANT COUNTY REMONUMENTATION RECORDS
1026	58554.13	244103.85	95+27.71	39.81' RT	11/22/16	FD SCRIBED "X" IN SIDEWALK, MOS 209
1027	58667.07	244005.12	96+77.72	39.10' RT	11/22/16	FD 1/2" IRON ROD, DOWN 8", UNKNOWN ORIGIN, FOUND ON MOS 209
1028	58667.39	244005.49	96+77.72	39.58' RT	11/22/16	FD 5/8" IRON ROD, DOWN 8", MOS 209
1029	58064.21	244387.18	89+65.80	40.02' LT	11/22/16	FD 5/8" IRON ROD, DOWN 3", RECORD STATION 89+65.43, MOS 209

LEGEND	
○	FOUND MONUMENT
★	SET GPS STATION, SEE TABLE ON SHEET 1
()	RECORD DATA PER REFERENCE LIST ON SHEET 1
FD = FOUND	
MON = MONUMENT	
MOS = MAP OF SURVEY	
YPC = YELLOW PLASTIC CAP	
—	RESOLVED RIGHT OF WAY
---	EXISTING RIGHT OF WAY OR PROPERTY LINE
---	PRIMARY HIGHWAY RIGHT OF WAY CENTER LINE ALIGNMENT
---	EDGE OF PAVEMENT
-x-	FENCE
---	CURB

REGISTERED
PROFESSIONAL
LAND SURVEYOR

OREGON
JAN. 14, 2003
BRET N. ELITHORP
63148

RENEWAL: DEC. 31, 2017

OREGON DEPARTMENT OF TRANSPORTATION
HORIZONTAL CONTROL, RECOVERY AND RETRACEMENT MAP
US395: SIDEWALK IMPROVEMENTS (JOHN DAY)
JOHN DAY - BURNS HIGHWAY (US395)
GRANT COUNTY, OREGON

FOR ODOT REGION 5
3012 ISLAND AVENUE
LA GRANDE, OR 97850

MARCH 2, 2017
SCALE: 1" = 50'
SHEET 3 OF 6

MAP OF SURVEY NO. 2064