
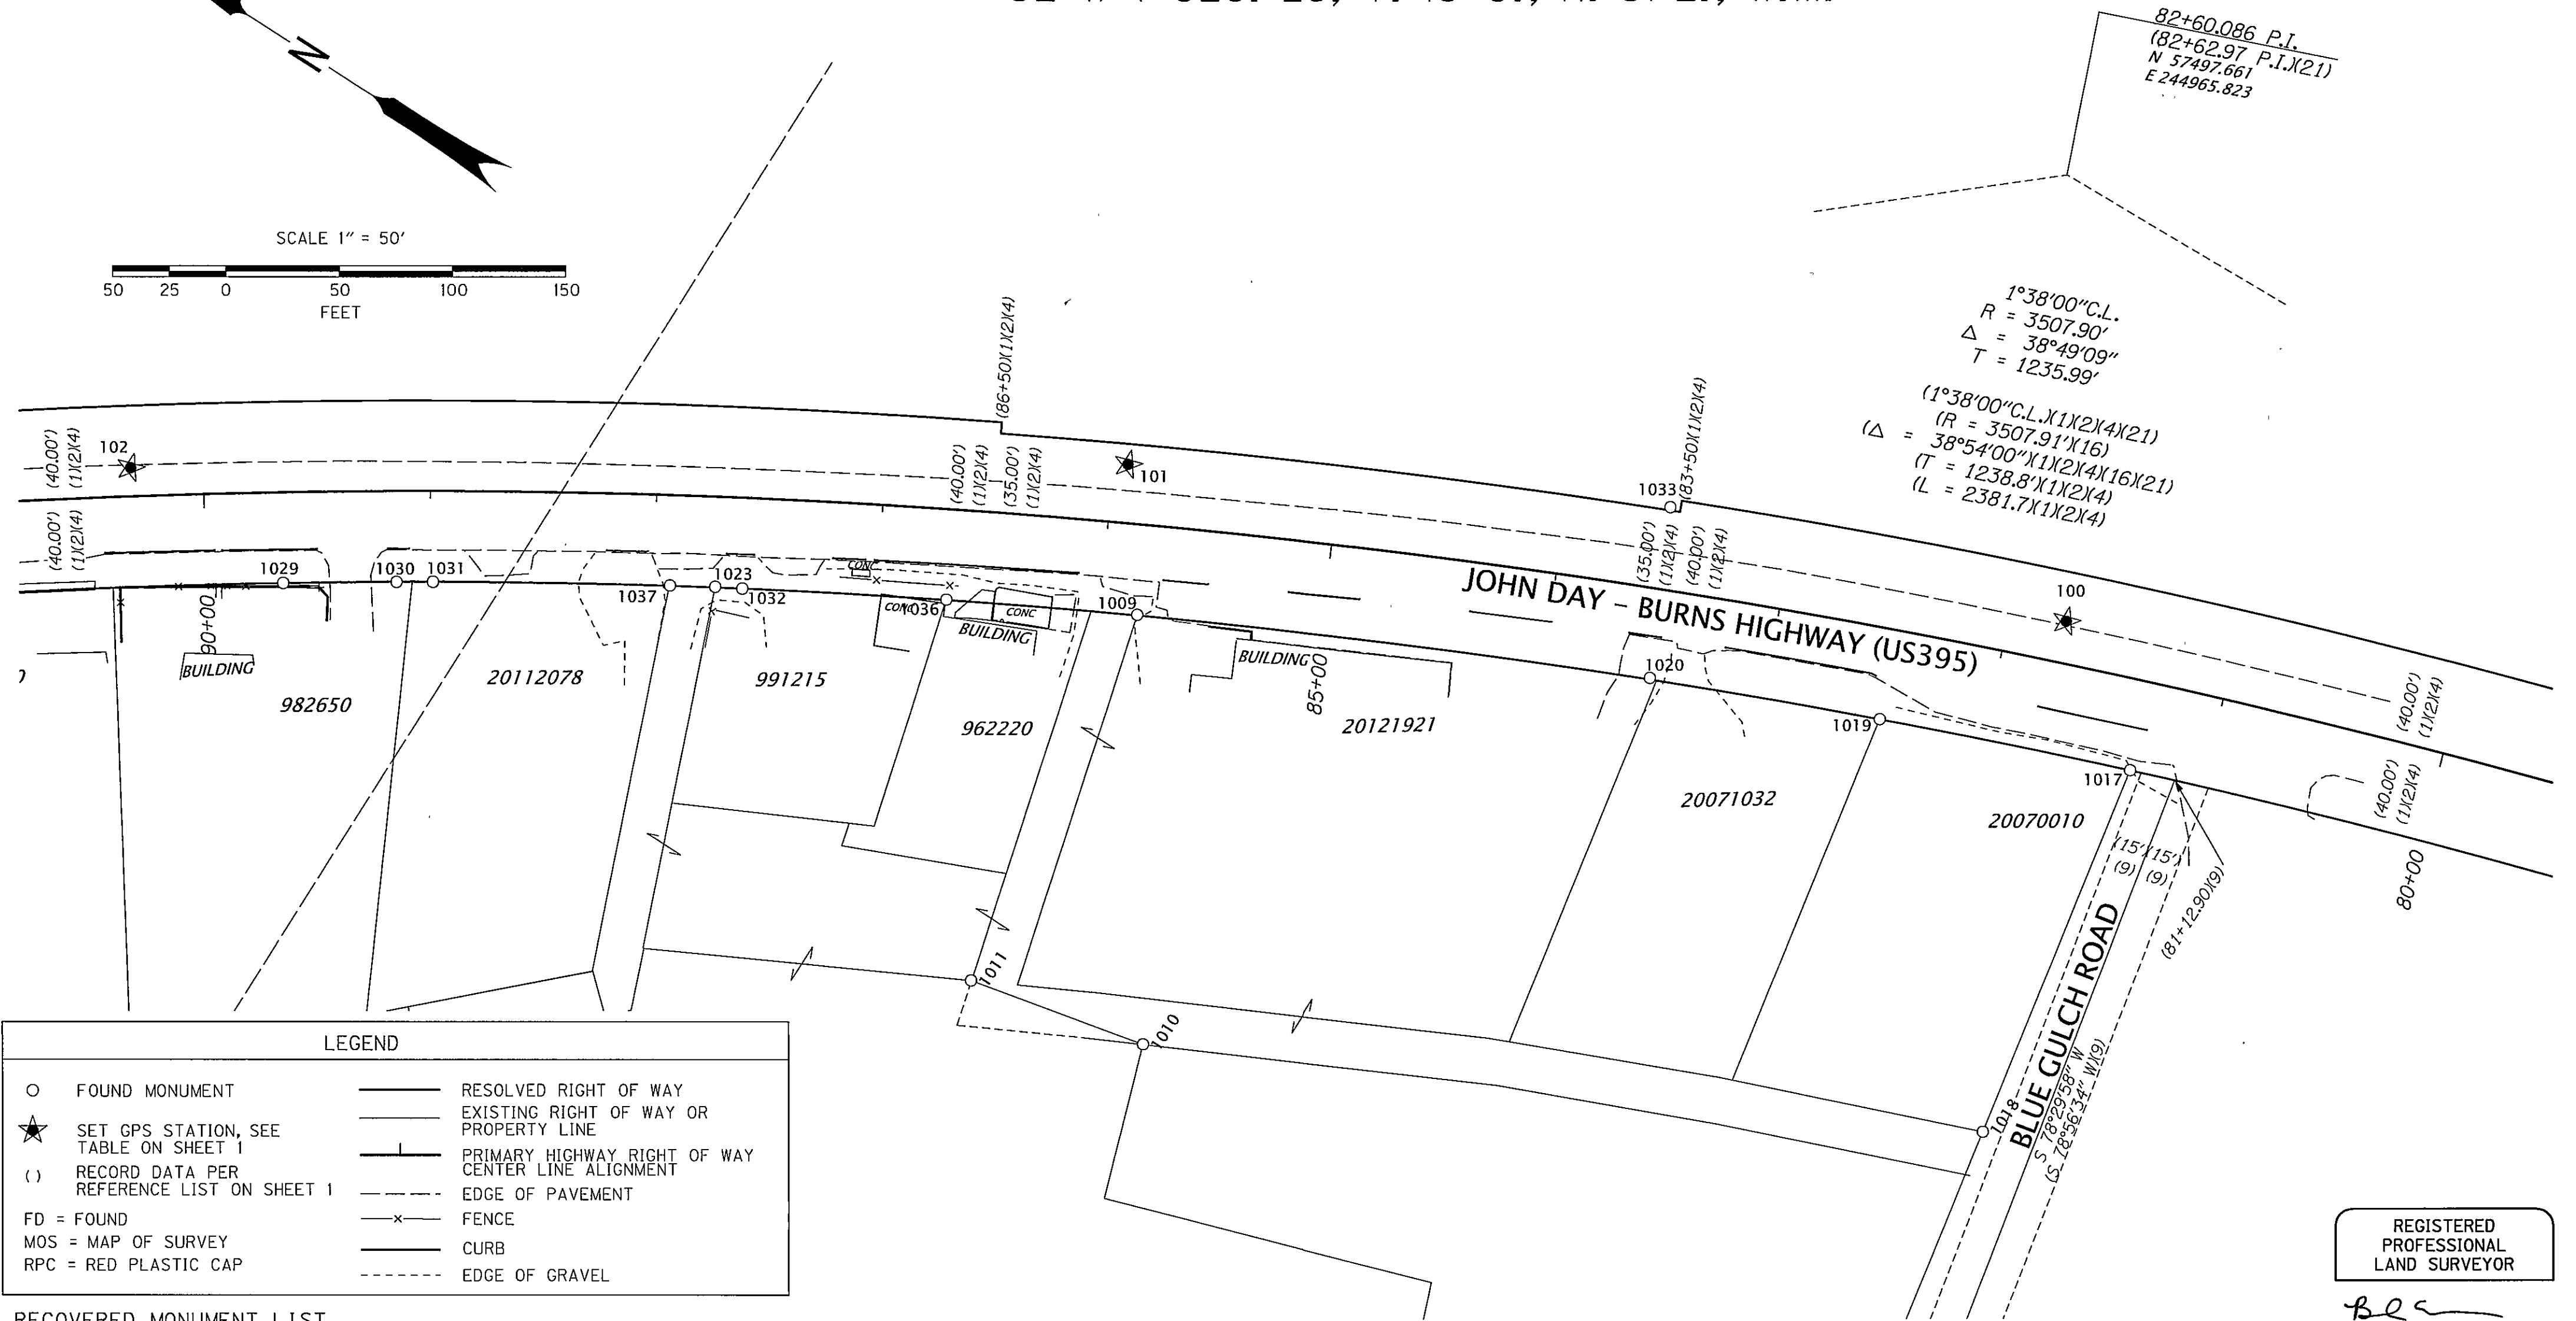


SE 1/4 SEC. 26, T. 13 S., R. 31 E., W.M.

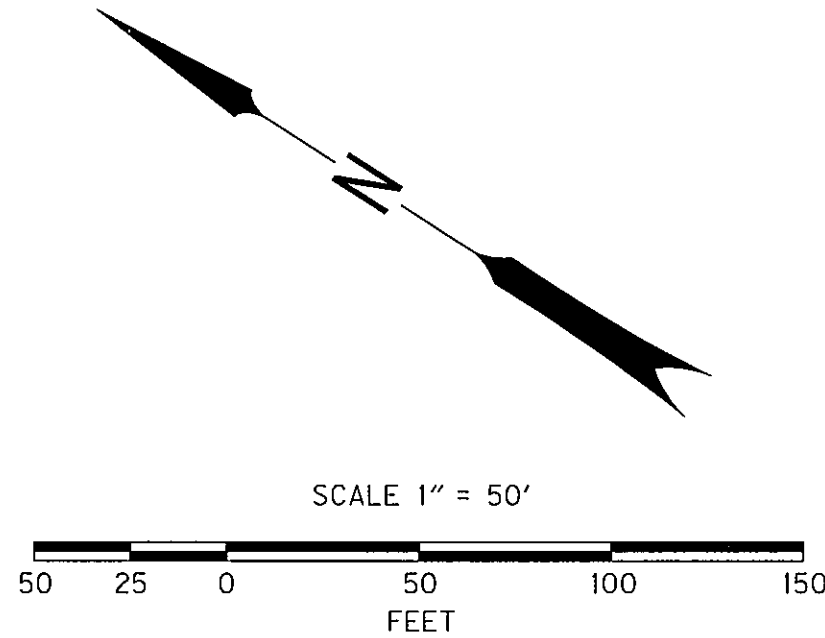

LEGEND

- FOUND MONUMENT
- ★ SET GPS STATION, SEE TABLE ON SHEET 1
- () RECORD DATA PER REFERENCE LIST ON SHEET 1
- FD = FOUND
- MOS = MAP OF SURVEY
- RPC = RED PLASTIC CAP
- RESOLVED RIGHT OF WAY
- EXISTING RIGHT OF WAY OR PROPERTY LINE
- PRIMARY HIGHWAY RIGHT OF WAY CENTER LINE ALIGNMENT
- EDGE OF PAVEMENT
- FENCE
- CURB
- EDGE OF GRAVEL

RECOVERED MONUMENT LIST

PT ID	PROJECT NORTHING	PROJECT EASTING	STATION	OFFSET	DATE	DESCRIPTION & REFERENCE DOCUMENTS
1009	57739.43	244579.98	85+83.57	39.78' LT	11/15/16	FD 5/8" IRON ROD, DOWN 6", MOS 975
1010	57635.08	244421.88	N/A	N/A	11/15/16	FD 5/8" IRON ROD, BENT, SPUN FOR POSITION, MOS 1763
1011	57714.24	244404.15	N/A	N/A	11/15/16	FD 5/8" IRON ROD W/RPC MARKED "CORNERSTONE SURVEYING INC.", FLUSH, MOS 1763
1017	57332.53	244759.74	81+33.30	39.97' LT	11/16/16	FD 5/8" IRON ROD W/RPC MARKED "CORNERSTONE SURVEYING INC.", FLUSH, MOS 1782
1018	57301.42	244590.56	N/A	N/A	11/16/16	FD 5/8" IRON ROD W/RPC MARKED "CORNERSTONE SURVEYING INC.", FLUSH, MOS 1793
1019	57437.91	244719.05	82+47.58	39.96' LT	11/16/16	FD 5/8" IRON ROD W/RPC MARKED "CORNERSTONE SURVEYING INC.", FLUSH, MOS 1793
1020	57533.15	244679.53	83+51.87	39.30' LT	11/16/16	FD 1-1/4" INSIDE DIAMETER IRON PIPE, FLUSH, UNKNOWN ORIGIN
1023	57902.96	244489.02	87+72.86	39.78' LT	11/16/16	FD 1-1/2" AXLE, FLUSH, UNKNOWN ORIGIN, MOS 230 SHOWS 5/8" IRON ROD SET AT RECORD STATION 87+72.48
1029	58064.21	244387.18	89+65.80	40.02' LT	11/22/16	FD 5/8" IRON ROD, DOWN 3", RECORD STATION 89+65.43, MOS 209
1030	58022.42	244414.67	89+15.20	40.04' LT	11/22/16	FD 5/8" IRON ROD, DOWN 6", RECORD STATION 89+14.83, MOS 209
1031	58008.92	244423.39	88+98.95	40.03' LT	11/22/16	FD 5/8" IRON ROD, DOWN 5", RECORD STATION 89+98.68, MOS 209
1032	57892.49	244494.88	87+60.73	40.06' LT	11/22/16	FD 5/8" IRON ROD, DOWN 7", RECORD STATION 87+60.34, MOS 209
1033	57566.09	244747.73	83+54.52	36.38' RT	11/22/16	FD 1" INSIDE DIAMETER IRON PIPE, UNKNOWN ORIGIN
1036	57814.05	244539.76	86+69.31	39.91' LT	12/21/16	FD 2" INSIDE DIAMETER IRON PIPE, DOWN 1.5', UNKNOWN ORIGIN, FOUND IN MOS 975
1037	57920.04	244478.68	87+93.06	39.92' LT	12/21/16	FD 3" AXLE, DOWN 6", BENT EASTERLY, TIED IN PLACE, UNKNOWN ORIGIN, MOS 387 SHOWS 5/8" IRON ROD

REGISTERED
PROFESSIONAL
LAND SURVEYOR

BLS
OREGON
JAN. 14, 2003
BRET N. ELITHORP
63148

RENEWAL: DEC. 31, 2017

OREGON DEPARTMENT OF TRANSPORTATION
HORIZONTAL CONTROL, RECOVERY AND RETRACEMENT MAP
US395: SIDEWALK IMPROVEMENTS (JOHN DAY)
JOHN DAY - BURNS HIGHWAY (US395)
GRANT COUNTY, OREGON



FOR ODOT REGION 5
3012 ISLAND AVENUE
LA GRANDE, OR 97850

MARCH 2, 2017
SCALE: 1" = 50'
SHEET 4 OF 6