


SE 1/4 SEC. 26, T. 13 S., R. 31 E., W.M.
NE 1/4 SEC. 35, T. 13 S., R. 31 E., W.M.

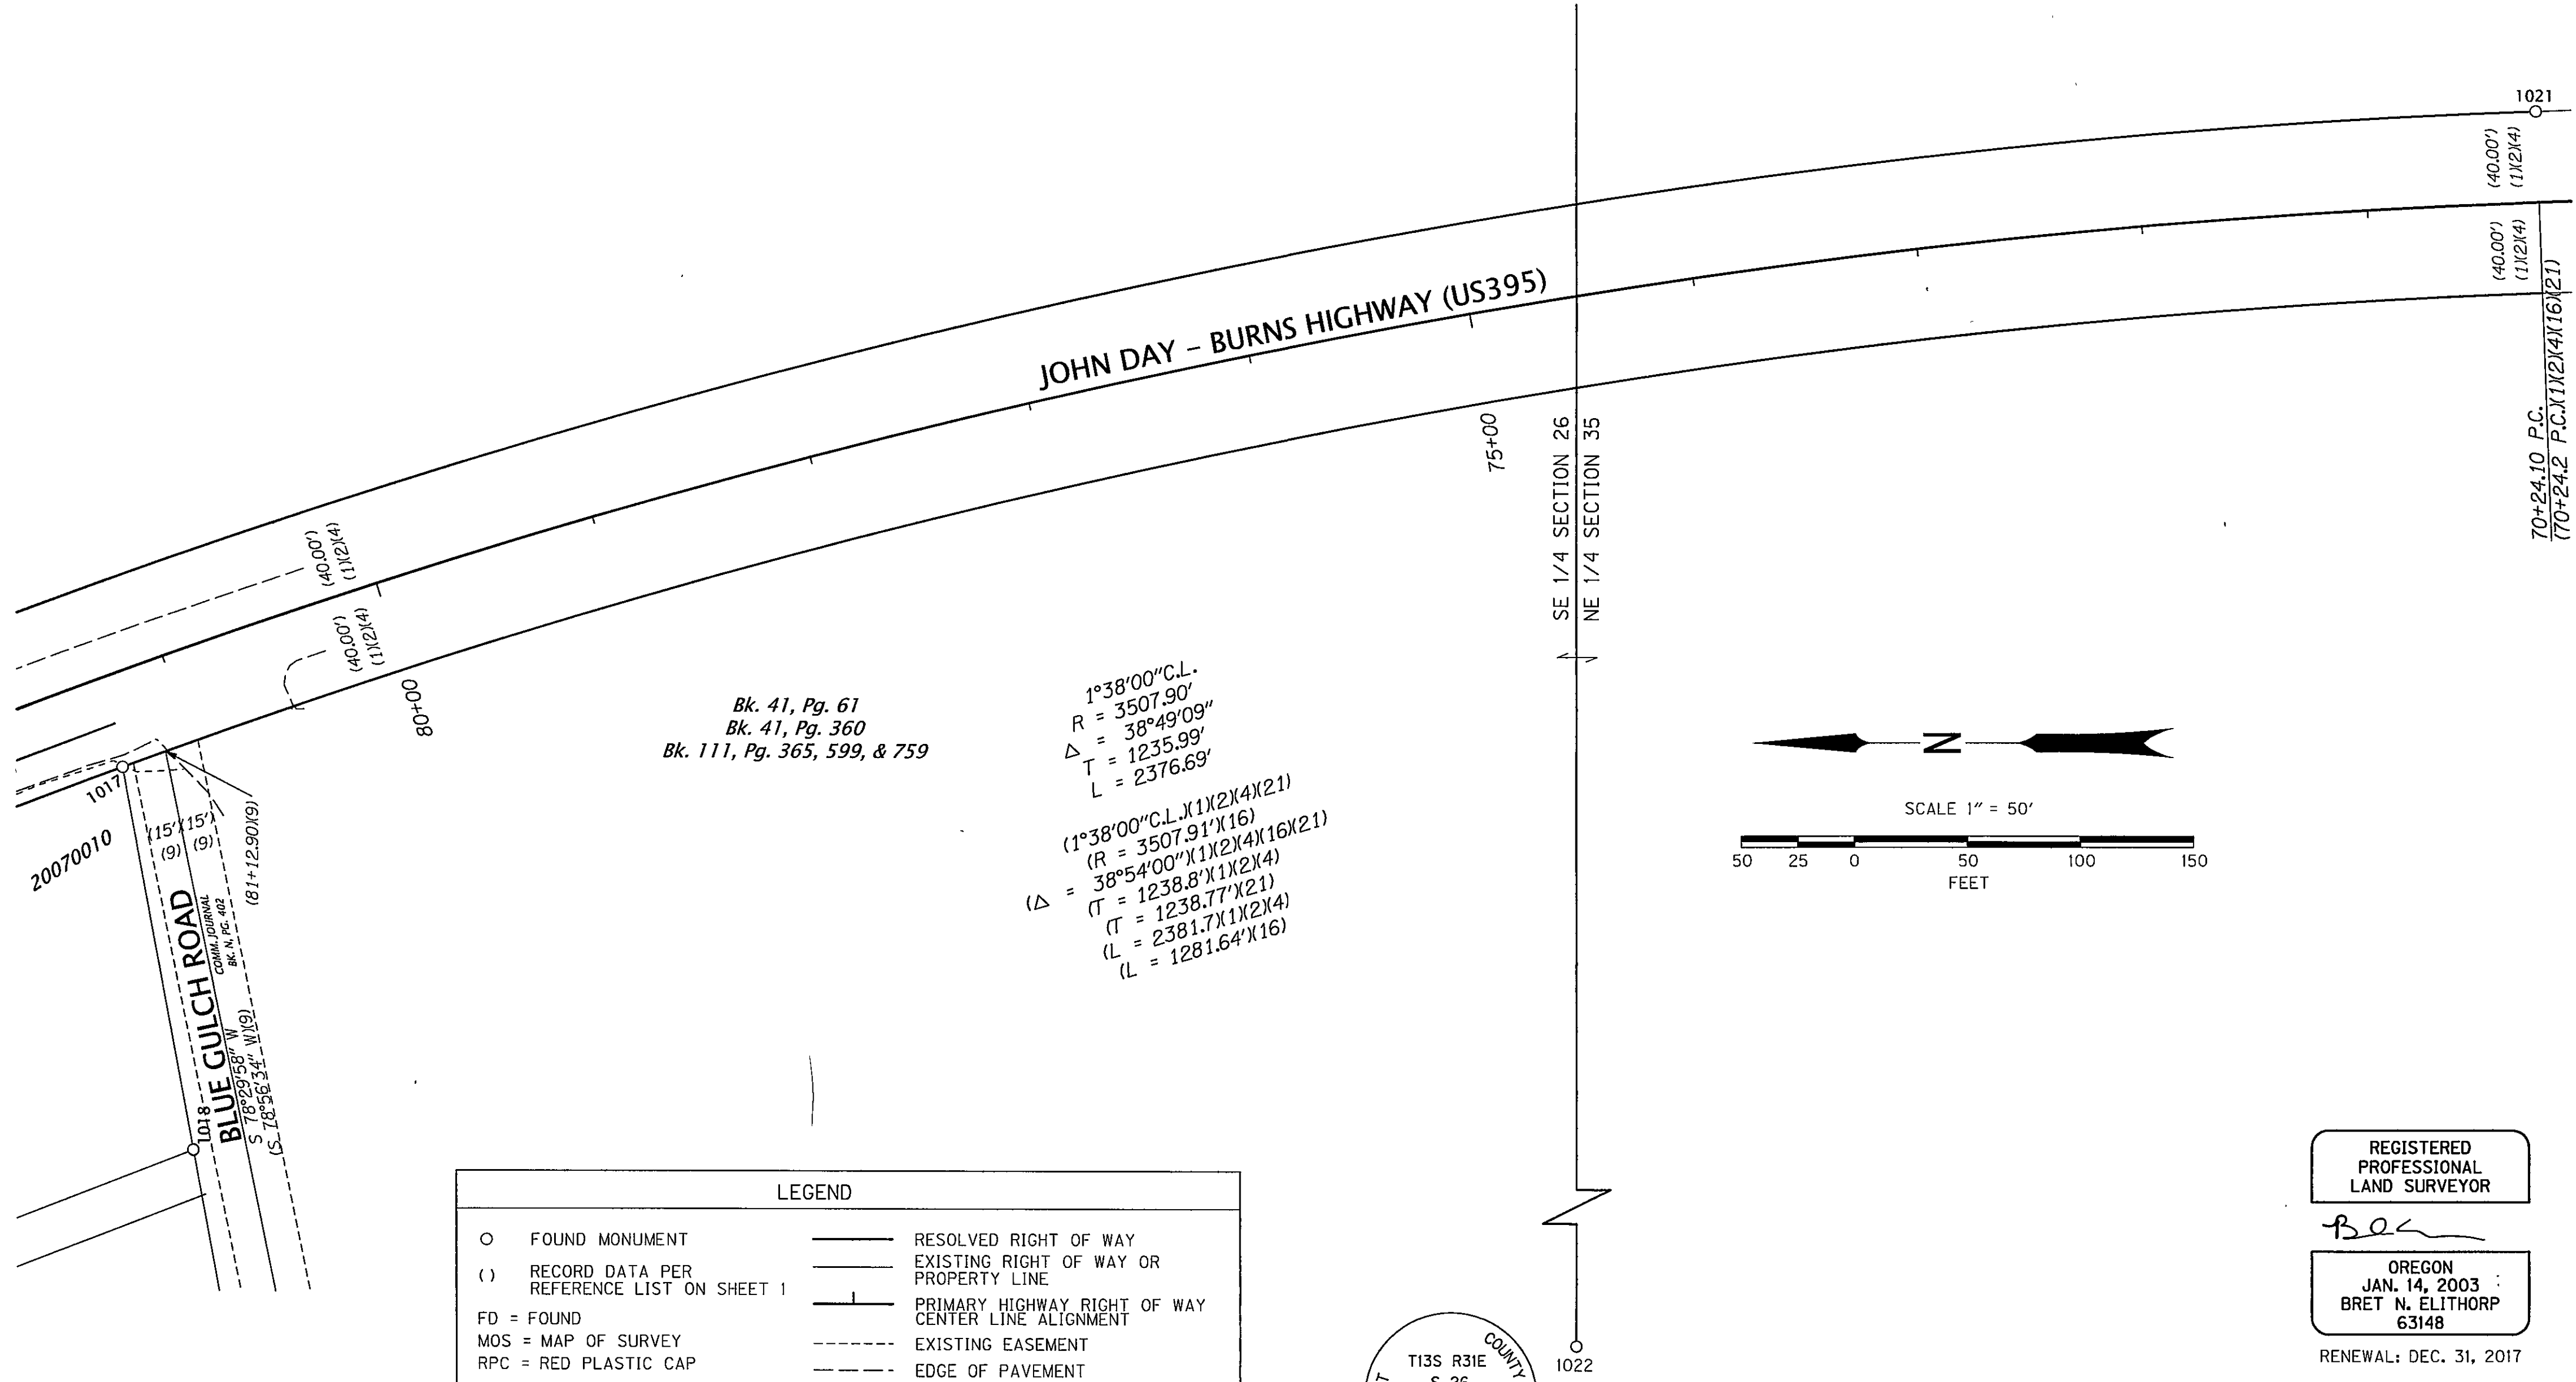

Bk. 41, Pg. 61
Bk. 41, Pg. 360
Bk. 111, Pg. 365, 599, & 759

1°38'00" C.L.
R = 3507.90'
Δ = 38°49'09"
T = 1235.99'
L = 2376.69'

(1°38'00" C.L.)(1)(2)(4)(21)
(R = 3507.91')(16)
(Δ = 38°54'00")(1)(2)(4)(16)(21)
(T = 1238.8')(1)(2)(4)
(T = 1238.77')(21)
(L = 2381.7')(1)(2)(4)
(L = 1281.64')(16)

LEGEND			
○	FOUND MONUMENT	———	RESOLVED RIGHT OF WAY
()	RECORD DATA PER REFERENCE LIST ON SHEET 1	———	EXISTING RIGHT OF WAY OR PROPERTY LINE
FD = FOUND		———	PRIMARY HIGHWAY RIGHT OF WAY CENTER LINE ALIGNMENT
MOS = MAP OF SURVEY		-----	EXISTING EASEMENT
RPC = RED PLASTIC CAP		-----	EDGE OF PAVEMENT
		———	CURB
		-----	EDGE OF GRAVEL

RECOVERED MONUMENT LIST

PT ID	PROJECT NORTHING	PROJECT EASTING	STATION	OFFSET	DATE	DESCRIPTION & REFERENCE DOCUMENTS
1017	57332.53	244759.74	81+33.30	39.97' LT	11/16/16	FD 5/8" IRON ROD W/RPC MARKED "CORNERSTONE SURVEYING INC.", FLUSH, MOS 1782
1018	57301.42	244590.56	N/A	N/A	11/16/16	FD 5/8" IRON ROD W/RPC MARKED "CORNERSTONE SURVEYING INC.", FLUSH, MOS 1793
1021	56263.99	245050.28	70+24.17	39.95' RT	11/16/16	FD 4" CONC. POST, TOP HAS ERODED AND CAP IS MISSING, SET & TIED PK NAIL IN CENTER OF IT, ODOT DRG. 8B-3-31
1022	56689.07	243990.80	N/A	N/A	11/16/16	FD 2-1/2" BRASS DISK MARKED AS SHOWN THIS SHEET, GRANT COUNTY REMONUMENTATION RECORDS

REGISTERED
PROFESSIONAL
LAND SURVEYOR

OREGON
JAN. 14, 2003 :
BRET N. ELITHORP
63148

RENEWAL: DEC. 31, 2017

OREGON DEPARTMENT OF TRANSPORTATION
HORIZONTAL CONTROL, RECOVERY AND RETRACEMENT MAP
US395: SIDEWALK IMPROVEMENTS (JOHN DAY)
JOHN DAY - BURNS HIGHWAY (US395)
GRANT COUNTY, OREGON

FOR ODOT REGION 5
3012 ISLAND AVENUE
LA GRANDE, OR 97850

MARCH 2, 2017
SCALE: 1" = 50'
SHEET 5 OF 6