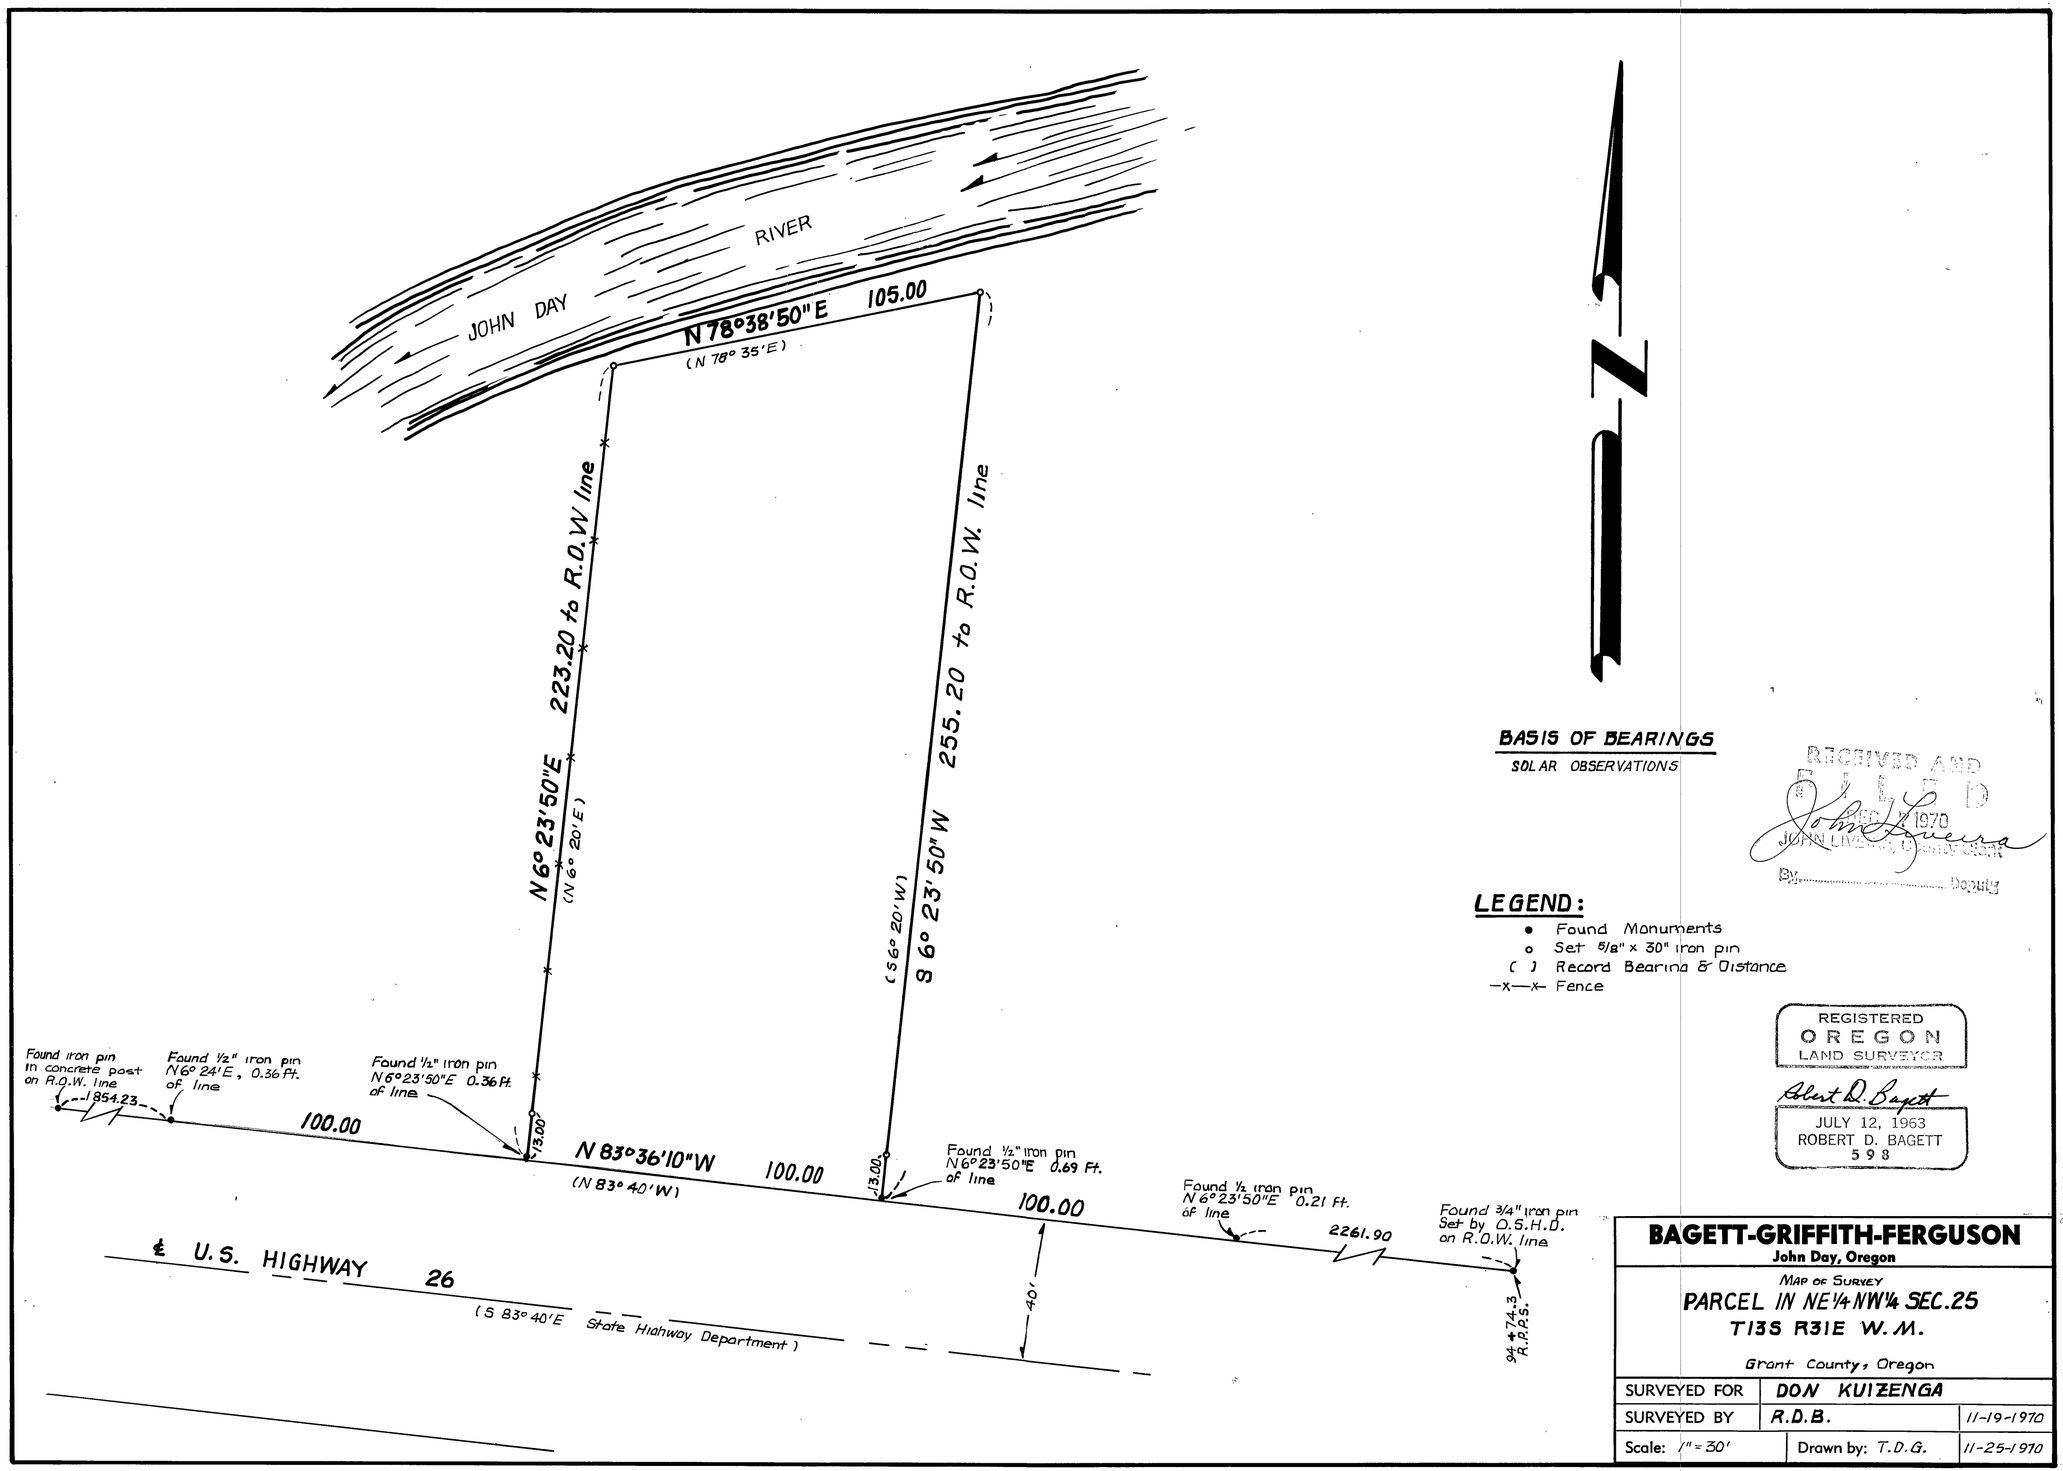

Map of Survey No. 207