


SW 1/4 SEC. 25, T. 14 S., R. 31 E., W.M.

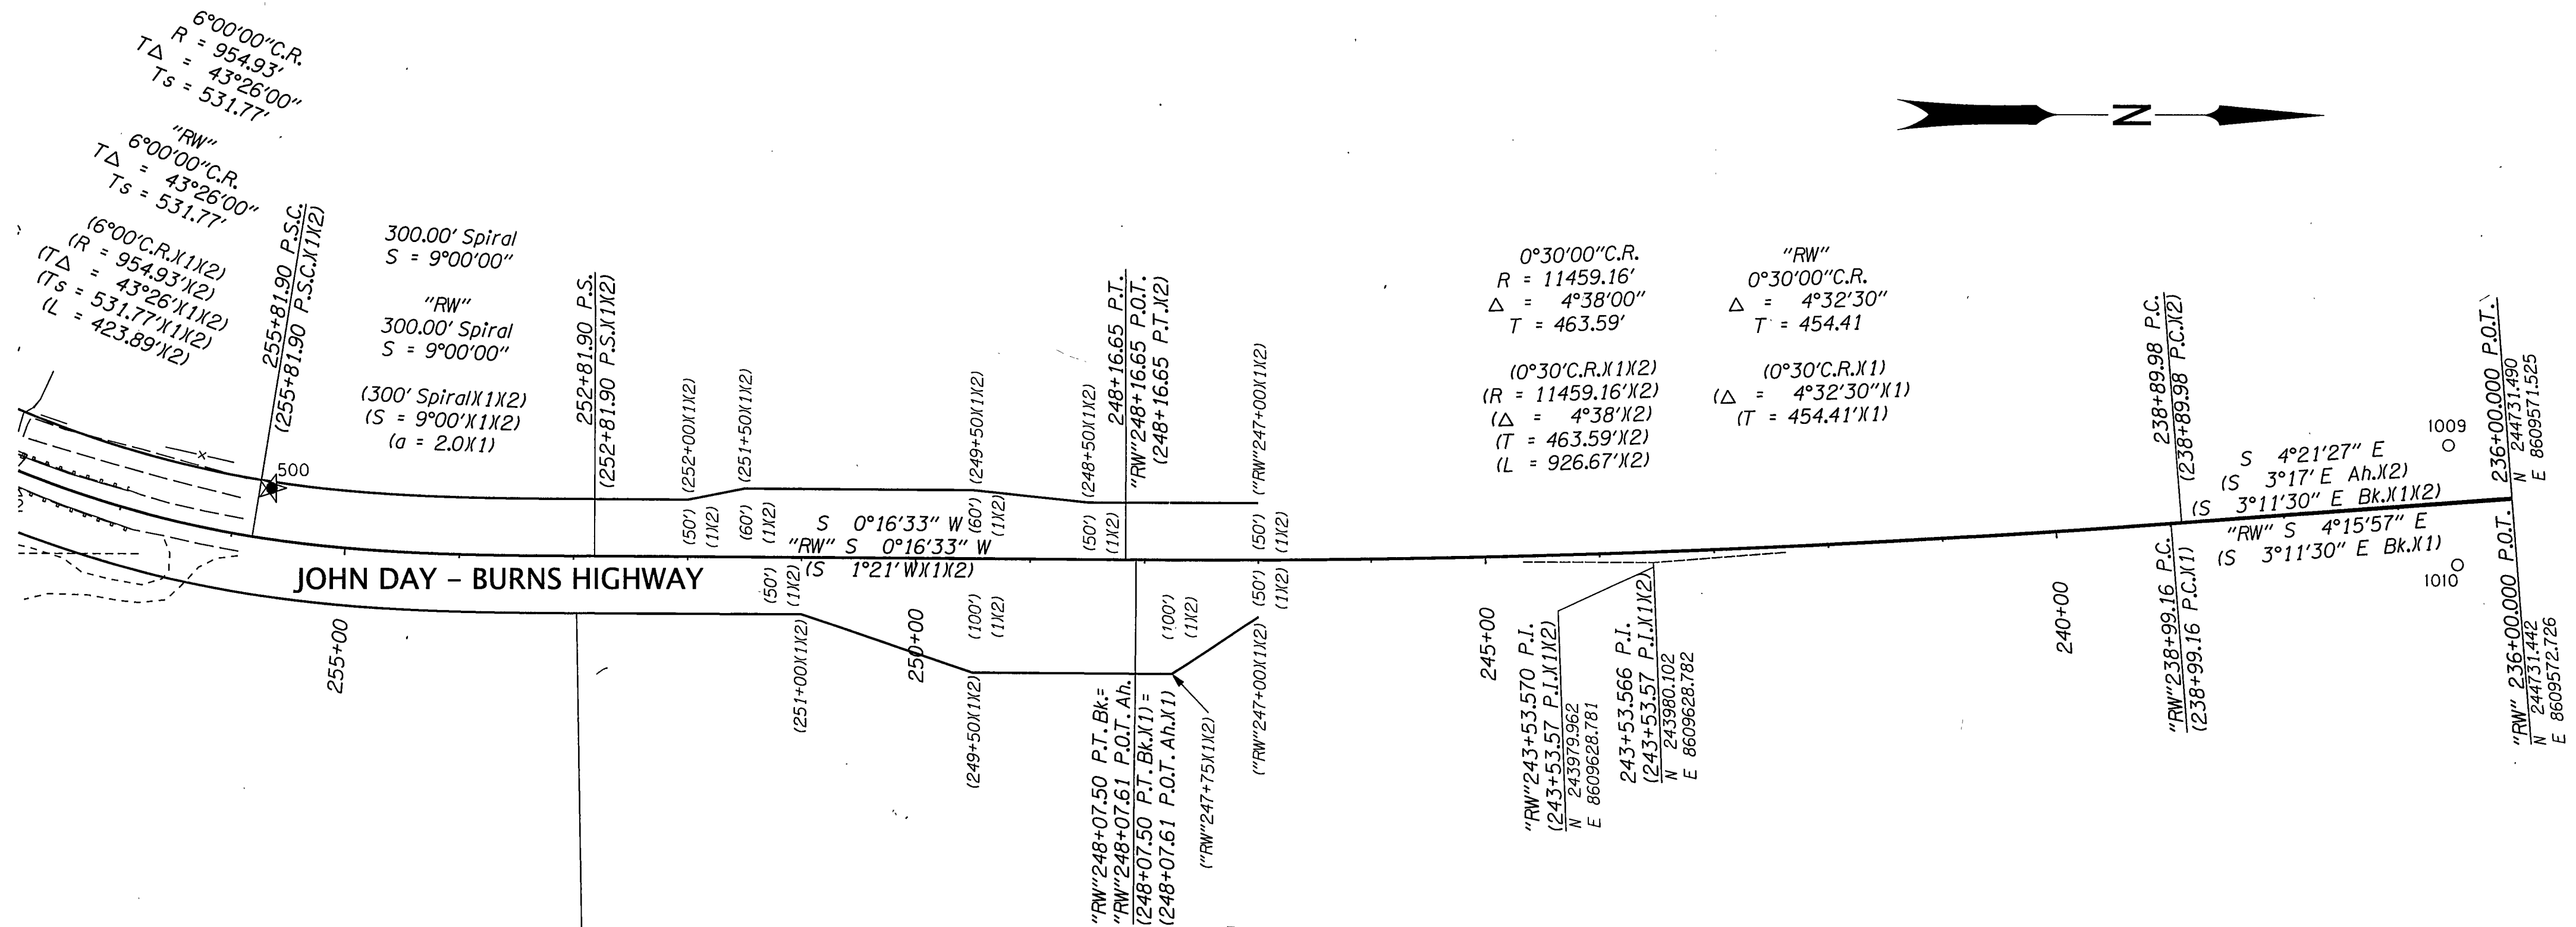

REFERENCES

1. ODOT DRG. NO. 8B-18-25 BY THE OREGON STATE HIGHWAY DEPT., DATED JULY 1960
2. ODOT DRG. NO. 10B-5-9 BY THE OREGON STATE HIGHWAY DEPT., DATED APR. - NOV. 1962
3. MAP OF SURVEY NO. 262 BY ROBERT D. BAGETT, FILED MAY 22, 1972
4. MAP OF SURVEY NO. 373 BY ROBERT D. BAGETT, FILED JULY 28, 1975
5. MAP OF SURVEY NO. 433 BY ROBERT D. BAGETT, FILED APR. 18, 1977
6. MAP OF SURVEY NO. 609 BY DOUGLAS M. FERGUSON, FILED MAR. 31, 1980
7. MAP OF SURVEY NO. 763 BBY ROBERT D. BAGETT, FILED APR. 28, 1983

DN = DOWN
DRG. = DRAWING
I.D. = INSIDE DIAMETER
M.O.S. = MAP OF SURVEY
ODOT = OREGON DEPARTMENT OF TRANSPORTATION

REGISTERED
PROFESSIONAL
LAND SURVEYOR

Bret N. Elithorp

OREGON
JAN. 14, 2003
BRET N. ELITHORP
63148

RENEWAL: DEC. 31, 2017

LEGEND

- FOUND MONUMENT
- ★ SET GPS STATION, SEE TABLE ON SHEET 1
- () RECORD DATA PER REFERENCE LIST ON THIS SHEET
- RIGHT OF WAY CENTER LINE
- RESOLVED RIGHT OF WAY
- EXISTING RIGHT OF WAY OR PROPERTY LINE
- EDGE OF PAVEMENT
- EDGE OF GRAVEL
- x- FENCE
- GUARDRAIL

RECOVERED MONUMENT LIST

PT ID	LDP NORTHING	LDP EASTING	STATION	OFFSET	DATE	DESCRIPTION & REFERENCE DOCUMENTS
1000	242021.33	8608746.04	N/A	N/A	2/08/2016	FOUND 2-1/2" BRASS DISK MARKED "GRANT COUNTY SURVEYOR S26 S25 S35 S36 1972 LS 598"
1001	241826.84	8608959.62	267+13.43	55.21' RT	2/08/2016	FOUND 1" BRASS DISK IN CONCRETE, DN 0.5', ODOT DRG. 10B-5-9
1002	241833.21	8608966.18	267+05.33	51.98' RT	2/08/2016	FOUND 3/4" I.D. IRON PIPE, UP 0.8', ODOT DRG. 10B-5-9
1003	241816.83	8608958.55	267+22.47	52.01' RT	2/08/2016	FOUND 3/4" I.D. IRON PIPE, BENT, TIED IN PLACE, UP 1.5', ODOT DRG. 10B-5-9
1004	240725.33	8608796.06	278+08.08	44.44' RT	2/10/2016	FOUND 1" BRASS DISK IN CONCRETE, DN 0.3', ODOT DRG. 10B-5-9
1005	240715.35	8608794.92	278+18.16	44.43' RT	2/10/2016	FOUND 3/4" I.D. IRON PIPE, UP 0.2', ODOT DRG. 10B-5-9
1006	240735.35	8608796.94	277+97.98	44.71' RT	2/10/2016	FOUND 3/4" I.D. IRON PIPE, BENT, TIED IN PLACE, UP 0.6', ODOT DRG. 10B-5-9
1007	240713.20	8608895.19	278+08.79	-55.42' LT	2/10/2016	FOUND 1" BRASS DISK IN CONCRETE, FLUSH, ODOT DRG. 10B-5-9
1008	240726.09	8608896.55	277+95.89	-55.31' LT	2/10/2016	FOUND 3/4" I.D. IRON PIPE, UP 1.2', ODOT DRG. 10B-5-9
1009	244675.86	8609525.62	236+51.98	50.00' RT	2/10/2016	FOUND 3/4" I.D. IRON PIPE WITH BRASS PLUG MARKED "R/W POT", UP 0.2', ODOT DRG. 10B-5-9
1010	244683.68	8609630.33	236+52.14	-55.01' LT	2/10/2016	FOUND 3" BRASS DISK IN CONCRETE MARKED "BUREAU OF PUBLIC ROADS", ODOT DRG. 10B-5-9
1011	242463.97	8609444.71	259+19.68	58.41' RT	2/10/2016	FOUND 5/8" IRON ROD, DN 0.4', MOS 433

OREGON DEPARTMENT OF TRANSPORTATION

HORIZONTAL CONTROL, RECOVERY AND RETRACEMENT MAP

US395: CANYON CREEK FLOOD MITIGATION

JOHN DAY - BURNS HIGHWAY (US 395)

GRANT COUNTY, OR



FOR ODOT REGION 5
3012 ISLAND AVENUE
LA GRANDE, OR 97850

NOVEMBER 15, 2017

SCALE: 1" = 100'

SHEET 2 OF 2

RECORD MAP OF SURVEY NO. 2081