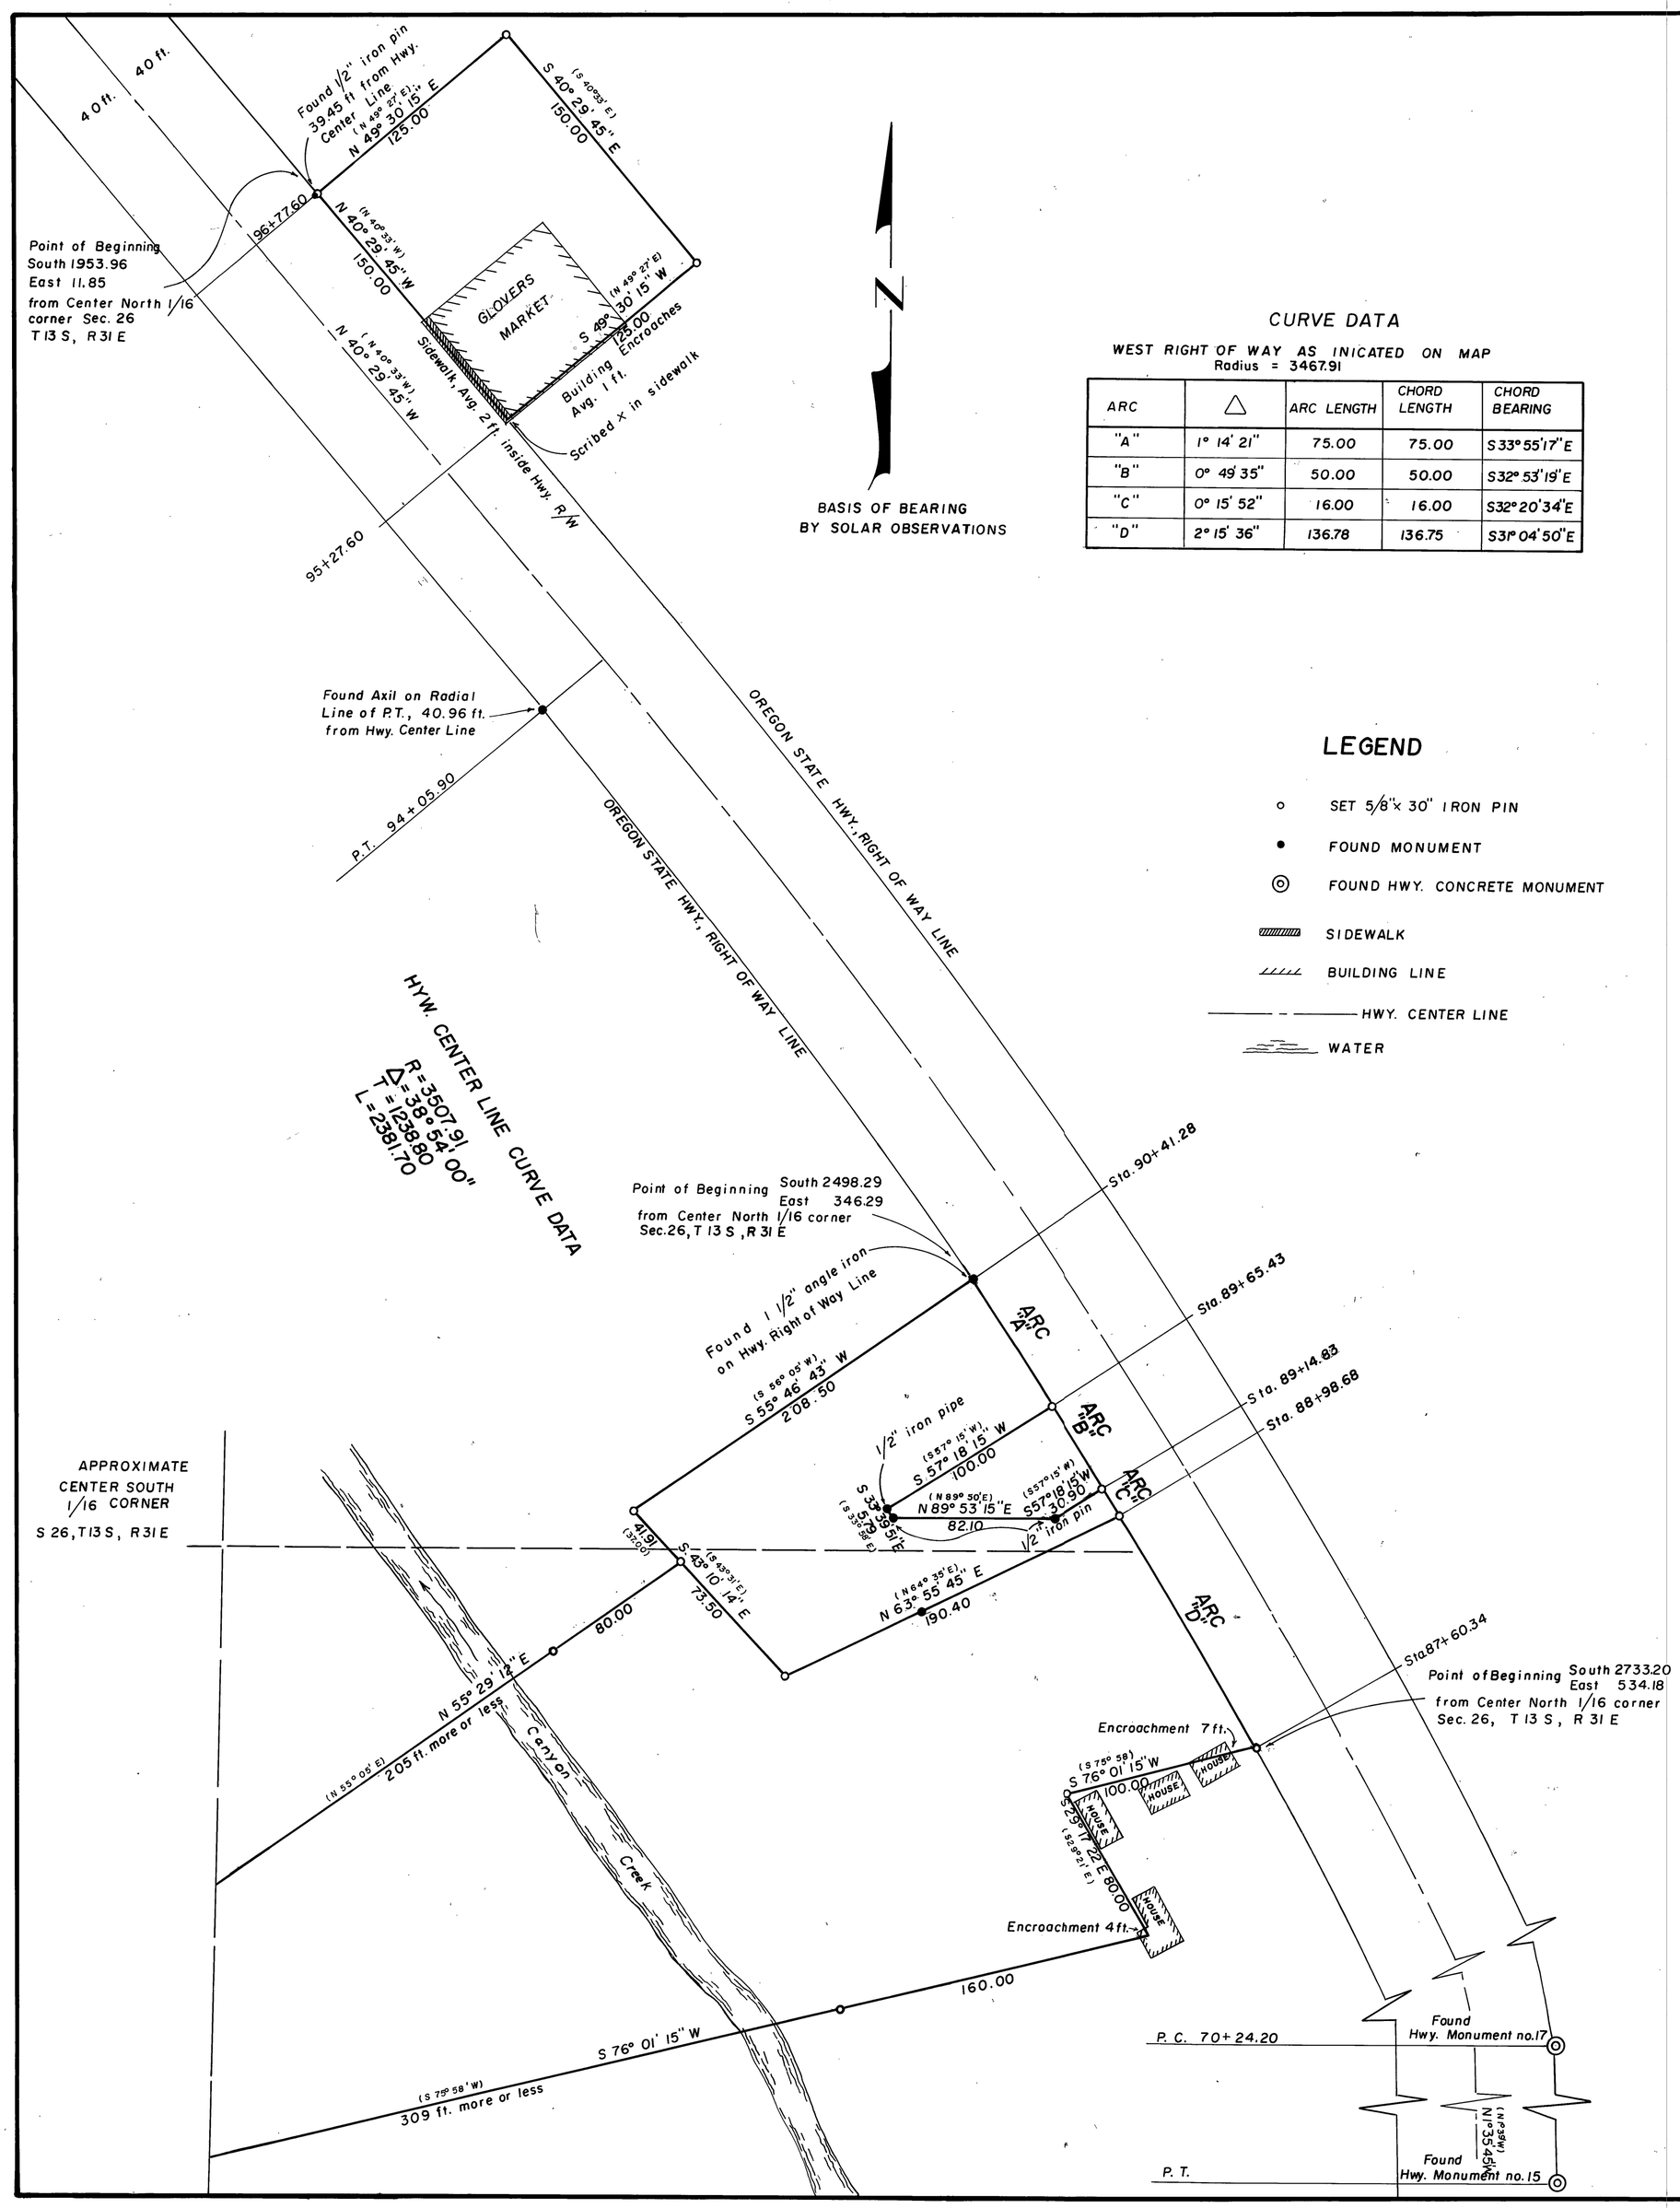

BASIS OF BEARING
BY SOLAR OBSERVATIONS

CURVE DATA

WEST RIGHT OF WAY AS INICATED ON MAP
Radius = 3467.91

ARC	△	ARC LENGTH	CHORD LENGTH	CHORD BEARING
"A"	1° 14' 21"	75.00	75.00	S 33° 55' 17" E
"B"	0° 49' 35"	50.00	50.00	S 32° 53' 19" E
"C"	0° 15' 52"	16.00	16.00	S 32° 20' 34" E
"D"	2° 15' 36"	136.78	136.75	S 31° 04' 50" E

LEGEND

- ○ SET 5/8" x 30" IRON PIN
- ● FOUND MONUMENT
- ◎ FOUND HWY. CONCRETE MONUMENT
- SIDEWALK
- BUILDING LINE
- HWY. CENTER LINE
- WATER

REFERENCE MATERIAL

Oregon Highway Dep. as Constructed Map
Drg. No. 8B-3-31 1956

Unrecorded Map of Survey for this aria
By Elton Saunders Oro. L.S. 405

REGISTERED
OREGON
LAND SURVEYOR
Douglas M Ferguson
JULY 12, 1968
DOUGLAS M. FERGUSON
848

RECEIVED AND FILED
John Lineura

BAGETT-GRIFFITH-FERGUSON
John Day, Oregon

Properties Situated in the West 1/2 of the South East 1/4 Section 26
Township 13 South, Range 31 East W.M.

GRANT COUNTY OREGON

SURVEYED FOR	H.E. GLOVER & R. L. BOETHIN	
SURVEYED BY	D.M.F & R.D.B.	Nov. 1970
Scale: 1" = 50'	Drawn by: D.M.F	Nov. 1970

Map of Survey # 209