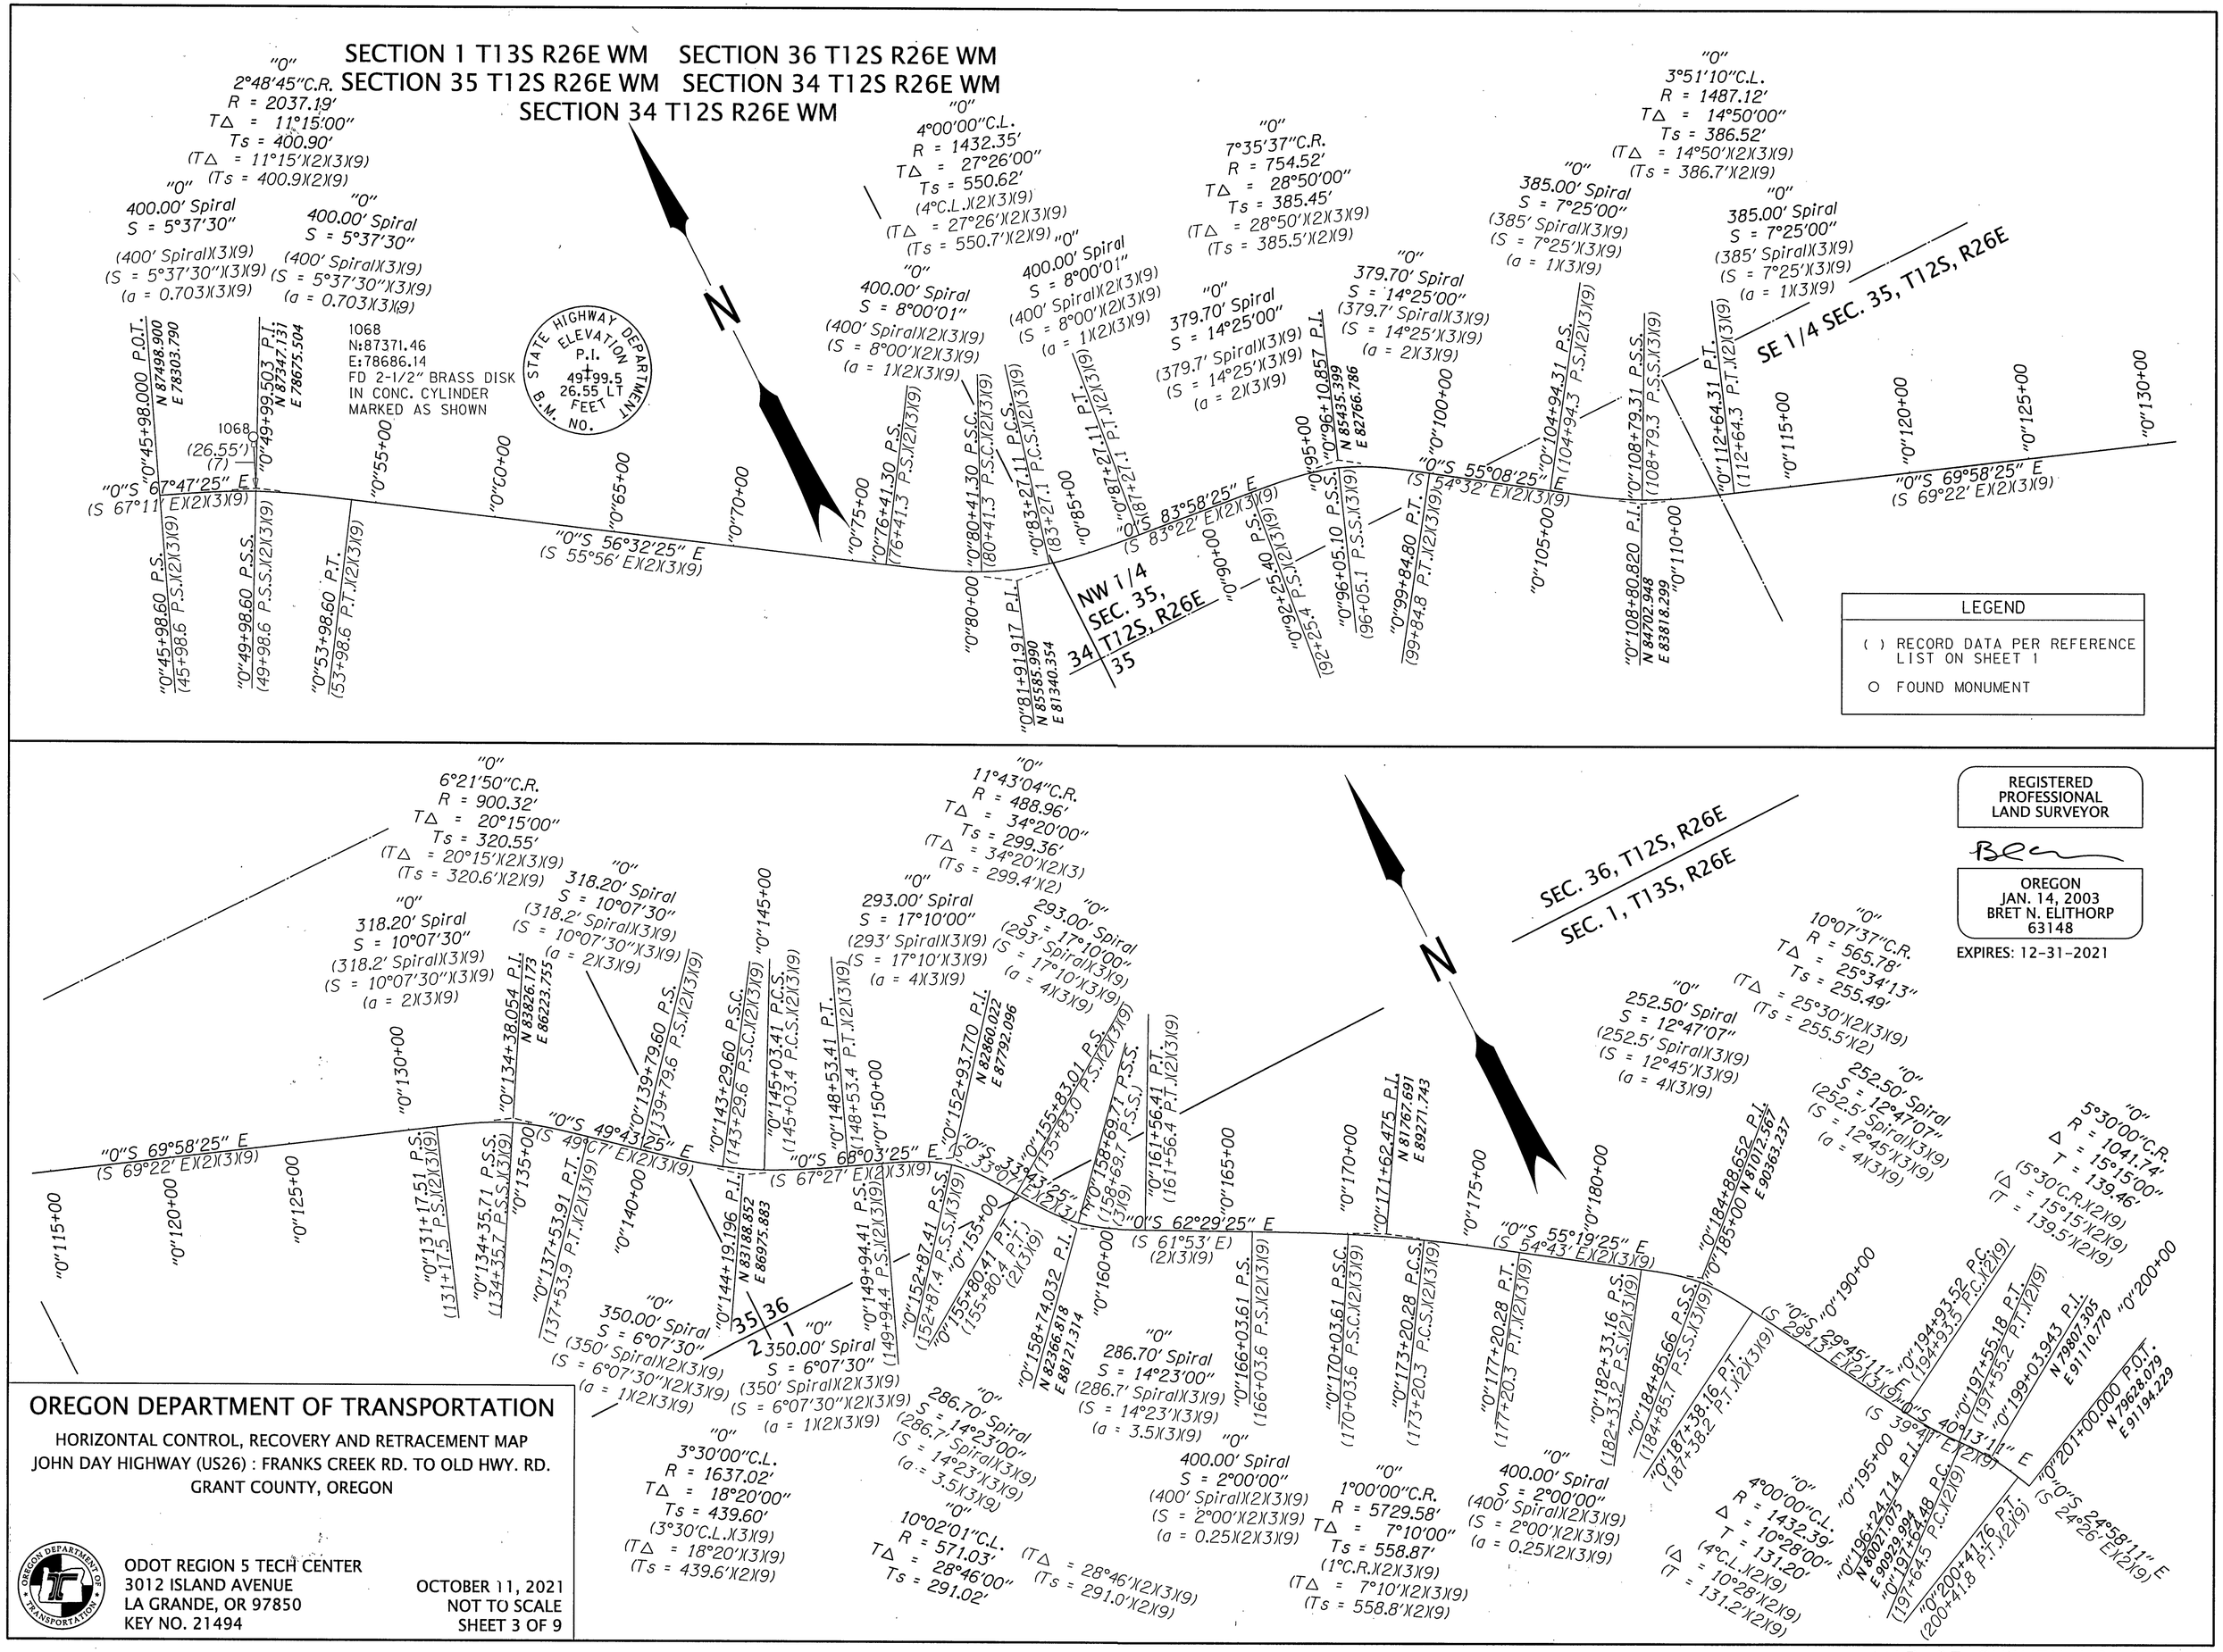

OREGON DEPARTMENT OF TRANSPORTATION

HORIZONTAL CONTROL, RECOVERY AND RETRACEMENT MAP
JOHN DAY HIGHWAY (US26) : FRANKS CREEK RD. TO OLD HWY. RD.
GRANT COUNTY, OREGON

ODOT REGION 5 TECH CENTER
3012 ISLAND AVENUE
LA GRANDE, OR 97850
KEY NO. 21494

OCTOBER 11, 2021
NOT TO SCALE
SHEET 3 OF 9

MAP OF SURVEY NO. 2166