
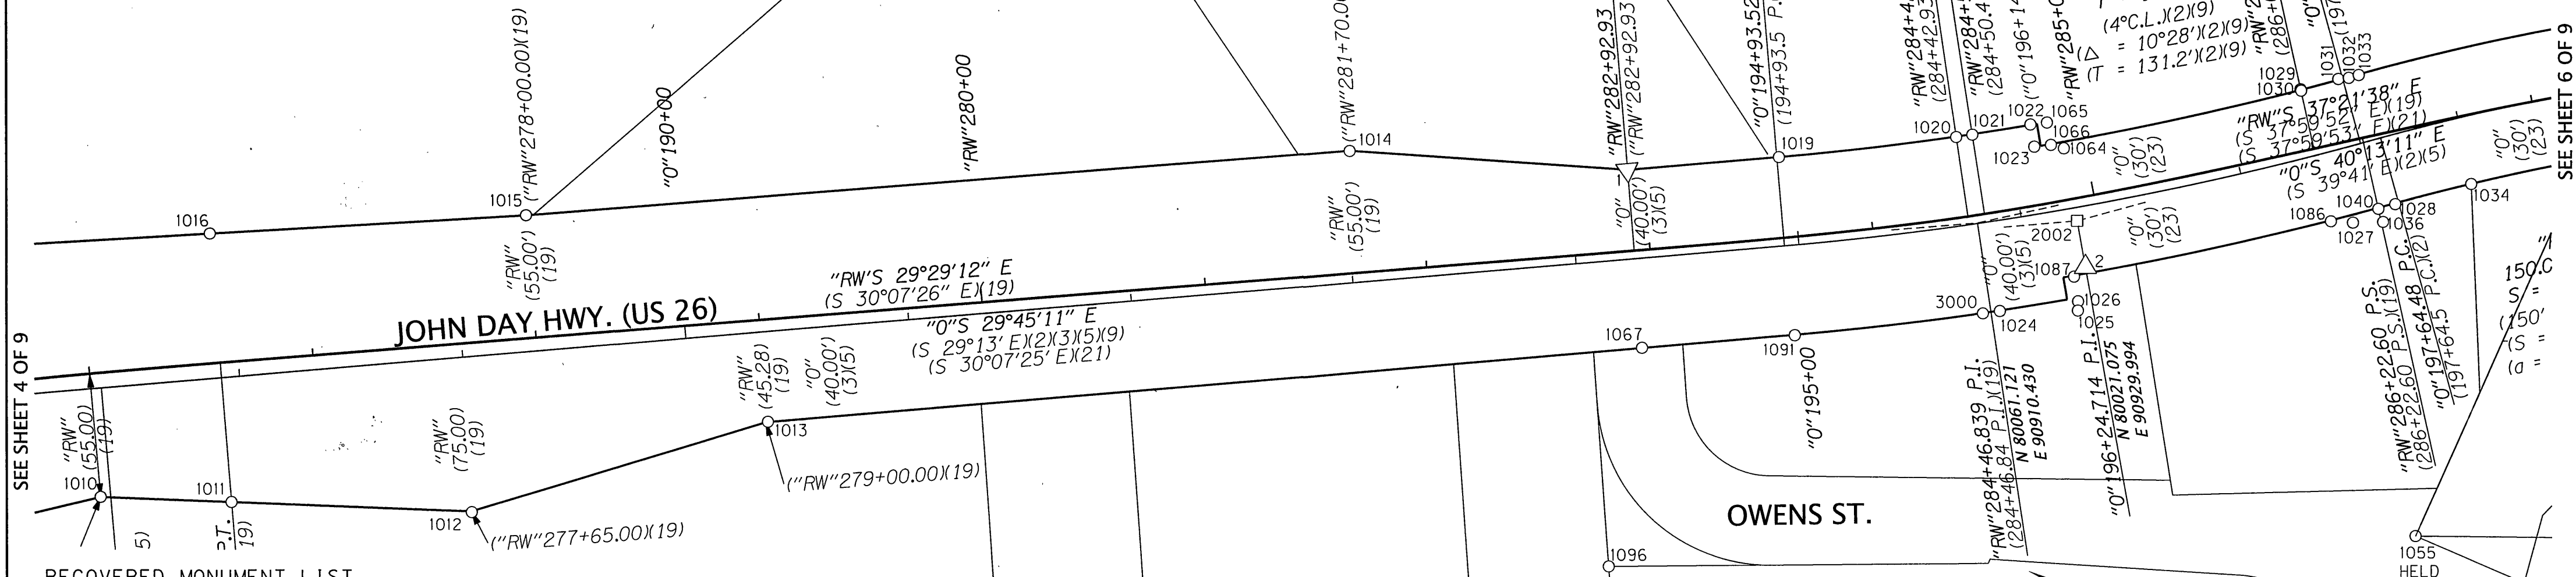


NE 1/4 SECTION 1 T13S R26E WM SE 1/4 SECTION 1 T13S R26E WM

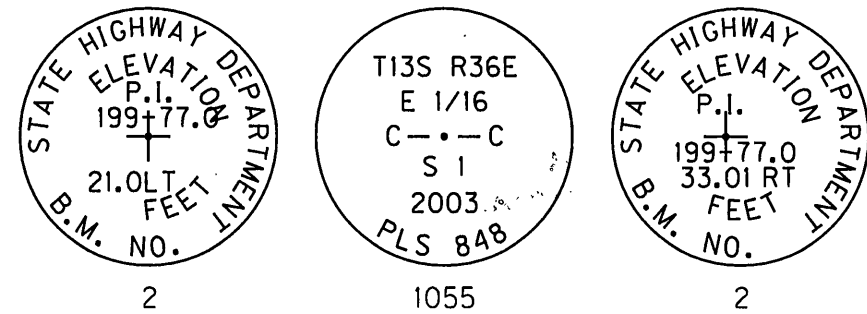

RECOVERED MONUMENT LIST

| PT ID | NORTHING | EASTING  | STATION       | OFFSET    | DATE       | DESCRIPTION & REFERENCE DOCUMENTS                                                                               |
|-------|----------|----------|---------------|-----------|------------|---|
| 1     | 80213.09 | 90866.29 | "RW"282+92.83 | 36.38' LT | 8/12/2020  | FD 5/8" IRON ROD WITH YPC, ILLEGIBLE, DOWN 0.1', MOS*1466                                                       |
| 2     | 80008.94 | 90912.72 | "RW"284+90.44 | 31.15' RT | 8/12/2020  | FD 3" BRASS DISK IN CONCRETE MARKED AS SHOWN, FLUSH, OSHD FIELD BOOK NO. 837                                    |
| 1010  | 80770.68 | 90445.90 | "RW"276+00.01 | 54.92' RT | 6/17/2020  | FD 5/8" IRON ROD WITH YPC MARKED "PLS 848", FLUSH, POST/PADDLE MARKED "SHRW 276+00 55' RT", MOS*1466            |
| 1011  | 80716.83 | 90468.41 | "RW"276+58.49 | 62.02' RT | 6/17/2020  | FD 5/8" IRON ROD WITH YPC MARKED "PLS 848", FLUSH, POST/PADDLE MARKED "SHRW 276+58.52 62.23' RT", MOS*1466      |
| 1012  | 80617.71 | 90509.57 | "RW"277+65.03 | 74.98' RT | 6/17/2020  | FD 5/8" IRON ROD WITH YPC MARKED "PLS 848", DOWN 0.1', POST/PADDLE MARKED "SHRW 277+65 75' RT", MOS*1466        |
| 1013  | 80514.75 | 90601.94 | "RW"279+00.13 | 45.28' RT | 6/17/2020  | FD 5/8" IRON ROD WITH YPC MARKED "PLS 848", FLUSH, POST/PADDLE MARKED "SHRW 279+00 45.28' RT", MOS*1466         |
| 1014  | 80329.17 | 90821.96 | "RW"281+69.96 | 54.93' LT | 6/17/2020  | FD 5/8" IRON ROD WITH YPC MARKED "PLS 848", FLUSH, POST/PADDLE MARKED "SHRW 281+70 55' LT", MOS*1466            |
| 1015  | 80651.28 | 90639.98 | "RW"278+00.00 | 55.07' LT | 6/17/2020  | FD 5/8" IRON ROD WITH YPC MARKED "PLS 848", UP 0.1', POST/PADDLE MARKED "SHRW 278+00 55' LT", MOS*1466          |
| 1016  | 80775.82 | 90572.87 | "RW"276+58.56 | 57.95' LT | 6/17/2020  | FD 5/8" IRON ROD WITH YPC MARKED "PLS 848", UP 0.2', POST/PADDLE MARKED "SHRW 276+58.52 57.83' LT", MOS*1466    |
| 1019  | 80154.00 | 90900.08 | "RW"283+61.39 | 36.40' LT | 6/18/2020  | FD 5/8" IRON ROD WITH 2" ALUMINUM CAP MARKED "SHRW 283+61.60 36.44' LT 2003 PLS 848", UP 0.3', MOS*1658         |
| 1020  | 80085.96 | 90941.47 | "RW"284+42.92 | 36.05' LT | 6/18/2020  | FD 5/8" IRON ROD WITH 2" ALUMINUM CAP MARKED "SHRW 284+42.93 36.17' LT 2003 PLS 848", DOWN 0.3', BENT, MOS*1658 |
| 1021  | 80079.88 | 90945.46 | "RW"284+50.42 | 36.03' LT | 6/18/2020  | FD 5/8" IRON ROD WITH 2" ALUMINUM CAP MARKED "SHRW 284+50.42 36.14' LT 2003 PLS 848", FLUSH, MOS*1658           |
| 1022  | 80058.20 | 90960.47 | "RW"284+77.57 | 36.24' LT | 6/18/2020  | FD 5/8" IRON ROD WITH 1-1/2" ALUMINUM CAP MARKED "SHRW 284+77.56 36.31' LT LS 848", UP 0.1', MOS*1658           |
| 1023  | 80052.47 | 90952.17 | "RW"284+77.53 | 26.16' LT | 6/18/2020  | FD 5/8" IRON ROD WITH 1-1/2" ALUMINUM CAP MARKED "SHRW 284+77.51 26.31' LT LS 848", DOWN 0.2', MOS*1658         |
| 1024  | 80035.48 | 90878.83 | "RW"284+50.51 | 44.04' RT | 6/18/2020  | FD 5/8" IRON ROD WITH 2" ALUMINUM CAP MARKED "SHRW 284+50.42 43.80' LT 2003 PLS 848", FLUSH, MOS*1658           |
| 1025  | 80003.90 | 90893.65 | "RW"284+83.75 | 49.64' RT | 6/18/2020  | FD 5/8" IRON ROD WITH 1-1/2" ALUMINUM CAP MARKED "SHRW 284+83.66 49.56' RT LS 848", UP 0.3', MOS*1466           |
| 1026  | 80005.55 | 90897.40 | "RW"284+84.53 | 45.62' RT | 6/18/2020  | FD 5/8" IRON ROD WITH 1-1/2" ALUMINUM CAP MARKED "SHRW 284+84.08 45.09' RT LS 848", UP 1.3', MOS*1466           |
| 1027  | 79909.00 | 90981.00 | "RW"286+10.23 | 36.22' RT | 6/18/2020  | FD BRIDGE NAIL, ORIGIN UNKNOWN                                                                                  |
| 1028  | 79895.35 | 90996.50 | "RW"286+30.48 | 32.16' RT | 6/18/2020  | FD 5/8" IRON ROD WITH 2" ALUMINUM CAP MARKED "SHRW 286+30.41 32.01' RT 2003 PLS 848", DOWN 0.2', MOS*1658       |
| 1029  | 79955.35 | 91025.43 | "RW"286+00.36 | 27.22' LT | 6/18/2020  | FD 5/8" IRON ROD WITH 1-1/2" ALUMINUM CAP MARKED "SHRW 286+00.42 27.44' LT LS 848", UP 0.2', MOS*1466           |
| 1030  | 79954.85 | 91025.00 | "RW"286+00.49 | 26.58' LT | 6/18/2020  | FD 5/8" IRON ROD WITH 2" ALUMINUM CAP MARKED "SHRW 286+00.42 26.71' LT 2003 PLS 848", UP 0.2', MOS*1658         |
| 1031  | 79941.96 | 91036.70 | "RW"286+17.84 | 28.05' LT | 6/18/2020  | FD 5/8" IRON ROD WITH 1-1/2" ALUMINUM CAP MARKED "SHRW 286+17.82 28.22' LT LS 848", DOWN 0.2', MOS*1466         |
| 1032  | 79937.93 | 91039.13 | "RW"286+22.52 | 27.54' LT | 6/18/2020  | FD 5/8" IRON ROD WITH 2" ALUMINUM CAP MARKED "SHRW 286+22.59 27.66' LT 2003 PLS 848", FLUSH, MOS*1658           |
| 1033  | 79934.43 | 91042.14 | "RW"286+27.13 | 27.81' LT | 6/18/2020  | FD 5/8" IRON ROD WITH 2" ALUMINUM CAP MARKED "SHRW 286+27.15 27.90' LT 2003 PLS 848", FLUSH, MOS*1658           |
| 1034  | 79868.47 | 91018.94 | "RW"286+65.71 | 30.56' RT | 6/18/2020  | FD 5/8" IRON ROD WITH YPC MARKED "BENCHMARK SURVEYING", FLUSH, MOS*2165                                         |
| 1036  | 79896.95 | 90986.95 | "RW"286+23.43 | 38.80' RT | 6/18/2020  | FD 5/8" IRON ROD WITH 1-1/2" ALUMINUM CAP, ILLEGIBLE, BENT, SPUN FOR POSITION, FLUSH, MOS*1466                  |
| 1040  | 79901.33 | 90991.42 | "RW"286+22.65 | 32.59' RT | 7/29/2020  | FD 5/8" IRON ROD WITH 2" ALUMINUM CAP MARKED "SHRW 286+22.59 32.41' RT 2003 PLS 848", DOWN 0.2, MOS*1658        |
| 1055  | 79824.99 | 90865.86 | N/A           | N/A       | 7/29/2020  | FD 3" ALUMINUM CAP ON 2-1/2" GALVANIZED IRON PIPE MARKED AS SHOWN, UP 0.4', MOS*1658                            |
| 1064  | 80040.15 | 90957.08 | "RW"284+90.65 | 23.08' LT | 10/15/2020 | FD 2-1/2" BRASS DISK MARKED AS SHOWN, IN 10" CONCRETE CYLINDER, DOWN 0.1', OSHD FIELD BOOK NO. 837              |
| 1065  | 80051.88 | 90964.34 | "RW"284+85.16 | 35.79' LT | 10/15/2020 | FD 5/8" IRON ROD, NO CAP, BENT, SPUN FOR POSITION, UP 0.1', MOS*1658                                            |
| 1066  | 80046.05 | 90956.05 | "RW"284+85.15 | 25.65' LT | 10/15/2020 | FD 5/8" IRON ROD WITH 2" ALUMINUM CAP MARKED "SHRW 284+84.91 25.90' LT, 2003 PLS 848", FLUSH, MOS*1658          |
| 1067  | 80173.66 | 90796.84 | "RW"282+92.97 | 43.49' RT | 10/15/2020 | FD 5/8" IRON ROD WITH YPC, ILLEGIBLE, FLUSH, MOS*1466                                                           |
| 1086  | 79918.20 | 90977.44 | "RW"286+00.76 | 33.47' RT | 11/02/2020 | FD 5/8" IRON ROD, NO CAP, DOWN 0.1', MOS*1658                                                                   |
| 1087  | 80011.80 | 90906.65 | "RW"284+84.74 | 34.46' RT | 11/02/2020 | FD 5/8" IRON ROD, NO CAP, BENT, STRAIGHTENED, FLUSH, MOS*1658                                                   |
| 1091  | 80114.06 | 90830.57 | "RW"283+60.87 | 43.77' RT | 11/03/2020 | FD 5/8" IRON ROD WITH 2" ALUMINUM CAP MARKED "SHRW 283+60.87 43.56' RT 2003 PLS 848", UP 0.1', MOS*1658         |
| 1096  | 80146.29 | 90702.26 | N/A           | N/A       | 11/19/2020 | FD 5/8" IRON ROD, NO CAP, UP 0.1', MOS*512                                                                      |
| 2001  | 80021.07 | 90929.99 | "RW"284+90.54 | 10.04' RT | N/A        | CALCULATED POINT, NOTHING FOUND OR SET, CALCULATED FROM COORD. SHOWN ON ODOT DRAWING 10B-3-24. SEE NARRATIVE    |
| 3000  | 80041.92 | 90874.70 | "RW"284+43.15 | 43.93' RT | 10/15/2020 | FD 5/8" IRON ROD WITH 2" ALUMINUM CAP MARKED SHRW 284+42.93 43.83' RT 2003 PLS 848", FLUSH, MOS*1658            |

FD = FOUND MON. = MONUMENT MOS# = MAP OF SURVEY NO. YPC = YELLOW PLASTIC CAP

SCALE: 1"=50'  
50 25 0 50  
FEET

REGISTERED PROFESSIONAL LAND SURVEYOR

OREGON  
JAN. 14, 2003  
BRET N. ELITHORP  
63148


EXPIRES: 12-31-2021

LEGEND

- ( ) RECORD DATA PER REFERENCE LIST ON SHEET 1
- △ FOUND MONUMENT USED FOR NETWORK CONTROL
- FOUND MONUMENT
- CALCULATED POINT
- RESOLVED RIGHT OF WAY
- EXISTING RIGHT OF WAY OR PROPERTY LINE
- "O" CENTER LINE = R/W & STATIONING FROM 4B-25-11
- "RW" CENTER LINE = R/W & STATIONING FROM 10B-3-24

OREGON DEPARTMENT OF TRANSPORTATION

HORIZONTAL CONTROL, RECOVERY AND RETRACEMENT MAP  
JOHN DAY HIGHWAY (US26) : FRANKS CREEK RD. TO OLD HWY. RD.  
GRANT COUNTY, OREGON

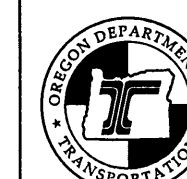

ODOT REGION 5 TECH CENTER  
3012 ISLAND AVENUE  
LA GRANDE, OR 97850  
KEY NO. 21494

OCTOBER 11, 2021  
SCALE: 1"=50'  
SHEET 5 OF 9

MAP OF SURVEY NO. 2166