
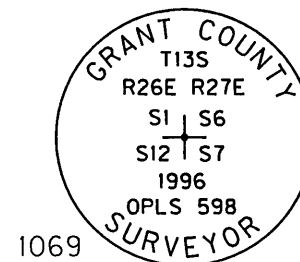


SE 1/4 SECTION 1 T13S R26E WM

RECOVERED MONUMENT LIST

PT ID	NORTHING	EASTING	STATION	OFFSET	DATE	DESCRIPTION & REFERENCE DOCUMENTS
1037	78785.50	91838.05	"F"211+19.91 "RW"300+65.00	65.00' LT 65.31' LT	6/18/2020	FD 5/8" IRON ROD WITH 1-1/2" ALUMINUM CAP, ILLEGIBLE, DOWN 0.2', OSHD DRG. 8B-34-7
1038	78744.43	91652.85	"RW"299+43.02	79.59' RT	6/18/2020	FD 5/8" IRON ROD, NO CAP, DOWN 0.2', MOS*1466
1048	79242.22	91412.01	"RW"294+08.99	32.24' LT	7/29/2020	FD 1-1/2" BRASS CAP MARKED "SHRW 294+08.97 32.34' LT 2003 PLS 848", MOS*1658
1049	79244.10	91415.83	"RW"294+09.07	36.50' LT	7/29/2020	FD 5/8" IRON ROD, NO CAP, BENT SOUTHEAST, UP 0.2', MOS*1658
1050	79022.95	91585.30	"RW"296+95.96	64.52' LT	7/29/2020	FD 5/8" IRON ROD, NO CAP, DOWN 0.2', MOS*1658
1051	79011.66	91597.31	"RW"297+13.23	67.05' LT	7/29/2020	FD 5/8" IRON ROD W/ 2" ALUM. CAP MARKED "SHRW 297+13.23 67.02' LT 2003 PLS 848" DN 0.2', MOS*1658
1052	78896.74	91554.92	"RW"297+74.98	39.20' RT	7/29/2020	FD 5/8" IRON ROD, NO CAP, FLUSH, MOS*1466
1063	79127.56	91480.86	"RW"295+44.98	36.70' RT	8/20/2020	FD 5/8" IRON ROD WITH RPC MARKED "CORNERSTONE SURVEYING INC.", UP 0.2', MOS*1668
1069	77192.05	92254.40	N/A	N/A	10/15/2020	FD 2-1/2" BRASS DISK IN MON. BOX MARKED AS SHOWN, DOWN 1.0', GRANT COUNTY REMON. RECORDS
1075	78798.56	91631.18	"RW"298+93.78	53.37' RT	11/02/2020	FD 5/8" IRON ROD, NO CAP, BENT EAST, STRAIGHTENED, FLUSH, MOS*1658
1076	78883.01	91568.58	"RW"297+93.69	38.21' RT	11/02/2020	FD 5/8" IRON ROD, NO CAP, BENT SOUTH, STRAIGHTENED, FLUSH, MOS*1658
1077	79088.96	91708.07	"L"209+07.55	11.09' LT	11/02/2020	FD 5/8" IRON ROD WITH YPC MARKED "FG&A SURVEY MARKER", DOWN 0.1', MOS*1658
1092	79450.50	91534.05	N/A	N/A	11/03/2020	FD 5/8" IRON ROD, NO CAP, UP 0.1', MOS*1658
1095	79111.02	91697.43	"L"208+97.23	33.30' LT	11/19/2020	FD 5/8" IRON ROD WITH RPC MARKED "CORNERSTONE SURVEYING INC.", DOWN 0.1', MOS*1668
1097	79841.29	92243.69	N/A	N/A	11/19/2020	FD 2-1/2" BRASS DISK MARKED AS SHOWN, GRANT COUNTY REMONUMENTATION RECORDS
1098	79269.17	91621.21	N/A	N/A	11/19/2020	FD 5/8" IRON ROD WITH RPC MARKED "CORNERSTONE SURVEYING INC.", DOWN 0.1', MOS*1668
1099	79268.27	91820.84	N/A	N/A	11/19/2020	FD 5/8" IRON ROD WITH RPC MARKED "CORNERSTONE SURVEYING INC.", DOWN 0.2', MOS*1668

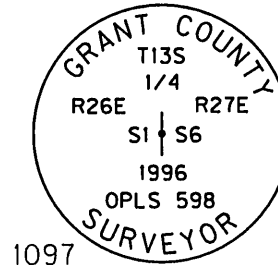

LINE TABLE					
MEASURED			RECORD		
L1	S34°27'12"W	23.30'	(S35°38'W X11)	(23.3' X11)	
L2	S34°27'12"W	21.17'			
L3	S32°35'48"E	100.00'	(S31°25'E X11)	(100' X11)	
L4	S9°33'48"E	24.07'			
L5	S9°33'48"E	31.00'	(S8°23'E X11)	(31' X11)	


LEGEND

- () RECORD DATA PER REFERENCE LIST ON SHEET 1
- ★ SET GPS CONTROL POINT SEE TABLE ON SHEET 2
- FOUND MONUMENT
- RESOLVED RIGHT OF WAY
- EXISTING RIGHT OF WAY OR PROPERTY LINE
- REFERENCE LINE
- EXISTING EASEMENT

"RW" CENTER LINE = R/W & STATIONING FROM 10B-3-24

"F" CENTER LINE = R/W & STATIONING FROM 8B-34-7

"L" CENTER LINE = R/W & STATIONING FROM 4B-25-11 & 4B-26-9

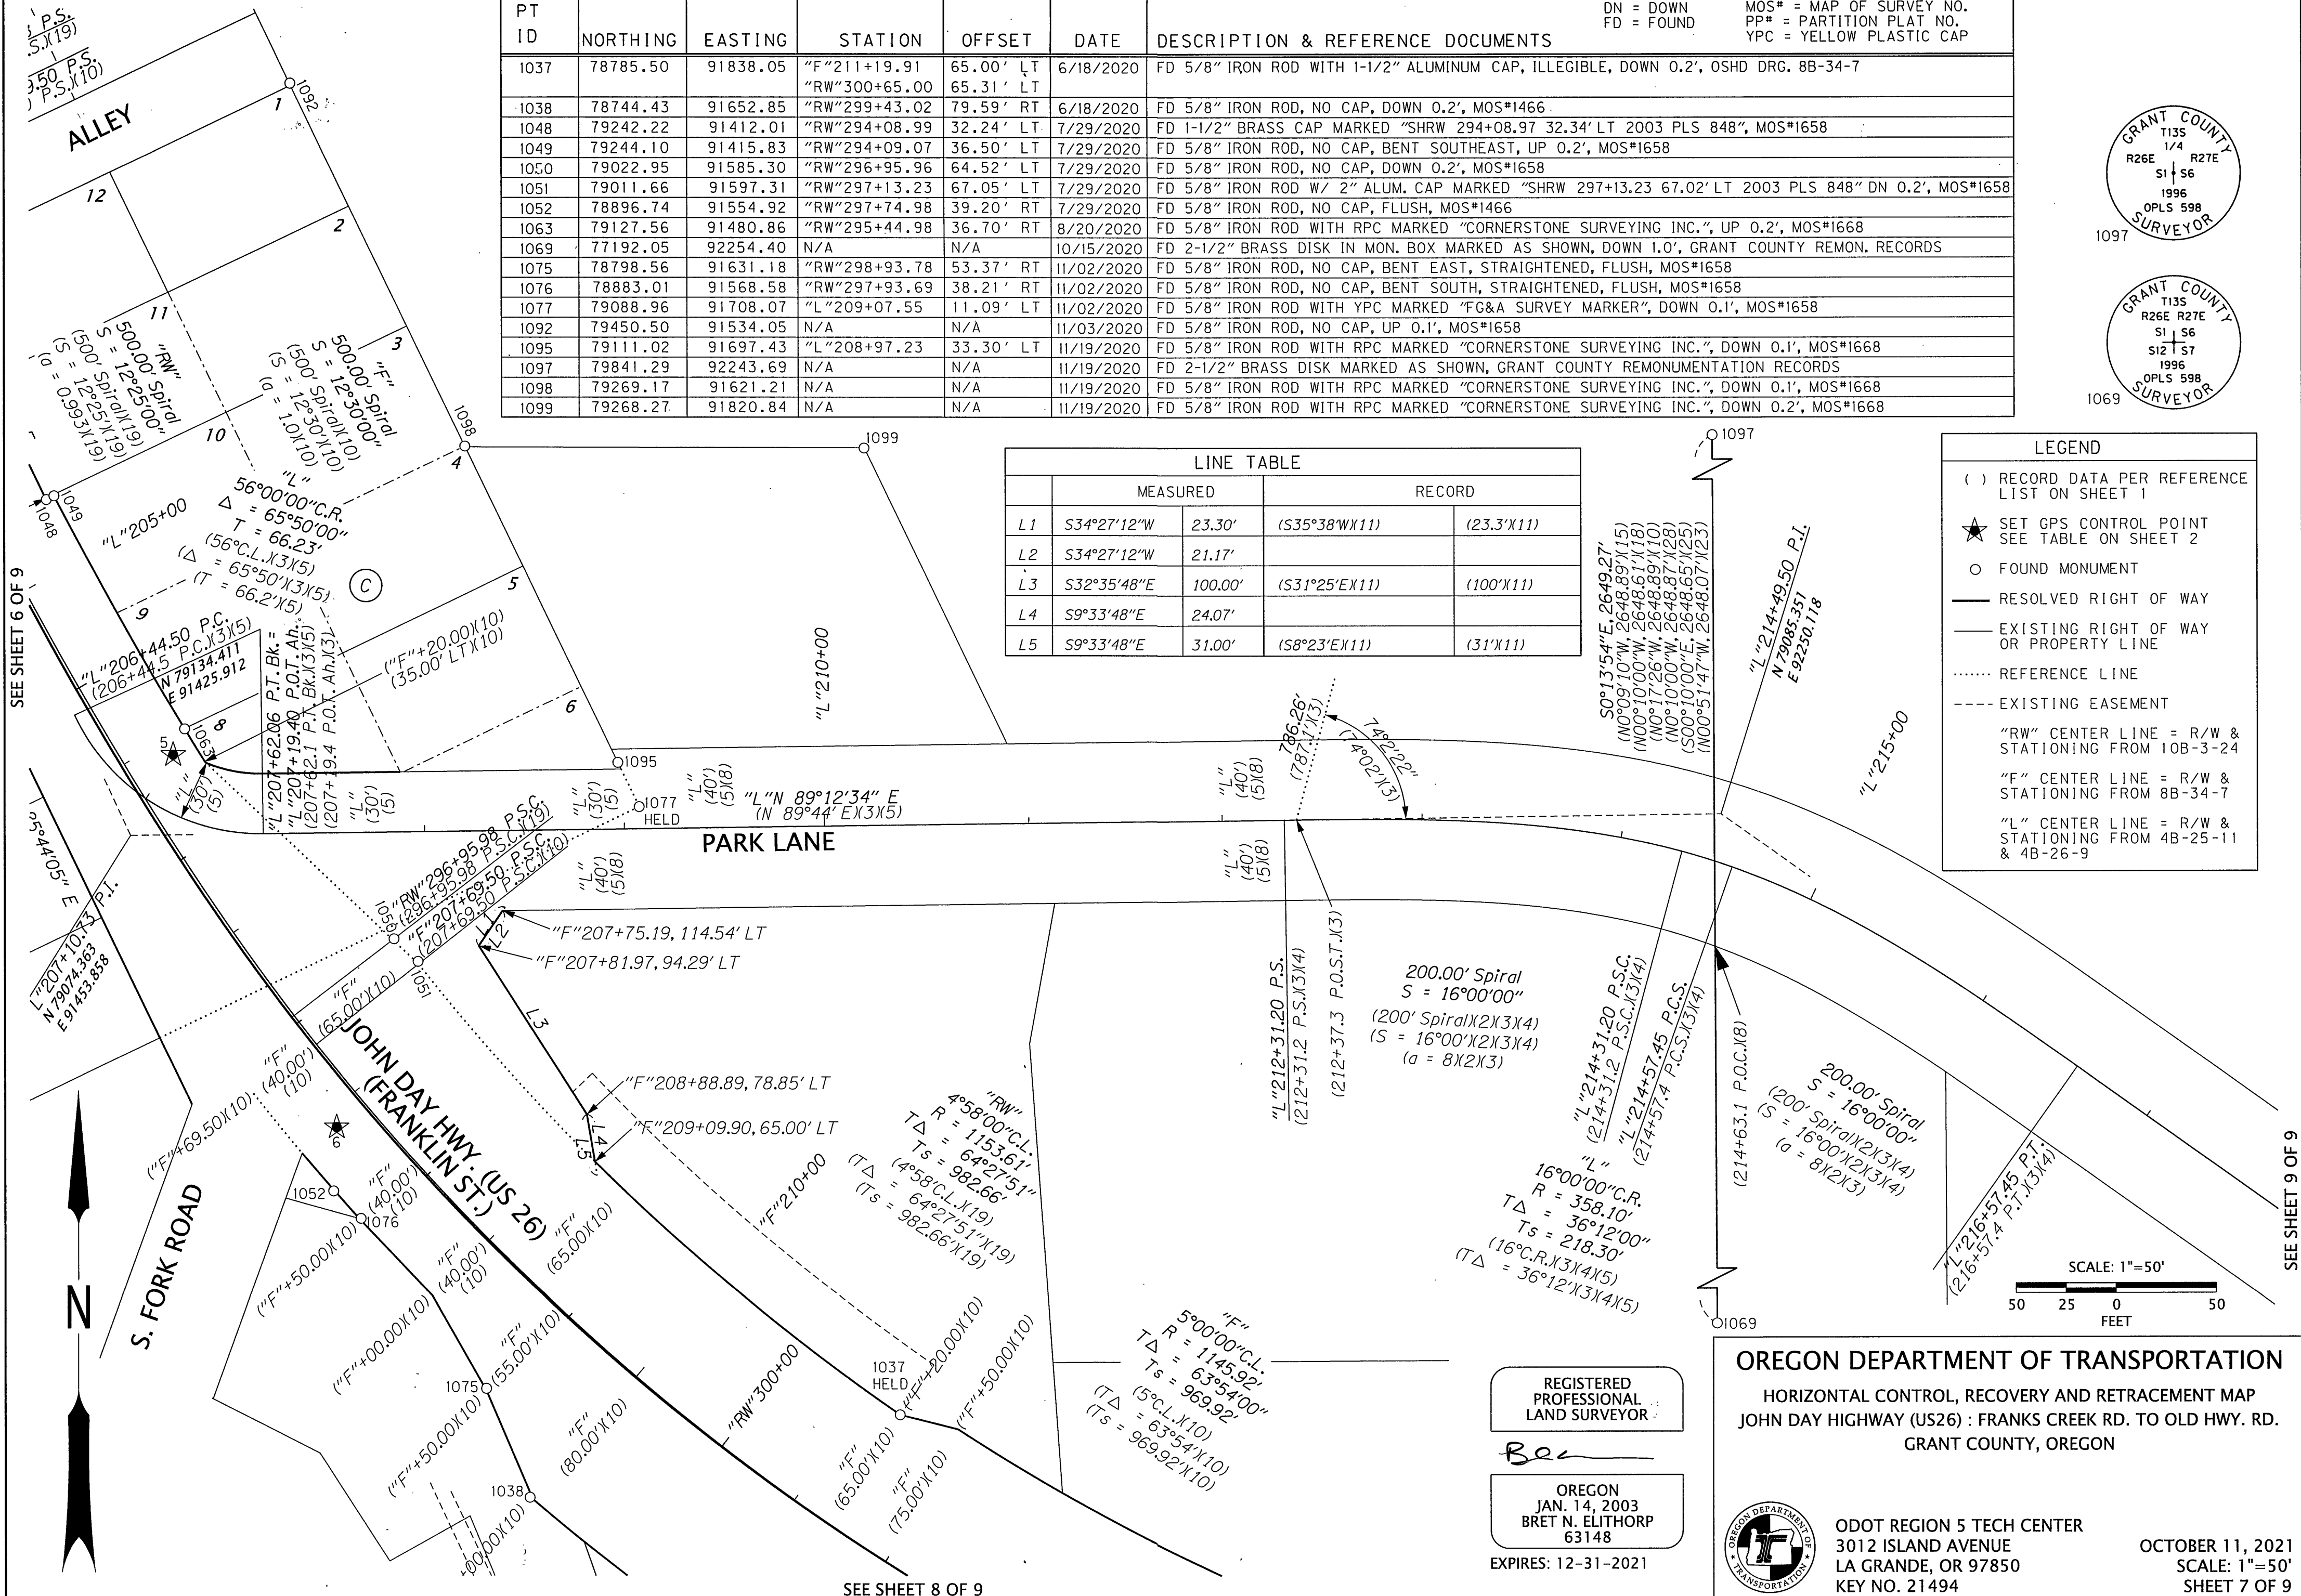

REGISTERED PROFESSIONAL LAND SURVEYOR

Bret N. Elithorp

OREGON
JAN. 14, 2003
BRET N. ELITHORP
63148

EXPIRES: 12-31-2021

OREGON DEPARTMENT OF TRANSPORTATION

HORIZONTAL CONTROL, RECOVERY AND RETRACEMENT MAP
JOHN DAY HIGHWAY (US26) : FRANKS CREEK RD. TO OLD HWY. RD.
GRANT COUNTY, OREGON

ODOT REGION 5 TECH CENTER
3012 ISLAND AVENUE
LA GRANDE, OR 97850
KEY NO. 21494

OCTOBER 11, 2021
SCALE: 1"=50'
SHEET 7 OF 9