
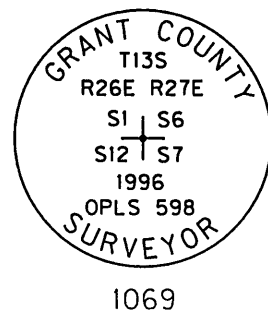


SW 1/4 SECTION 6 T13S R27E WM
SE 1/4 SECTION 1 T13S R26E WM

SEE SHEET 7 OF 9

PARTITION PLAT
2008-04

JOHN DAY HWY. (US 26)
(FRANKLIN ST.)

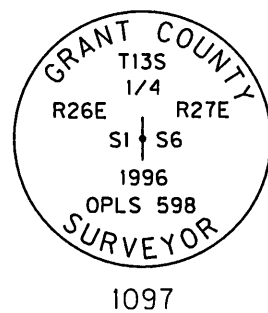

SCALE: 1"=50'
50 25 0 50
FEET

RECOVERED MONUMENT LIST

PT ID	NORTHING	EASTING	STATION	OFFSET	DATE	DESCRIPTION & REFERENCE DOCUMENTS	FD = FOUND MON. = MONUMENT	MOS# = MAP OF SURVEY NO. PP# = PARTITION PLAT NO. YPC = YELLOW PLASTIC CAP
1037	78785.50	91838.05	"F"211+19.91 "RW"300+65.00	65.00' LT 65.31' LT	6/18/2020	FD 5/8" IRON ROD W/ 1-1/2" ALUM. CAP, ILLEGIBLE, DOWN 0.2', OSHD DRG. 8B-34-7		
1038	78744.43	91652.85	"RW"299+43.02	79.59' RT	6/18/2020	FD 5/8" IRON ROD, NO CAP, DOWN 0.2', MOS*1466		
1053	78599.45	92318.58	"RW"306+14.10	59.84' LT	7/29/2020	FD 5/8" IRON ROD, NO CAP, BENT SOUTH, TIED AT BEND, DOWN 0.8', MOS*1426		
1056	78610.35	92253.01	"RW"305+44.62	60.34' LT	7/30/2020	FD 5/8" IRON ROD WITH 2" ALUM. CAP MARKED "SHRW 305+94.44 79.31' RT 2003 PLS 848", DOWN 0.1', MOS*1658		
1057	78612.23	92248.42	"RW"305+39.52	61.34' LT	7/30/2020	FD 5/8" IRON ROD, NO CAP, FLUSH, MOS*1426		
1058	78483.07	92174.53	"RW"304+93.93	80.20' RT	7/30/2020	FD 5/8" IRON ROD WITH YPC MARKED "PLS 848", UP 0.2', POST/PADDLE MARKED "SHRW 304+93.92 80.26' RT" MOS*1466		
1059	78483.66	92174.91	"RW"304+94.16	79.54' RT	7/30/2020	FD 5/8" IRON ROD WITH 2" ALUM. CAP MARKED "SHRW 304+93.92 75.27' LT 2003 PLS 848", FLUSH, MOS*1658		
1060	78484.11	92172.77	"RW"304+92.09	79.58' RT	7/30/2020	FD 5/8" IRON ROD WITH 2" ALUM. CAP MARKED "SHRW 304+92.00 75.77' LT 2003 PLS 484, MOS*1658		
1069	77192.05	92254.40	N/A	N/A	10/15/2020	FD 2-1/2" BRASS DISK IN MON. BOX MARKED AS SHOWN, DOWN 1.0', GRANT COUNTY REMON. RECORDS		
1072	78464.02	92279.66	"RW"305+94.53	79.69' RT	10/29/2020	FD 5/8" IRON ROD, NO CAP, BENT WEST, SHOT AT BEND, FLUSH, MOS*1658		
1073	78633.40	92208.84	"RW"304+93.90	74.00' LT	10/29/2020	FD 5/8" IRON ROD WITH YPC MARKED "PLS 848", DOWN 0.6', MOS*1466		
1074	78635.04	92207.46	"RW"304+92.06	75.28' LT	10/29/2020	FD 5/8" IRON ROD, NO CAP, DOWN 0.6', MOS*1658		
1075	78798.56	91631.18	"RW"298+93.78	53.36' RT	11/02/2020	FD 5/8" IRON ROD, NO CAP, BENT EAST, STRAIGHTENED, FLUSH, MOS*1658		
1097	79841.29	92243.69	N/A	N/A	11/19/2020	FD 2-1/2" BRASS DISK MARKED AS SHOWN, GRANT COUNTY REMONUMENTATION RECORDS		

LEGEND

- () RECORD DATA PER REFERENCE LIST ON SHEET 1
- FOUND MONUMENT
- RESOLVED RIGHT OF WAY
- EXISTING RIGHT OF WAY OR PROPERTY LINE
- EXISTING EASEMENT
- "RW" CENTER LINE = R/W & STATIONING FROM 10B-3-24
- "F" CENTER LINE = R/W & STATIONING FROM 8B-34-7

REGISTERED
PROFESSIONAL
LAND SURVEYOR

Be

OREGON
JAN. 14, 2003
BRET N. ELITHORP
63148

EXPIRES: 12-31-2021

OREGON DEPARTMENT OF TRANSPORTATION

HORIZONTAL CONTROL, RECOVERY AND RETRACEMENT MAP
JOHN DAY HIGHWAY (US26) : FRANKS CREEK RD. TO OLD HWY. RD.
GRANT COUNTY, OREGON



ODOT REGION 5 TECH CENTER
3012 ISLAND AVENUE
LA GRANDE, OR 97850
KEY NO. 21494

OCTOBER 11, 2021
SCALE: 1"=50'
SHEET 8 OF 9

MAP OF SURVEY NO. 2166