

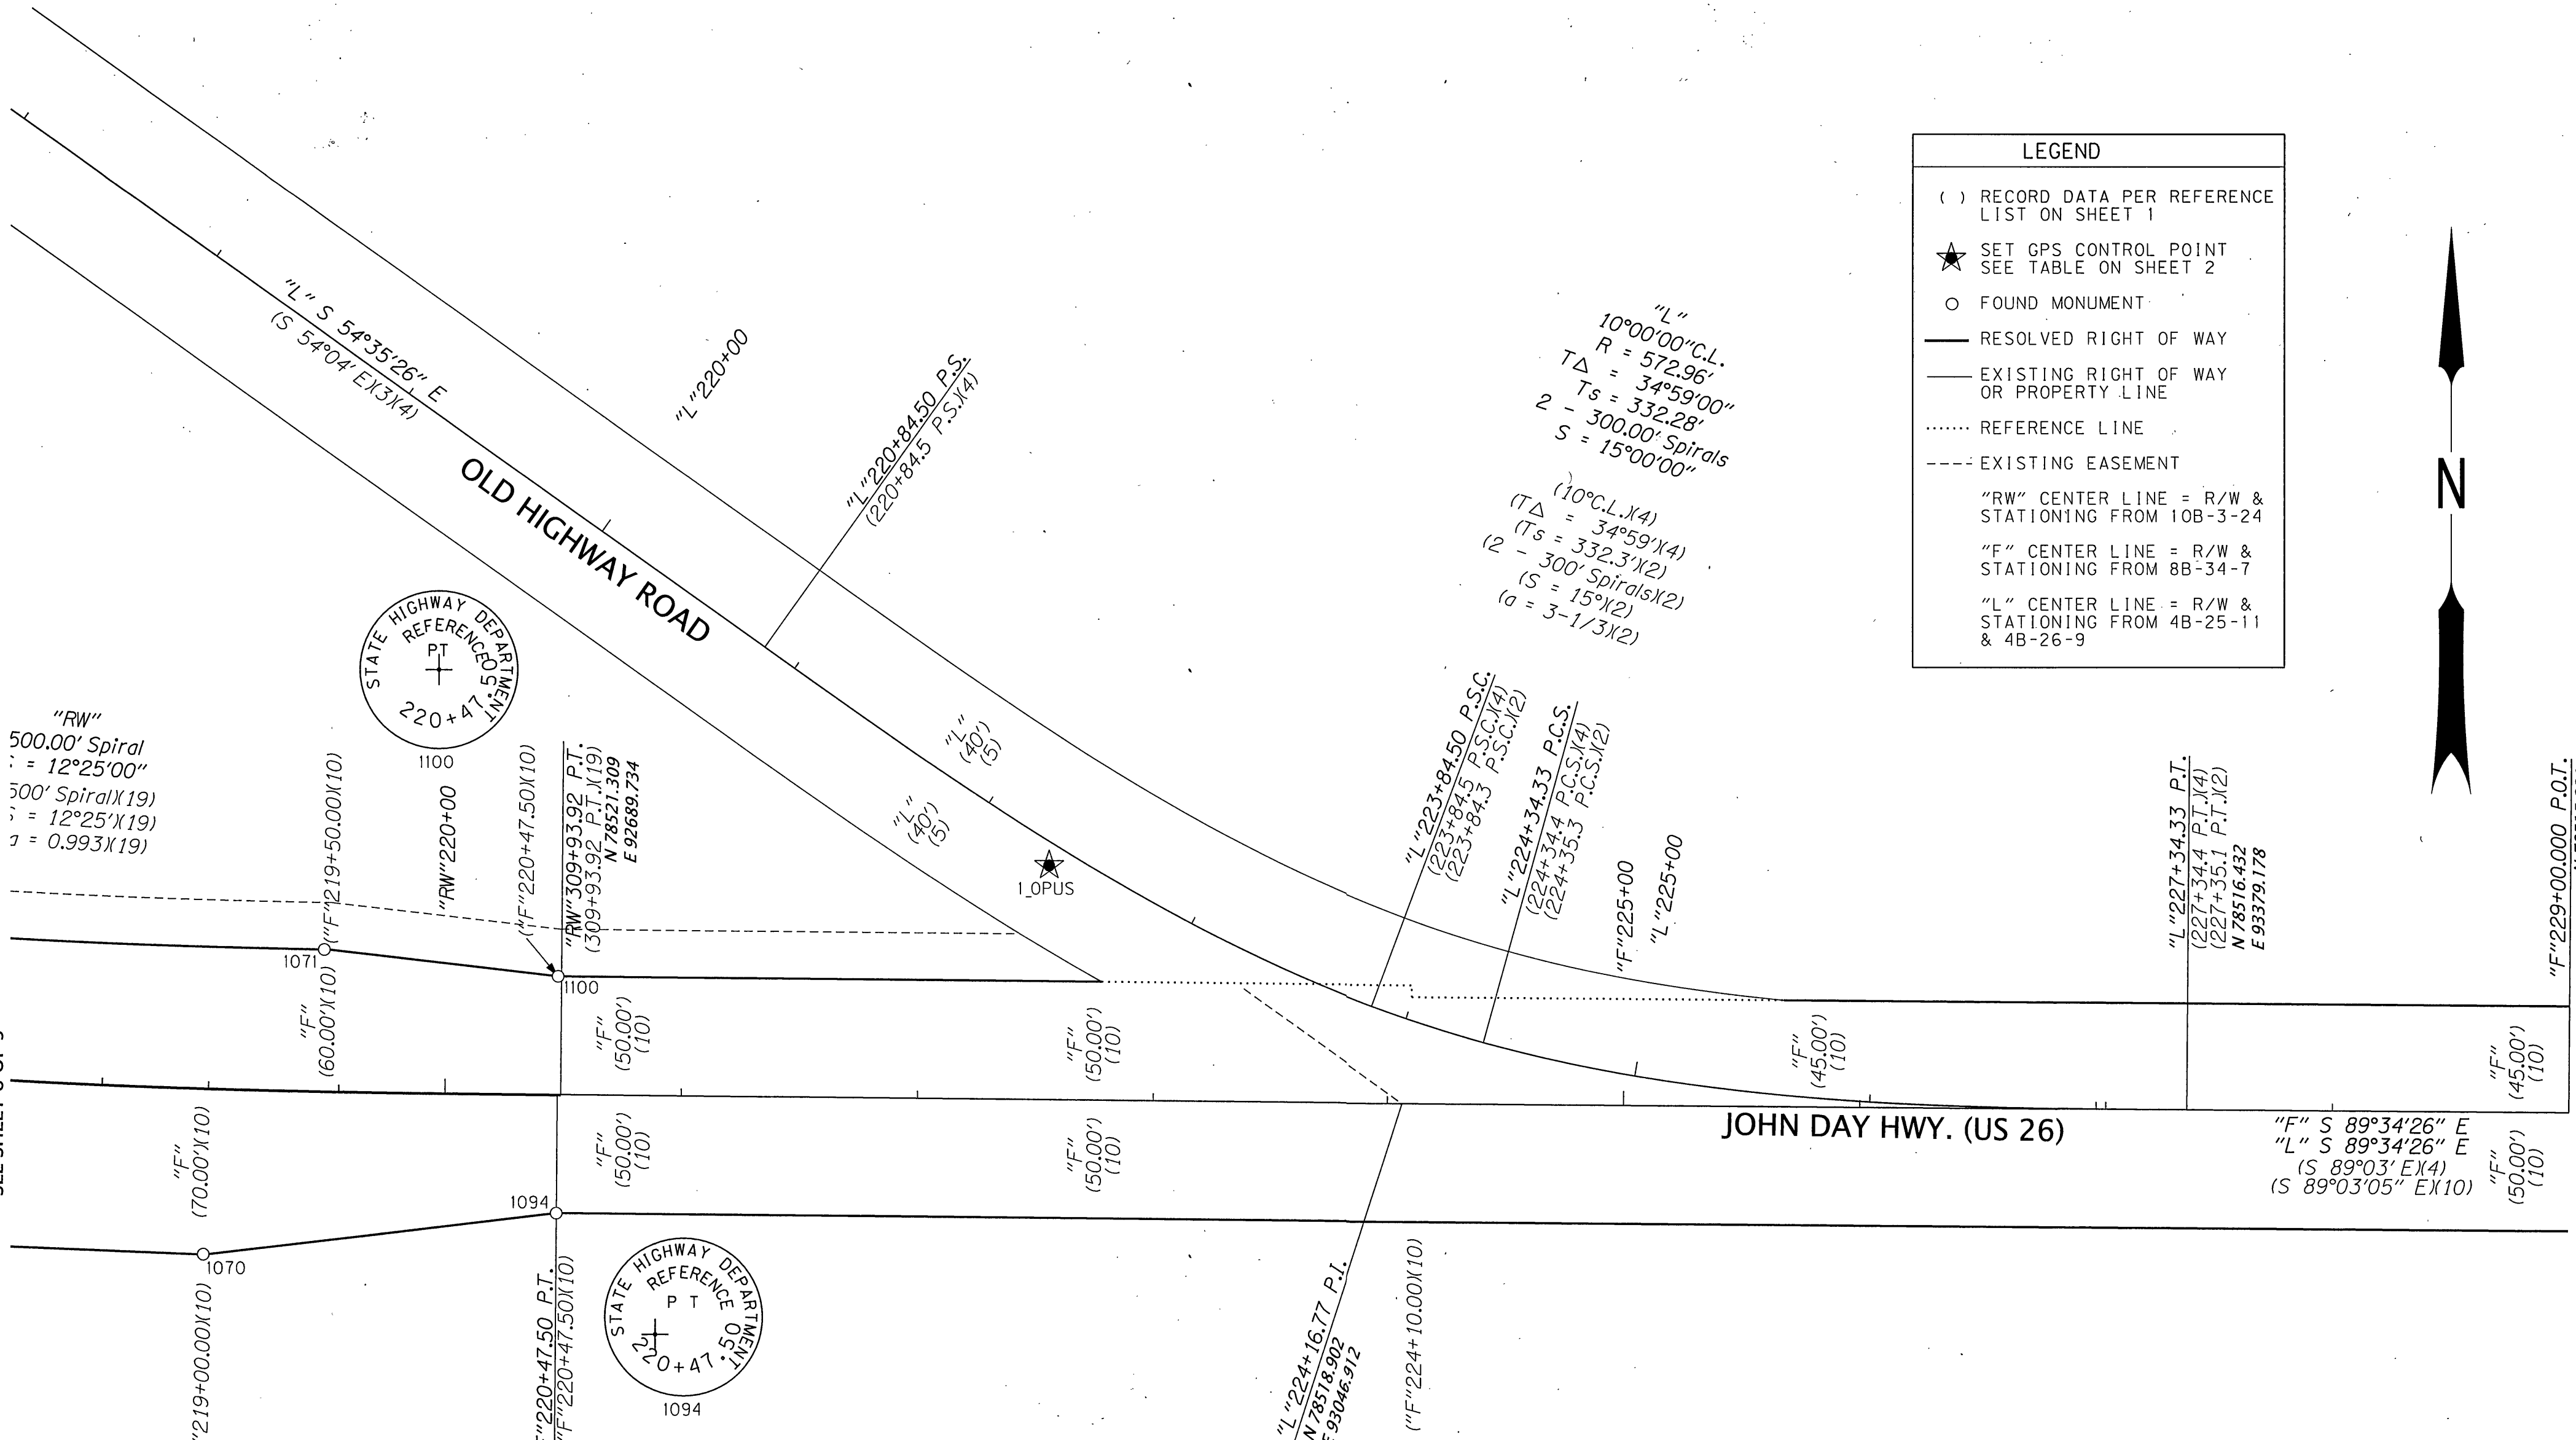


SW 1/4 SECTION 6 T13S R27E WM

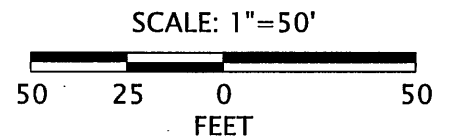

LEGEND

- () RECORD DATA PER REFERENCE LIST ON SHEET 1
- ★ SET GPS CONTROL POINT SEE TABLE ON SHEET 2
- FOUND MONUMENT
- RESOLVED RIGHT OF WAY
- EXISTING RIGHT OF WAY OR PROPERTY LINE
- REFERENCE LINE
- EXISTING EASEMENT
- "RW" CENTER LINE = R/W & STATIONING FROM 10B-3-24
- "F" CENTER LINE = R/W & STATIONING FROM 8B-34-7
- "L" CENTER LINE = R/W & STATIONING FROM 4B-25-11 & 4B-26-9

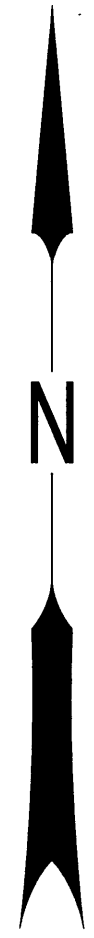

SEE SHEET 8 OF 9

RECOVERED MONUMENT LIST

PT ID	NORTHING	EASTING	STATION	OFFSET	DATE	DESCRIPTION & REFERENCE DOCUMENTS
1070	78453.76	92538.59	"RW"308+44.66	69.72' RT	10/29/2020	FD 5/8" IRON ROD, NO CAP, DOWN 0.2', MOS#1658
1071	78582.62	92589.76	"RW"308+92.93	60.22' LT	10/29/2020	FD 5/8" IRON ROD WITH YPC, ILLEGIBLE, DOWN 0.2', MOS#1658
1094	78471.56	92687.87	"RW"309+92.45	49.76' RT	11/19/2020	FD 2-1/2" BRASS CAP IN CONC. MARKED AS SHOWN, DOWN 0.9', OSHD DRG. 8B-34-7
1100	78571.58	92688.67	"RW"309+92.46	50.26' LT	11/19/2020	FD 2-1/2" BRASS CAP IN CONC. MARKED AS SHOWN, DOWN 0.9', OSHD DRG. 8B-34-7

FD = FOUND MON. = MONUMENT
 MOS# = MAP OF SURVEY NO.
 PP# = PARTITION PLAT NO.
 YPC = YELLOW PLASTIC CAP

REGISTERED PROFESSIONAL LAND SURVEYOR

BEL
 OREGON
 JAN. 14, 2003
 BRET N. ELITHORP
 63148
 EXPIRES: 12-31-2021

OREGON DEPARTMENT OF TRANSPORTATION
 HORIZONTAL CONTROL, RECOVERY AND RETRACEMENT MAP
 JOHN DAY HIGHWAY (US26) : FRANKS CREEK RD. TO OLD HWY. RD.
 GRANT COUNTY, OREGON



ODOT REGION 5 TECH CENTER
 3012 ISLAND AVENUE
 LA GRANDE, OR 97850
 KEY NO. 21494

OCTOBER 11, 2021
 SCALE: 1"=50'
 SHEET 9 OF 9